

Section 8
33S 19W

Section 9
33S 19W

1989' FWL

276' FNL

BHL: 9732'

-99.392655 37.177337

Bottom Perf: 9368'

-99.392582 37.176277

Comanche County

Section 16
33S 19W

Section 17
33S 19W

Top Perf: 6098'
-99.392403 37.167392

Miss Entry: 5374'
-99.392352 37.165433

ROCK 3319 1-16H

ROCK 3319 2-16H

Section 20
33S 19W

Section 21
33S 19W



Actual Bottom-Hole Location of Rock 3119 2-16H
Comanche County, Kansas
T&R: 33S 19W
Section: 16, 1989' FWL & 276' FNL
-99.392655 37.177337

1 in = 624 ft




● Actual BH Location

* SandRidge Wells

--- Perf

□ Sections

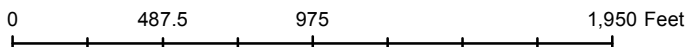

Draftsman:

Aaron Birk

Draft Date: 10/21/2013

Drawing Name/Number:

Addendum_Rock 3119 2-16H.mxd

Coordinate System:

NAD 1927 State Plane
Kansas South FIPS: 1502