


# Section 30, T 25 S, R 10 W., Reno County, Kansas.

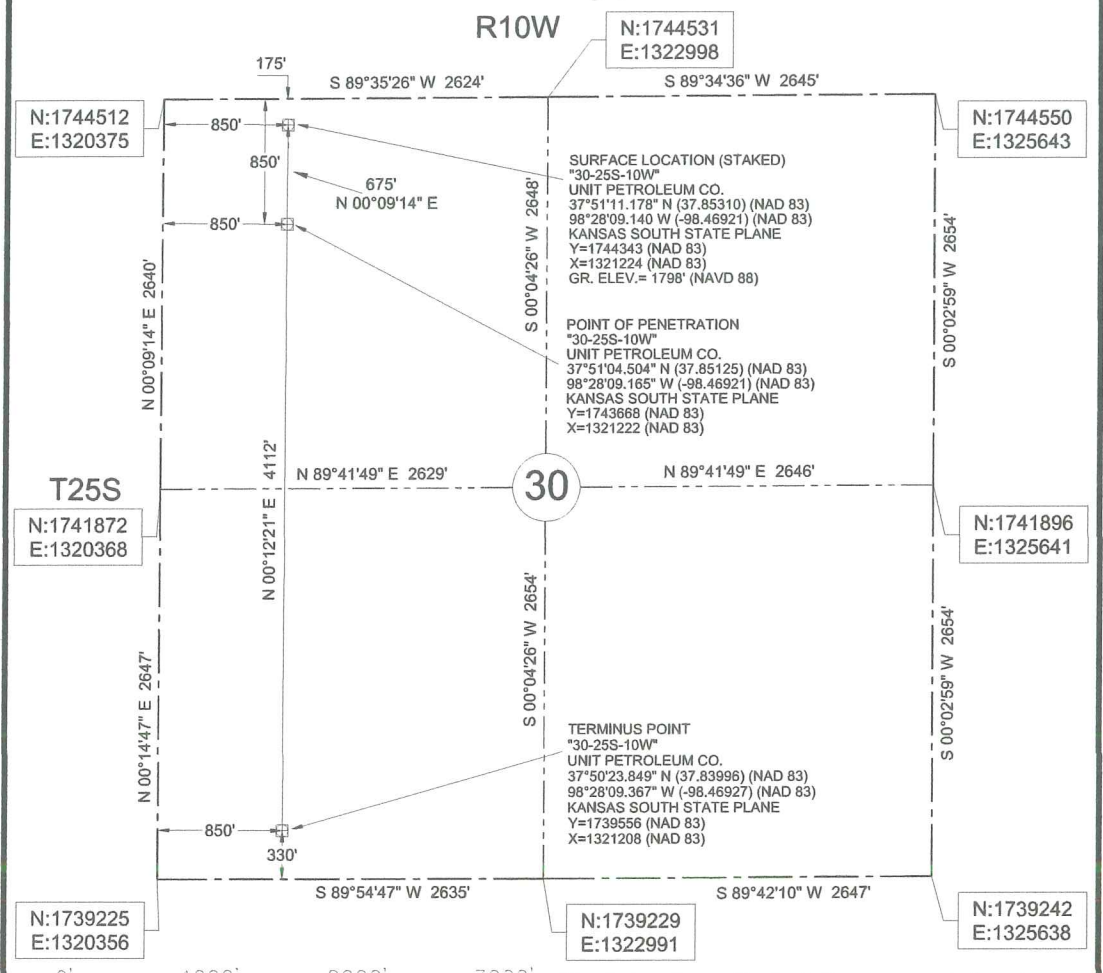

We do hereby certify that this survey was done in accordance to records, maps and other information as provided to us by the client herein named and that great care was taken in the actual staking of this well and the determination of any obstacles thereupon. However, the accuracy of this survey is not guaranteed and if there appears to be any discrepancy, please notify us immediately.

**48 HOURS BEFORE YOU DIG...  
CALL KANSAS ONE-CALL  
1-800-344-7233**

**KANSAS ONE-CALL SYSTEM**

Buried utilities are not necessarily shown. It is the contractor's responsibility to locate and preserve all utility services.

Contractor is responsible for contacting all utility companies prior to construction.

**Description: Surface Hole Location Stake "30-25S-10W"** situated 175 feet from the north section line and 850 feet from the west section line of Section 30, T 25 S, R 10 W., Reno County, Kansas.

**Description: Point of Penetration "30-25S-10W"** situated 850 feet from the south section line and 850 feet from the west section line of Section 30, T 25 S, R 10 W., Reno County, Kansas.

**Description: Terminus Point "30-25S-10W"** situated 330 feet from the south section line and 850 feet from the west section line of Section 30, T 25 S, R 10 W., Reno County, Kansas.

Datum: NAD 83  
Units: US Survey Feet  
North: Grid  
Coordinates: State Plane  
Zone: 1502  
State: Kansas  
Region: South

**LEGEND**  
--- SECTION LINE  
--- 1/4 SECTION LINE

Survey is valid only if print has original seal and signature of surveyor present

<p><b>JVIDENS LAND SURVEY CO., INC.</b> 1210 19TH STREET / P.O. BOX 943 WOODWARD, OKLAHOMA 73802 Phone 580-256-7174 - Fax 580-256-3424 roger@jvidenslandsurvey.com    mike@jvidenslandsurvey.com</p>	<p>Survey For: Unit Petroleum Co. P.O. Box 2726 Woodward, Oklahoma 73802 Attn: Jason Rummery</p>	JOB 456-13	DATE OF PLAT 08-19-2013	SCALE 1"=1000'	SHEET 1 OF 5
		DRAWN BY C.A.N.	OKLA. CA #2064, EXP. 06/30/2015 KANSAS CA #143, EXP. 12/31/2014		

DyeTrust 30 1H