




**Unit Petroleum Company**

Date of Last Revision:  
**11-Feb-14**

**Well:** Dye Trust 30 #1H  
**Location:** 30-25S-10W  
**County, State:** Reno County, KS  
**Surface Location:** 175' FNL & 800' FWL

**API No.:** 1515521671  
**Rig:** Unit Drilling #331  
**Engineer:** Brent Keys (918) 477-4510  
**Geology:** Rob Wilson (928) 477-5728

**OH Size**

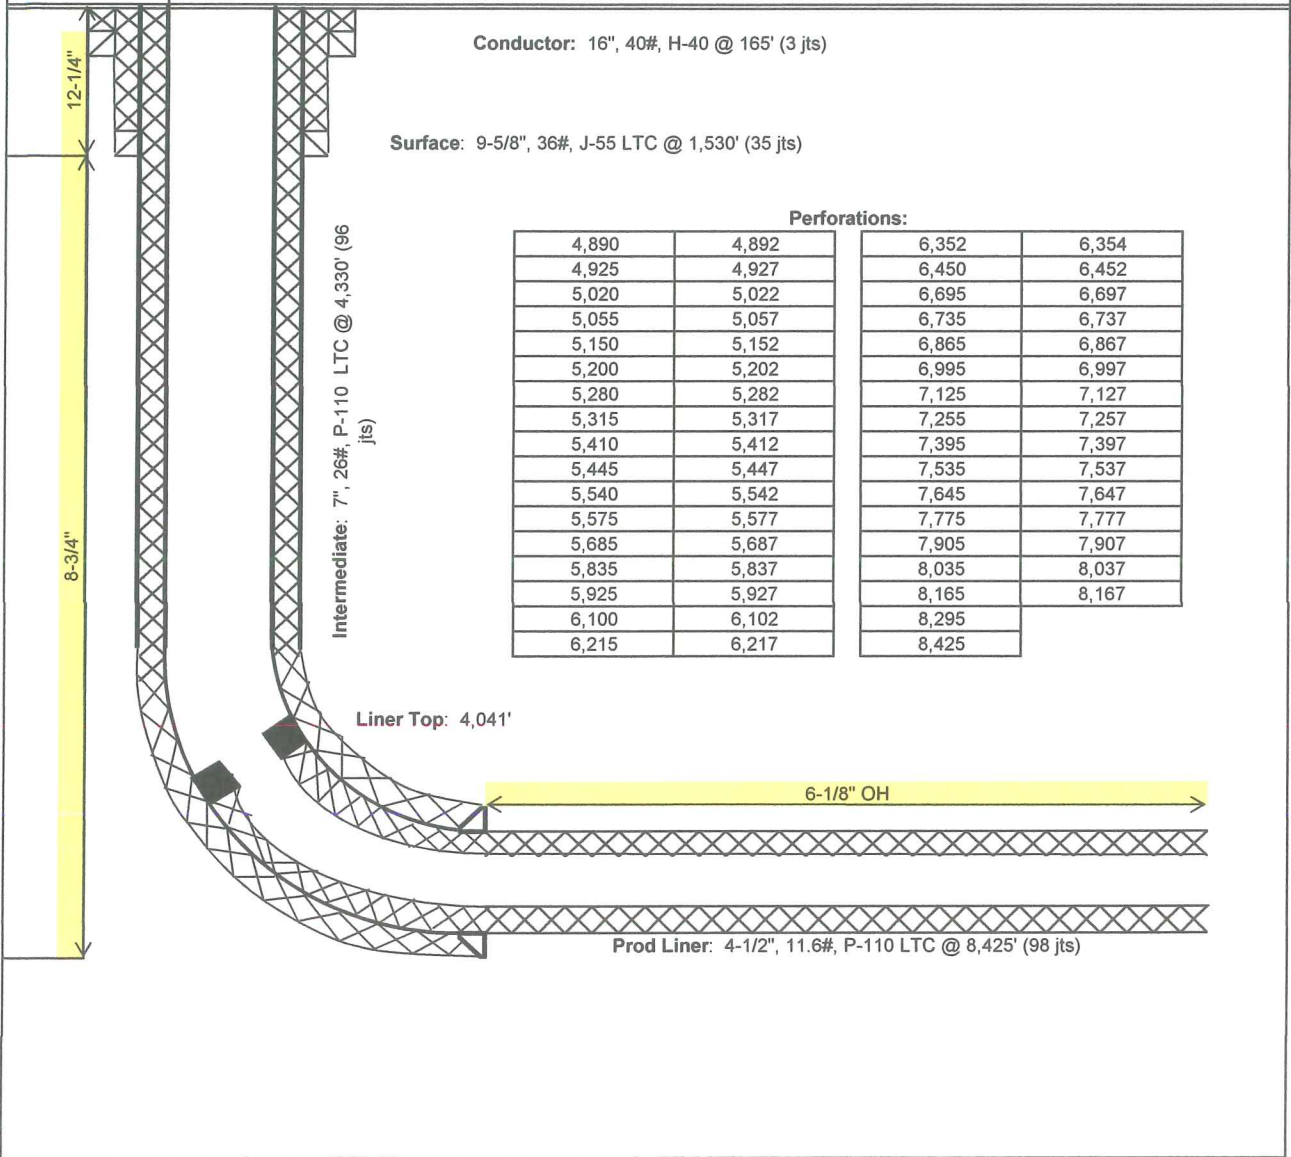

**Perforations:**

4,890	4,892	6,352	6,354
4,925	4,927	6,450	6,452
5,020	5,022	6,695	6,697
5,055	5,057	6,735	6,737
5,150	5,152	6,865	6,867
5,200	5,202	6,995	6,997
5,280	5,282	7,125	7,127
5,315	5,317	7,255	7,257
5,410	5,412	7,395	7,397
5,445	5,447	7,535	7,537
5,540	5,542	7,645	7,647
5,575	5,577	7,775	7,777
5,685	5,687	7,905	7,907
5,835	5,837	8,035	8,037
5,925	5,927	8,165	8,167
6,100	6,102	8,295	
6,215	6,217	8,425	