


Section 25
33S 5W

Section 30
33S 4W

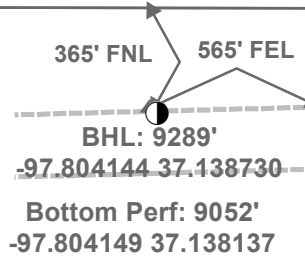

Harper County
Section 36
33S 5W

Sumner County
Section 31
33S 4W




Section 1
34S 5W

Section 6
34S 4W



Actual Bottom-Hole Location of Gabriel 3305 1-36H
Harper County, Kansas
T&R: 33S 5W
Section: 36, 565' FEL & 365' FNL
-97.804004 37.125473

1 in = 667 ft

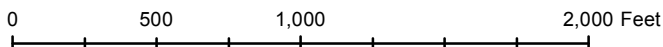

● Actual BH Location

* SandRidge Wells

--- Perf

□ Sections

Draftsman:

Naomi Martinez

Draft Date: 3/4/2014

Drawing Name/Number:

Addendum_Gabriel 3306 1-36H.mxd

Coordinate System:

NAD 1927 State Plane
Kansas South FIPS: 1502