

Section 36  
33S 5W

GABRIEL 3305 1-36H

JOSEPH 3405 1-1H

Section 31  
33S 4W



DIANA SWD 3305 1-36

Top Perf: 4595'  
-97.804243 37.123779



Miss Entry: 4838'  
-97.804205 37.123129

LANA 1-1A



Section 1  
34S 5W

Section 6  
34S 4W

Bottom Perf: 8938'  
-97.80381 37.111945



BHL: 9095'  
-97.803805 37.111687  
429' FSL

506 FEL

Section 12  
34S 5W

Section 7  
34S 4W



Actual Bottom-Hole Location of Joseph 3405 1-1H 1L  
Harper County, Kansas  
T&R: 34S 5W  
Section: 1, 506' FEL & 429' FSL  
-97.803805 37.111687

1 in = 667 ft




● Actual BH Location

\* SandRidge Wells

--- Perf

□ Sections

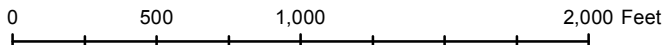

Draftsman:

Aaron Birk

Draft Date: 3/5/2014

Drawing Name/Number:

Addendum\_Joseph 3405 1-1H 1L.mxd

Coordinate System:

NAD 1927 State Plane  
Kansas South FIPS: 1502