


Section 1  
35S 6W

Section 6  
35S 5W

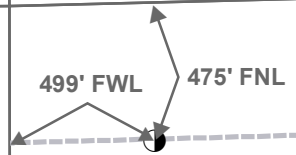

**BHL: 9019'**  
**-97.909608 37.021465**

**Bottom Perf: 8664'**  
**-97.909577 37.02051**

Section 12  
35S 6W

Section 7  
35S 5W  
Harper County

**Top Perf: 5334'**  
**-97.908911 37.011503**

**Miss Entry: 5070'**  
**-97.908743 37.010755**

RAYMOND 3505 1-7H

RAYMOND 3505 2-7H



Section 13  
35S 6W

Section 18  
35S 5W



**Actual Bottom-Hole Location of Raymond 3505 1-7H 1L**  
**Harper County, Kansas**

**T&R: 35S 5W**  
**Section: 7, 499' FWL & 475' FNL**  
**-97.909608 37.021465**

1 in = 667 ft




● Actual BH Location

\* SandRidge Wells

--- Perf

□ Sections

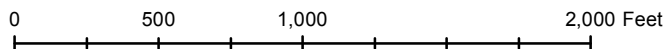

Draftsman:

Aaron Birk

Draft Date: 3/20/2014

Drawing Name/Number:

Addendum\_Raymond 3505 1-7H .mxd

Coordinate System:

NAD 1927 State Plane  
 Kansas South FIPS: 1502