



# Unit Petroleum Company


Date of Last Revision:

3-Mar-14

**Well:** Urban 24 #1H  
**Location:** 13-25S-10E  
**County, State:** Reno County, KS  
**Surface Location:** 175' FSL & 450' FEL

**API No.:** 1515521674  
**Rig:** Unit Drilling #331  
**Engineer:** Brent Keys (918) 477-4510  
**Geology:** Rob Wilson (928) 477-5728

OH Size

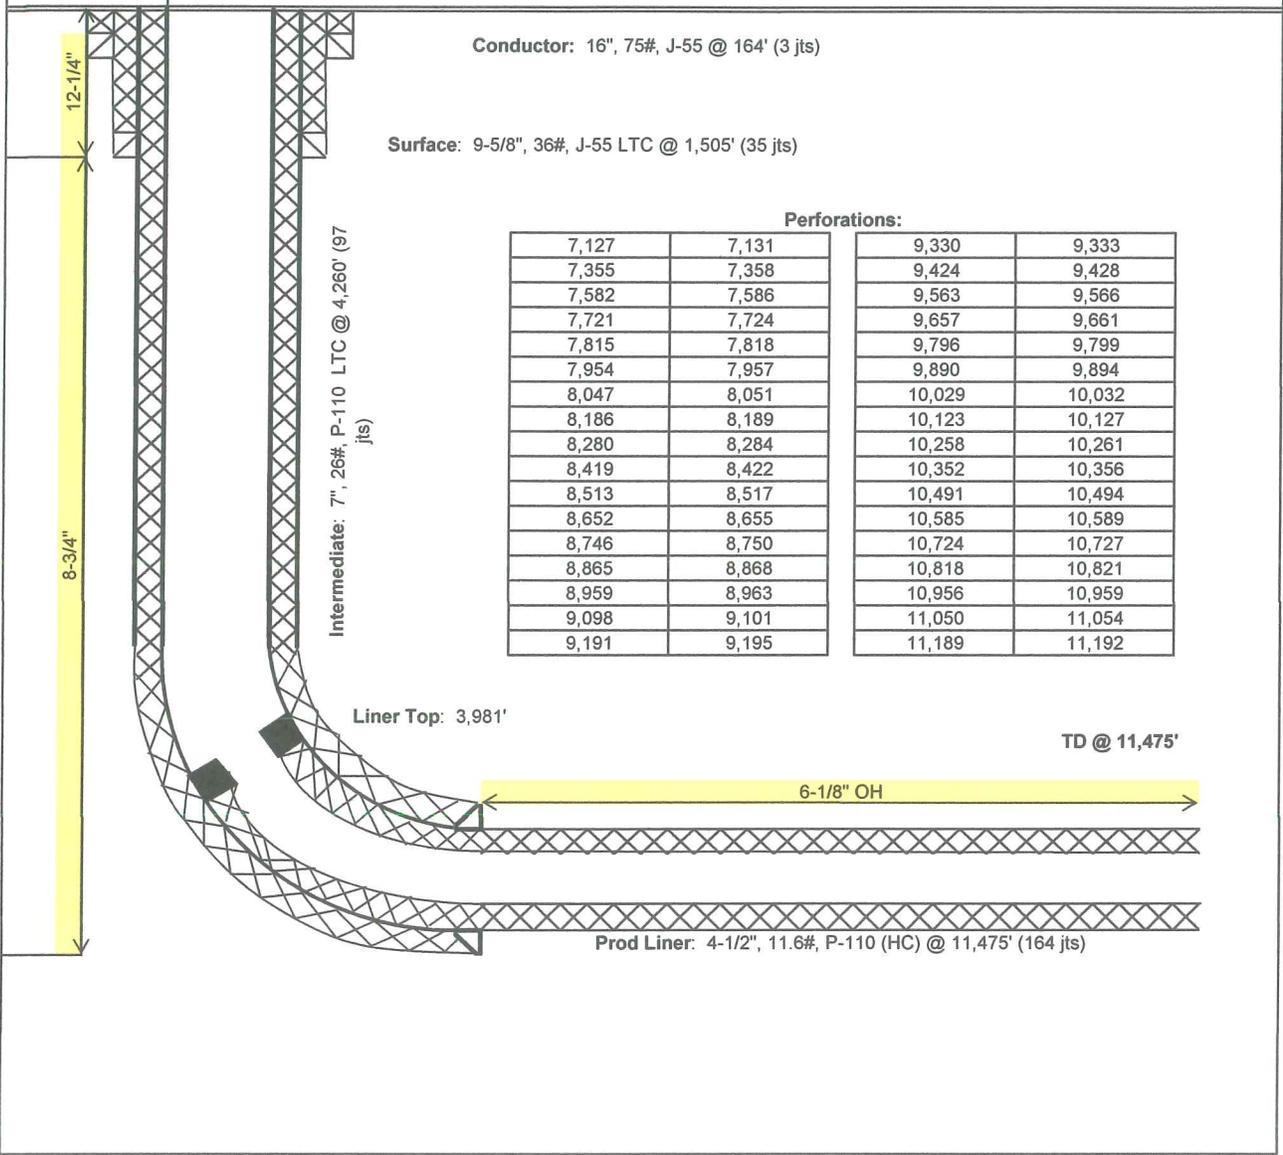

Conductor: 16", 75#, J-55 @ 164' (3 jts)

Surface: 9-5/8", 36#, J-55 LTC @ 1,505' (35 jts)

**Perforations:**

7,127	7,131	9,330	9,333
7,355	7,358	9,424	9,428
7,582	7,586	9,563	9,566
7,721	7,724	9,657	9,661
7,815	7,818	9,796	9,799
7,954	7,957	9,890	9,894
8,047	8,051	10,029	10,032
8,186	8,189	10,123	10,127
8,280	8,284	10,258	10,261
8,419	8,422	10,352	10,356
8,513	8,517	10,491	10,494
8,652	8,655	10,585	10,589
8,746	8,750	10,724	10,727
8,865	8,868	10,818	10,821
8,959	8,963	10,956	10,959
9,098	9,101	11,050	11,054
9,191	9,195	11,189	11,192

Intermediate: 7", 26#, P-110 LTC @ 4,260' (97 jts)

Liner Top: 3,981'

TD @ 11,475'

6-1/8" OH

Prod Liner: 4-1/2", 11.6#, P-110 (HC) @ 11,475' (164 jts)