




Unit Petroleum Company

Date of Last Revision:
27-Mar-14

Well: Black Farms 30 #1H
Location: 30-24S-10W
County, State: Reno County, KS
Surface Location: 175' FNL & 600' FEL

API No.: 1515521676
Rig: Unit Drilling #303
Engineer: Brent Keys (918) 477-4510
Geology: Rob Wilson (928) 477-5728

OH Size

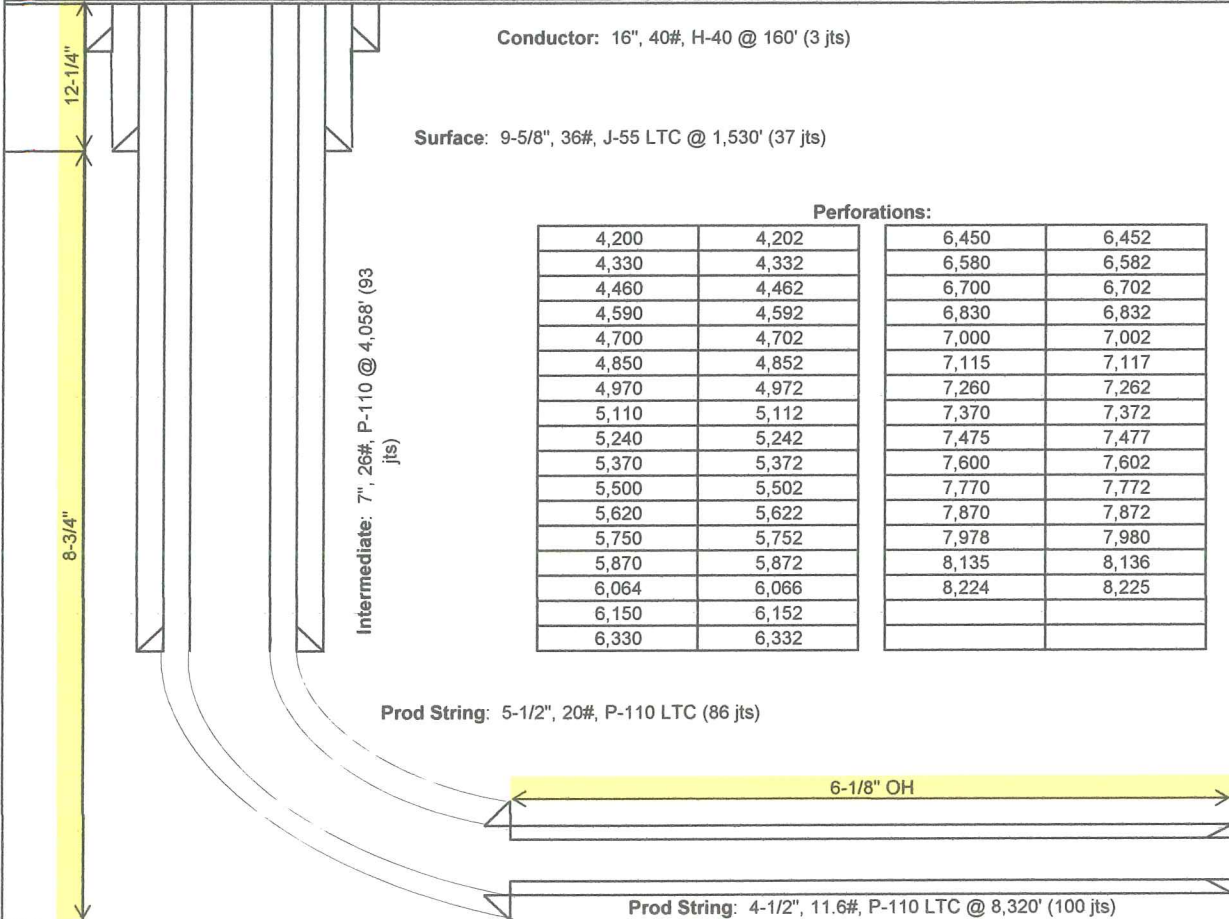

Perforations:

4,200	4,202	6,450	6,452
4,330	4,332	6,580	6,582
4,460	4,462	6,700	6,702
4,590	4,592	6,830	6,832
4,700	4,702	7,000	7,002
4,850	4,852	7,115	7,117
4,970	4,972	7,260	7,262
5,110	5,112	7,370	7,372
5,240	5,242	7,475	7,477
5,370	5,372	7,600	7,602
5,500	5,502	7,770	7,772
5,620	5,622	7,870	7,872
5,750	5,752	7,978	7,980
5,870	5,872	8,135	8,136
6,064	6,066	8,224	8,225
6,150	6,152		
6,330	6,332		