Date of Last Revision:
22-Apr-14

Unit Petroleum Company

Well:	**Hazen Trust 12 #1H**	**API No.:**	1515521678
Location:	12-24S-10W	**Rig:**	Unit Drilling #303
County, State:	Reno County, KS	**Engineer:**	Tom Carrington (918) 477-4535
Surface Location:	2490' FSL & 400' FEL	**Geology:**	Rob Wilson (928) 477-5728

OH Size

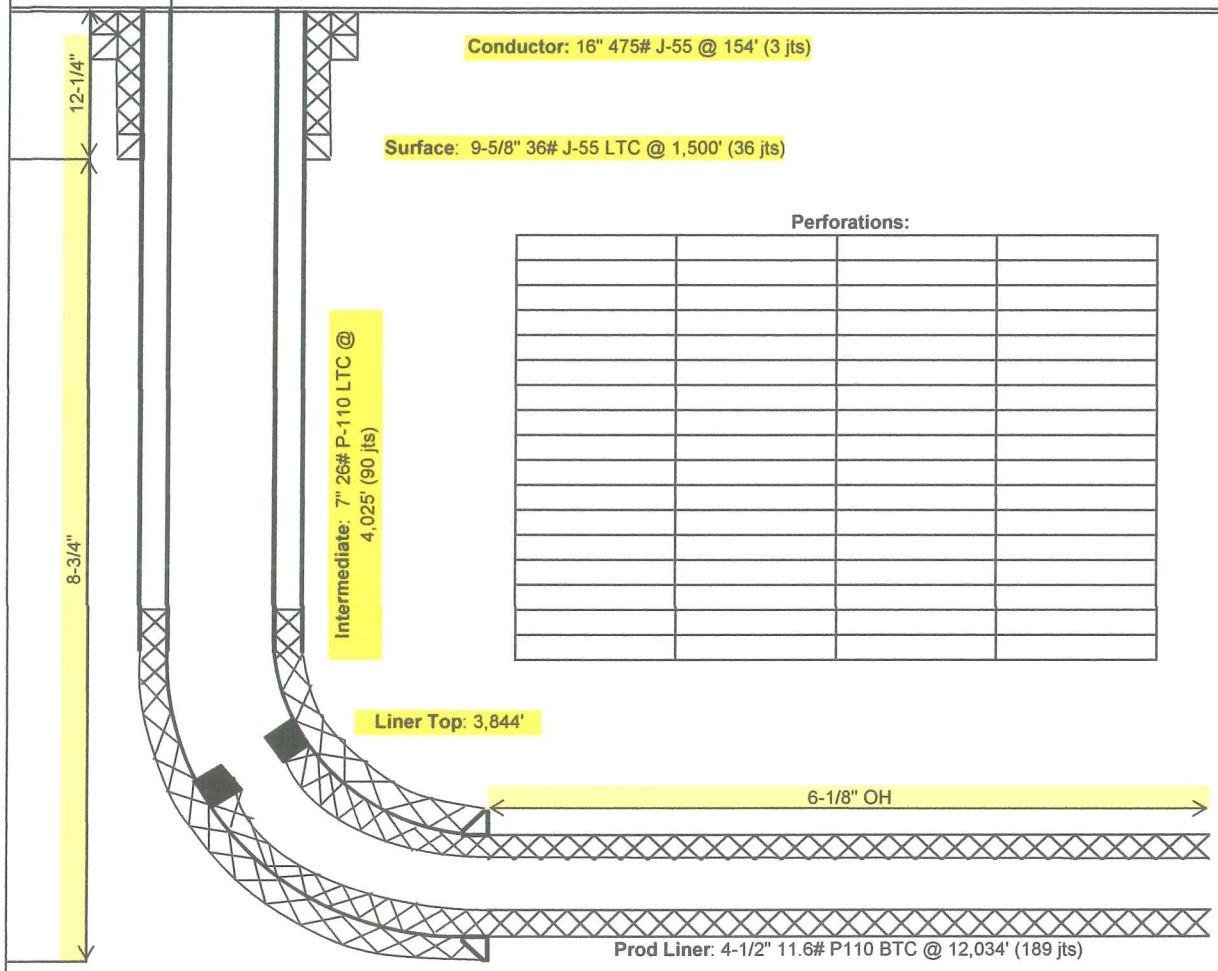

Perforations: