




Unit Petroleum Company

Date of Last Revision:
10-Jul-14

Well: Haw Ranch 29 #2H
Location: 29-25S-10W
County, State: Reno County, KS
Surface Location: 175' FSL and 2260' FEL

API No.: 1515521687
Rig: Unit Drilling #331
Engineer: Tom Carrington (918) 477-4535
Geology: Rob Wilson (918) 477-5728

OH Size

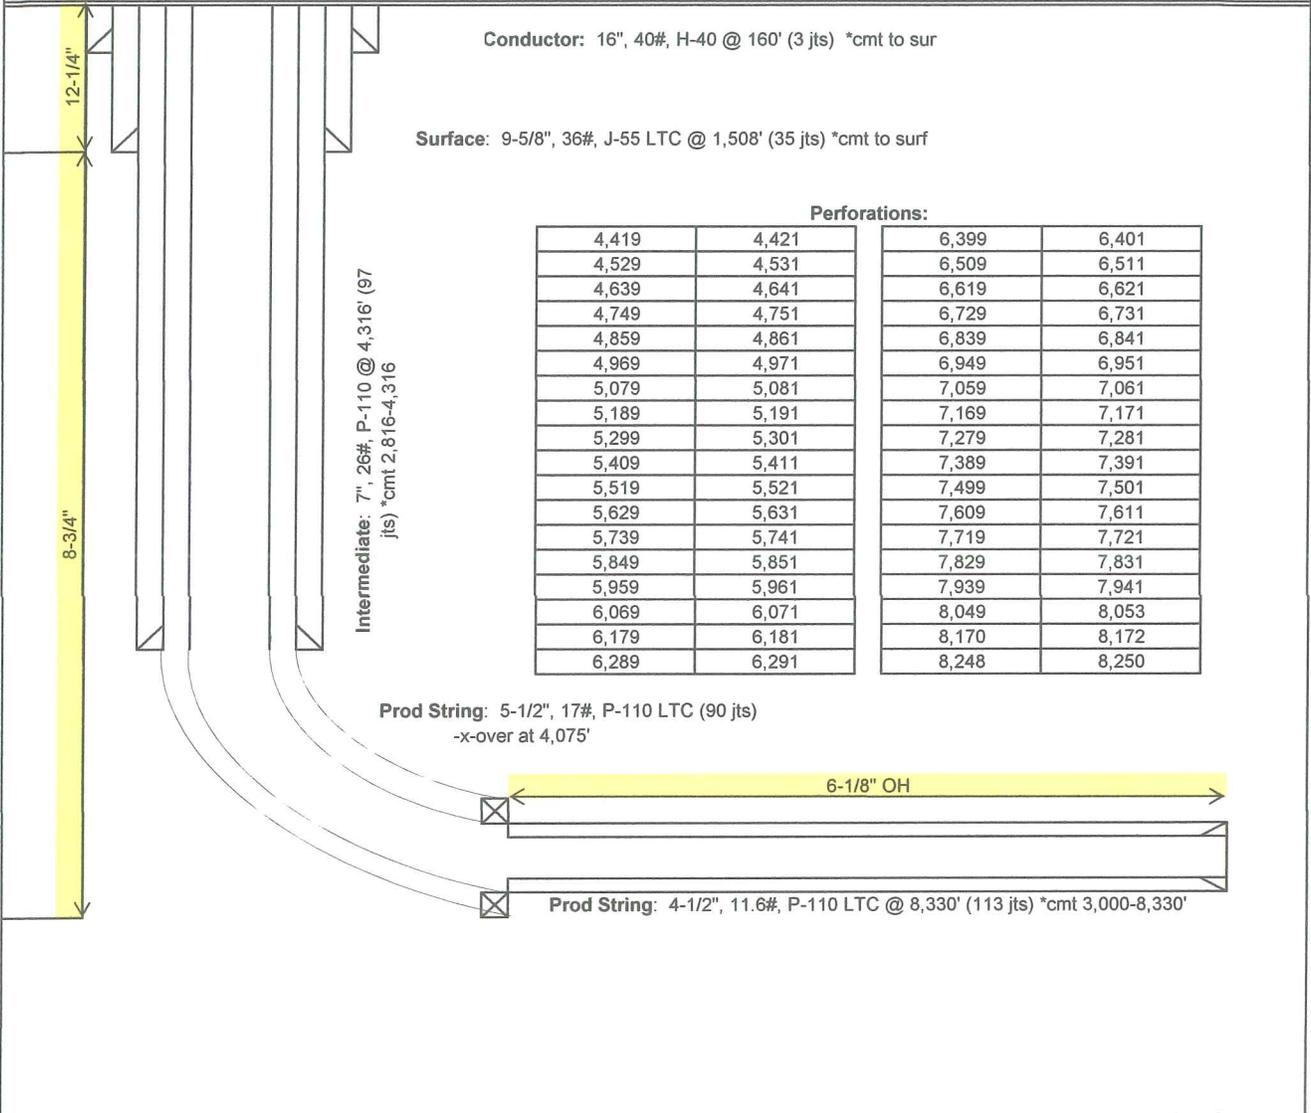

Perforations:

4,419	4,421	6,399	6,401
4,529	4,531	6,509	6,511
4,639	4,641	6,619	6,621
4,749	4,751	6,729	6,731
4,859	4,861	6,839	6,841
4,969	4,971	6,949	6,951
5,079	5,081	7,059	7,061
5,189	5,191	7,169	7,171
5,299	5,301	7,279	7,281
5,409	5,411	7,389	7,391
5,519	5,521	7,499	7,501
5,629	5,631	7,609	7,611
5,739	5,741	7,719	7,721
5,849	5,851	7,829	7,831
5,959	5,961	7,939	7,941
6,069	6,071	8,049	8,053
6,179	6,181	8,170	8,172
6,289	6,291	8,248	8,250