

Section 7  
34S 4W

MURPHY SWD 3404 1-18

JANET 3404 1-7H



SUBERA 3404 2-18H

Miss Entry: 4642'  
-97.787312 37.094613

Top Perf: 4798'  
-97.787292 37.094206

Section 18  
34S 4W

Sumner County

Bottom Perf: 8885'  
-97.787087 37.083134

BHL: 9001'  
-97.787068 37.082787

330' FSL

1050' FEL

Section 19  
34S 4W



Actual Bottom-Hole Location of Subera 3404 2-18H  
T&R: 34S 4W  
Section: 18, 1050' FEL & 330' FSL  
-97.787068 37.082787

1 in = 667 ft




● Actual BH Location

\* SandRidge Wells

--- Perf

□ Sections

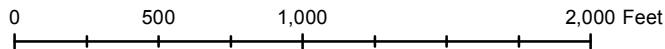

Draftsman:

Dory Deines

Draft Date: 9/24/2014

Drawing Name/Number:

Addendum\_Subera 3404 2-18H.mxd

Coordinate System:

NAD 1927 State Plane  
Kansas South FIPS: 1502