

Section 33
34S 5W

Section 34
34S 5W

Harper County

Top Perf: 5642'
 -97.852950 37.040288

Miss Entry: 4788'
 -97.853584 37.038259

Section 4
35S 5W

CARL 3405 1-34H RICK 3505 1-3H
 * *
 Section 3 SKYLER RAE SWD 3505 1-3
 * *
 Section 35S 5W



Actual Bottom-Hole Location of Carl 3405 1-34H
 T&R: 34S 5W
 Section: 34, 1104' FWL & 330' FNL
 -97.853182 37.051410

1 in = 667 ft




● Actual BH Location

* SandRidge Wells

--- Perf

□ Sections

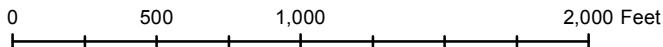

Draftsman: Dory Deines
 Draft Date: 11/11/2014

Drawing Name/Number:
 Addendum_Carl 3405 1-34H.mxd

Coordinate System:
 NAD 1927 State Plane
 Kansas South FIPS: 1502