

Section 33
33S 6W

591' FNL

2329' FEL

BHL: 8783'
-97.973731 37.121978
Bottom Perf: 8707'
-97.973734 37.121837

CURT 1-4

BILL 1-4

Harper County

Section 4
34S 6W

CLARK 1-4

Top Perf: 6032'
-97.973469 37.114428

BOLLMAN 3-4

Miss Entry: 4866'
-97.973389 37.111402

KATE 3406 1-4

GEORGE 3406 3-9H

GEORGE 3406 1-9H

JAMES 3406 1-4H JAMES 3406 2-4H

JAMES 3406 3-9H

GEORGE 3406 2-4H

JAMES 3406 4-9H

Section 9
34S 6W



Actual Bottom-Hole Location of James 3406 1-4H
T&R: 34S 6W
Section: 4, 2329' FEL & 591' FNL
-97.973731 37.121978


1 in = 667 ft



● Actual BH Location

* SandRidge Wells

--- Perf
□ Sections

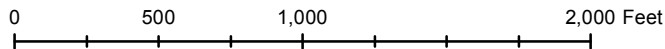

Draftsman:

Dory Deines

Draft Date: 11/20/2014

Drawing Name/Number:

Addendum_James 3406 1-4H.mxd

Coordinate System:

NAD 1927 State Plane
Kansas South FIPS: 1502