


Hunt Lease

Write a description for your map.

Legend

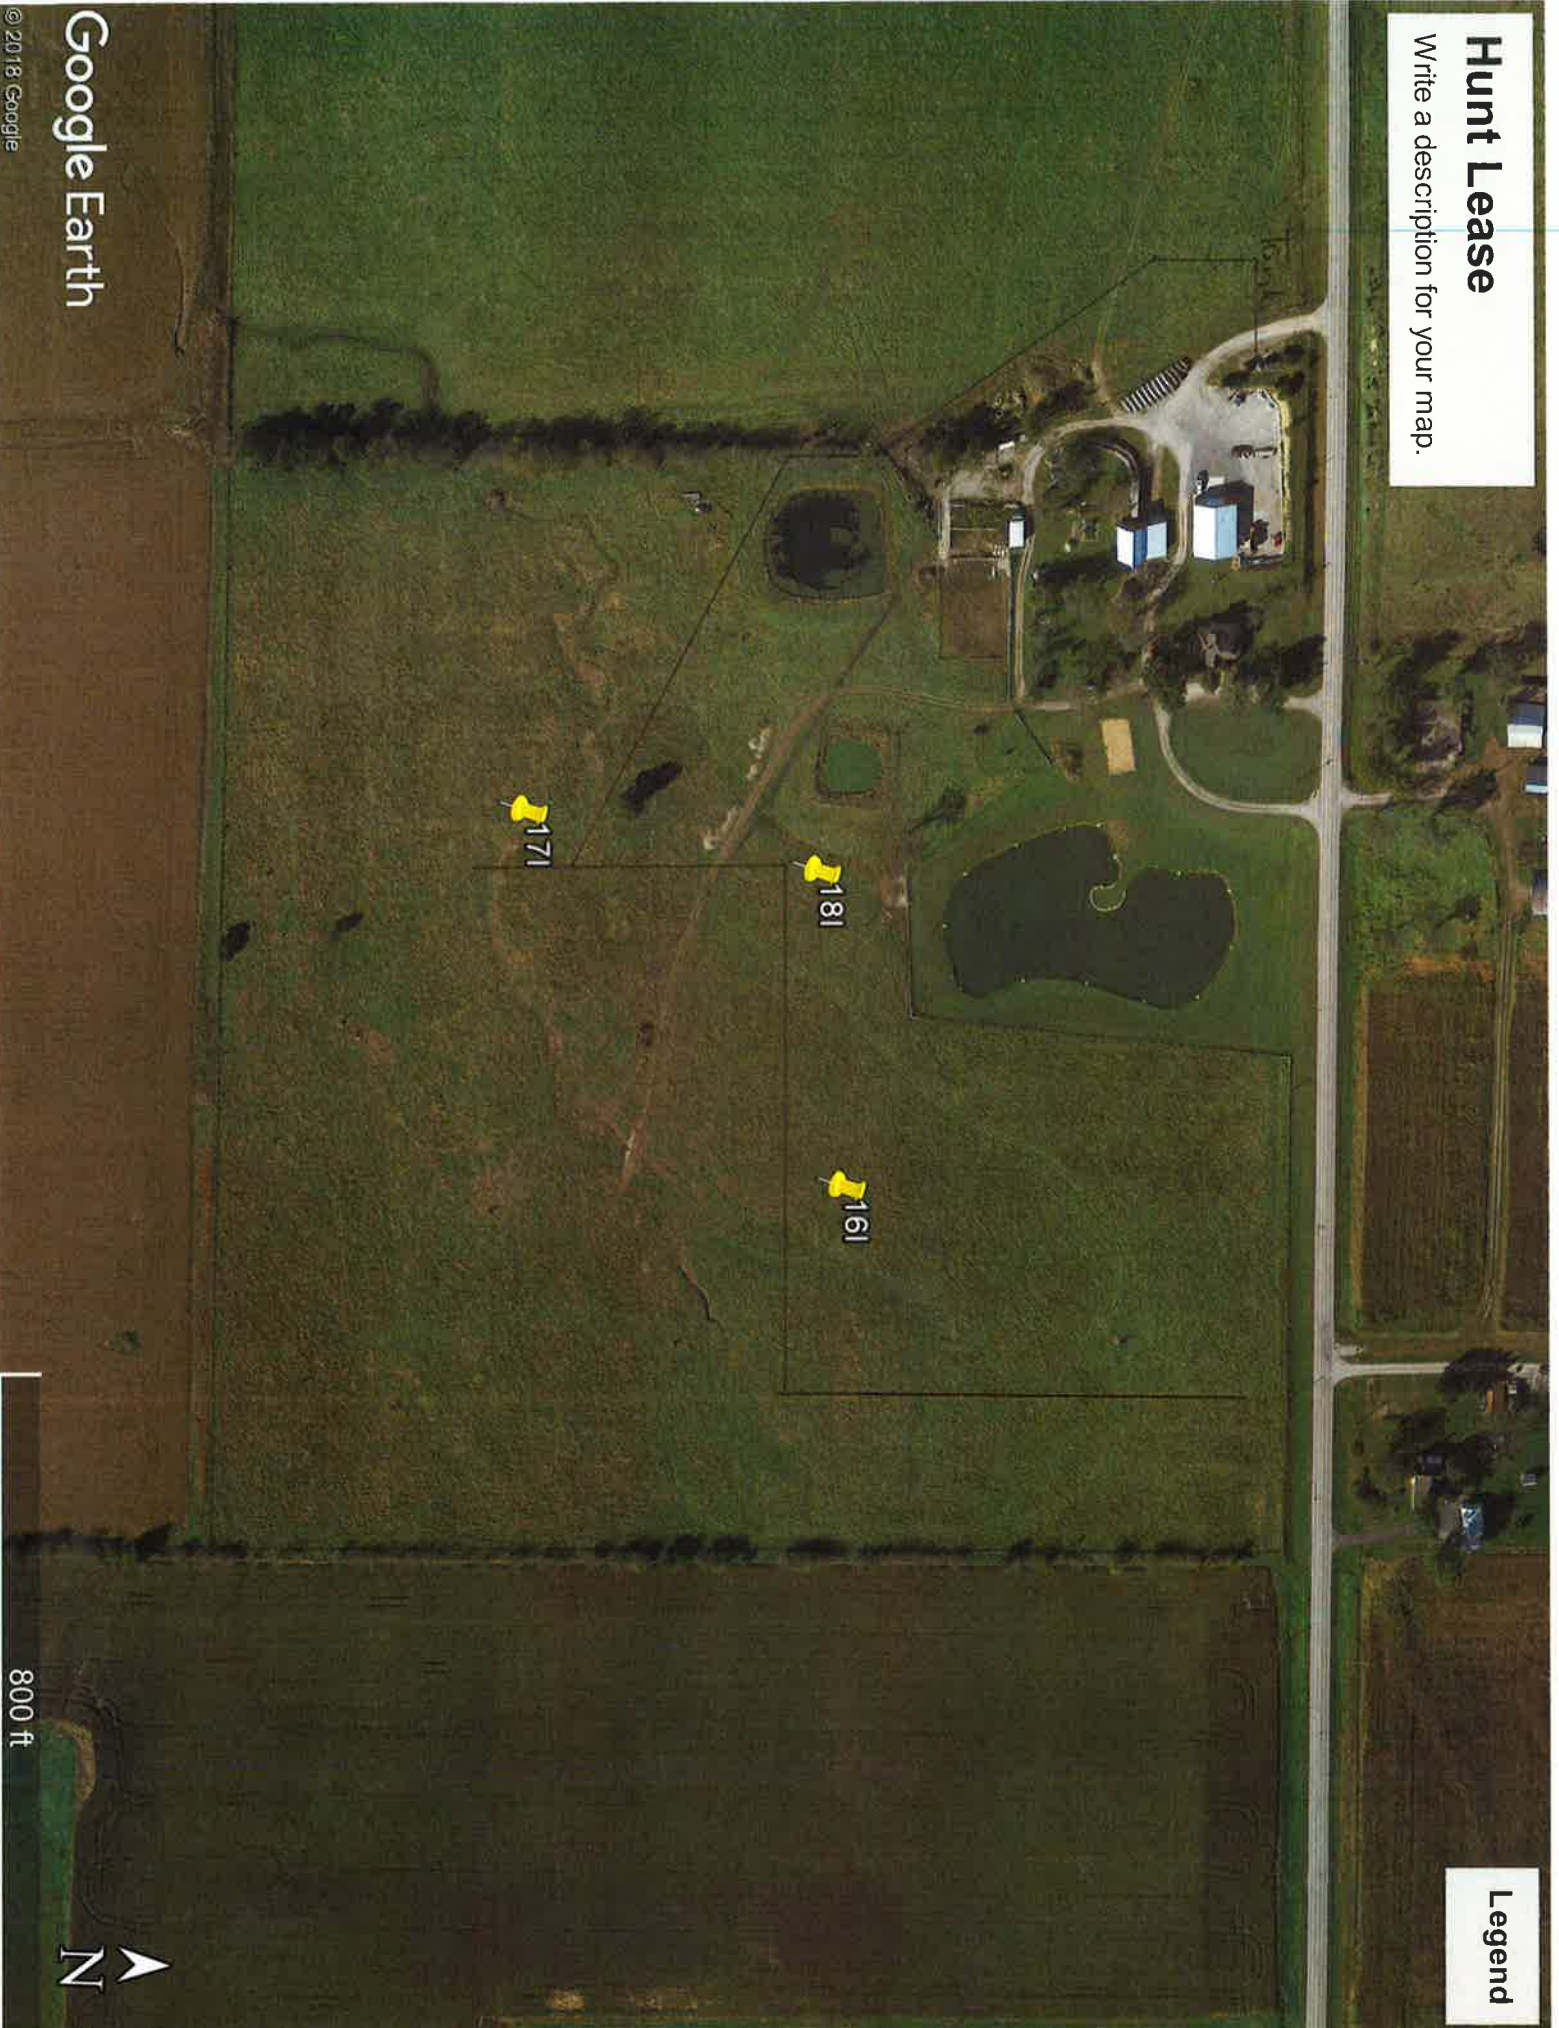

Google Earth

© 2018 Google

800 ft

