

VINCENT OIL CORPORATION
SMITH LEASE
SE. 1/4, SECTION 6, T29S, R22W
FORD COUNTY, KANSAS

GRAVEL (WILBURN RD.) ROAD

Notes:

1. Set (2) wood stakes at location site.
2. All flagging Red & Yellow.
3. Overhead power available at S., E. & W. lines and W. 1/2 of N. line, Sec. 6.
4. Kansas One Call System Inc. should be notified before excavation (1-800-344-7233).
5. CAUTION: Various pipelines in Sec. 6.
6. Section 6 is irregular.
7. Contact landowner for best access.
8. Original Location fell on the north edge of a grass water-way, revised location per instructions.

Drillsite Location
Smith #3-6
2310'FSL 2037'FEL
Ground Elevation = 2501
Y = 323376 X = 1633490

State Plane-NAD 27-Kansas South
Latitude 37.54796
Longitude -99.764223
(NAD 27)

SMITH #2-6
2511

STUBBLE

TANK BATTERY

WTR WAY


1157'

735'

ROAD (124 ROAD)
GRAVEL

ROAD (125 ROAD)
PAVED

GRAVEL (WILDFIRE RD.) ROAD

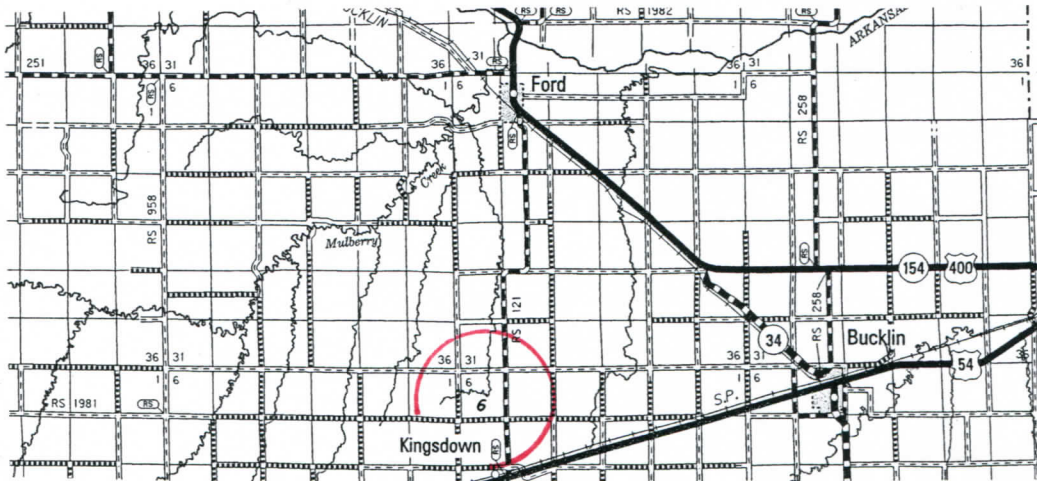

* Controlling data is based upon the best maps and photographs available to us and upon a regular section of land containing 640 acres.
* Approximate section lines were determined using the normal standard of care of oilfield surveyors practicing in the state of Kansas. The section corners, which establish the precise section lines, were not necessarily located, and the exact location of the drillsite location in the section is not guaranteed. Therefore, the operator securing this service and accepting this plot and all other parties relying thereon agree to hold Central Kansas Oilfield Services, Inc., its officers and employees harmless from all losses, costs and expenses and said entities released from any liability from incidental or consequential damages.
* Elevations derived from National Geodetic Vertical Datum.

Date February 1, 2019

* Ingress and egress to location as shown on this plot is per usage only and may not be legally opened for public use. Contact landowner, tenant and county road department for access.