


ENTRANCE

EMERGENCY EXIT

84'

LEASE ROAD

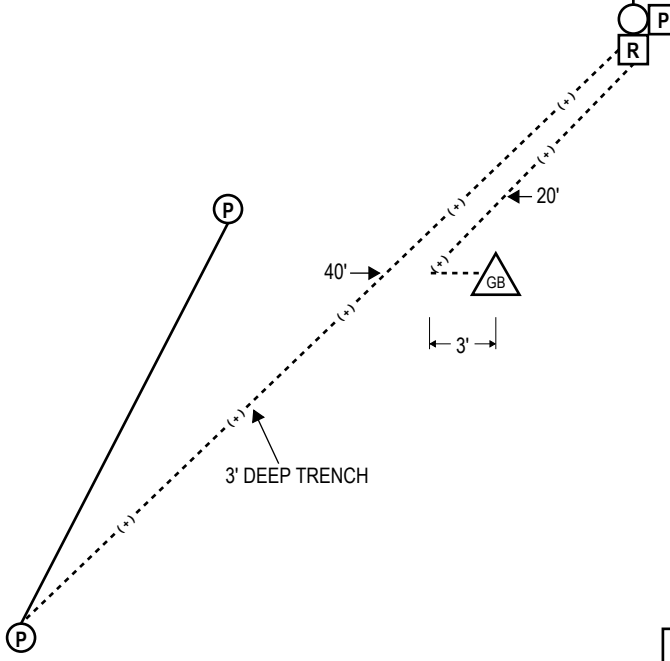

3' DEEP TRENCH

40'

3'

20'

COUNTY ROAD 130

LEGEND:

- GROUND BED
- RECTIFIER
- POSITIVE JUNCTION BOX
- NEW 25' POLE AND METER LOOP
- CHAIN LINK FENCE



	System: QUINTER FACILITY ICCP	Company: WILLIAMS
		Contact: WAYNE STEPHENS
	Location: QUINTER FACILITY	Sta. #/Test Point #:
		County/Parish: SHERIDAN State: KS
	Description: DEEP GROUND BED INSTALLATION	Lat: 39.155556 Location ID:
	Long: -100.202210 Phase #: TSP-008031	
	Date: 12/12/18 Captured By: JDR	