

# ADVANTAGE ELEVATIONS

OIL FIELD SURVEYORS

BOX 8604 - PRATT, KS 67124  
(620) 672-6491

124181

INVOICE NO.

CHIEFTAIN OIL CO., INC

OPERATOR

1

NO.

STOCKWELL

FARM

BARBER

COUNTY

36

S

31s

T

12w

R

770' FNL & 1050' FWL of SEC.


 

 

LOCATION

ELEVATION: 1560' GR


CHIEFTAIN OIL CO., INC  
PO BOX 124  
KIOWA, KS 67070



### LEGEND

-  Well Location
-  Tank Battery Location
-  Pipeline Location
-  Electric Line Location
-  Lease Road Location

AUTHORIZED BY: Ryan Molz

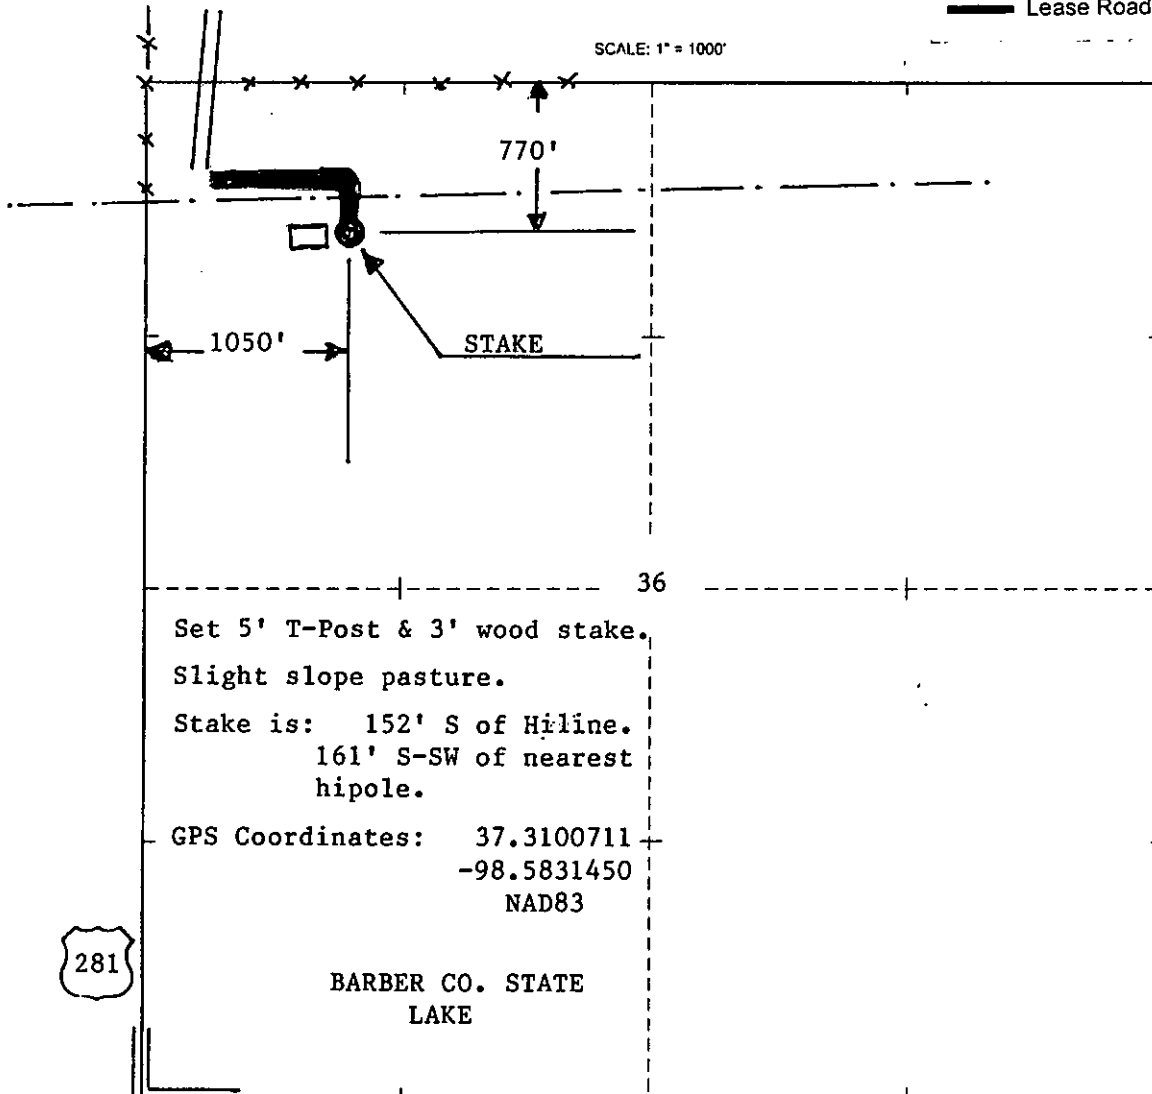

MEDICINE LODGE, KANSAS

DATE STAKED: 12/4/18