


Castle Resources Inc #9860
32.75-19w

Patterson #1

NE-NW-NW
990' FWL
330' FNL

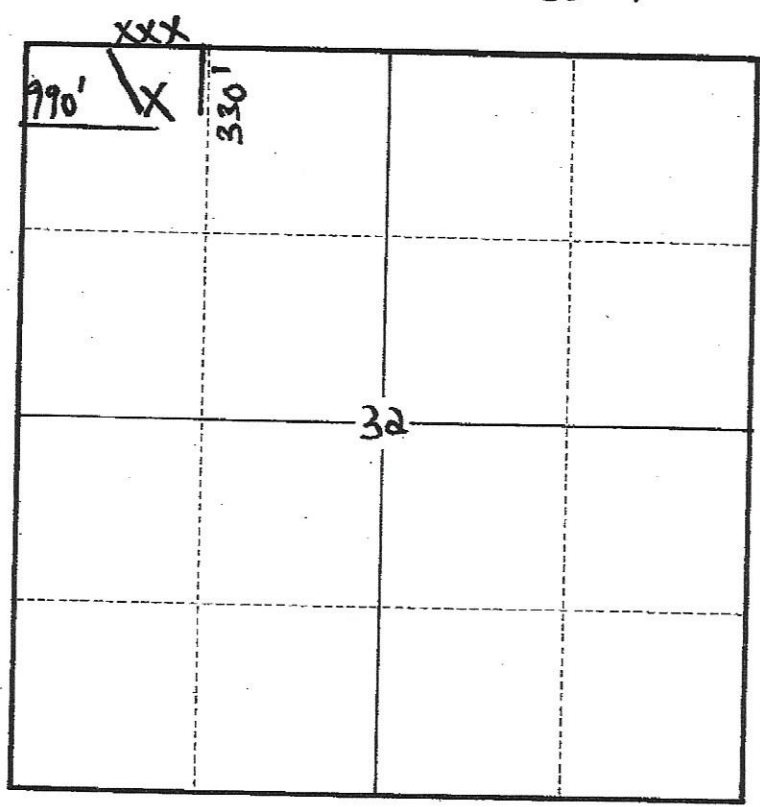

X = Location

XXX = Proposed Tank battery

/ = Trail into well