
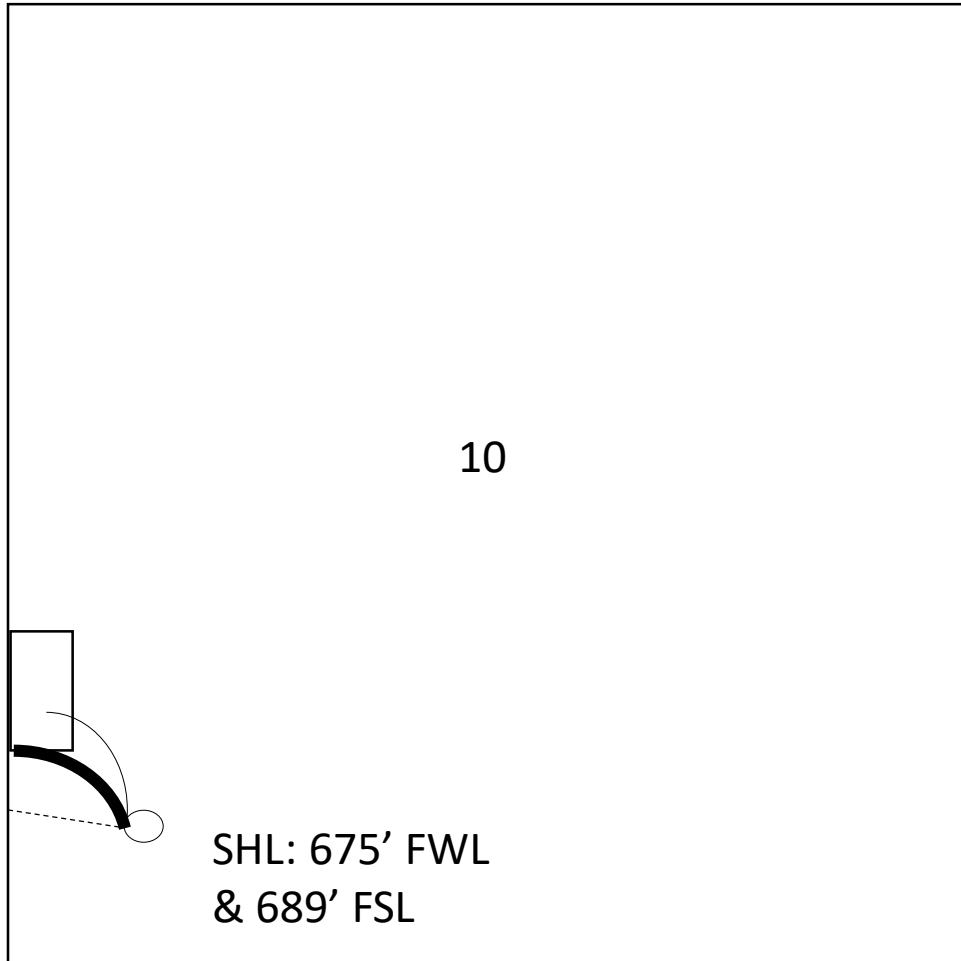



 


Wassemiller 1-10
Section 10-11S-34W
Logan County, KS

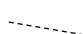

Legend

-  Electric Line Location
-  Pipeline Location
-  Lease Road Location
-  Well Location
-  Tank Battery Location

*Not to scale