

Salley #2-33

Current

Sec. 33-33S-33W

2040' FNL & 2040' FEL

Seward Co., KS

API#: 175-20839

Recompletion-Toronto

Orig Drilled: 3/26/85

Today's date: 3/15/19

Toronto Perfs:


4270-4276 2 spf 12 holes

Perforations:

5964-5992 76 holes 4 spf

2 SPF: 6154-58, 6167-71

6173-77

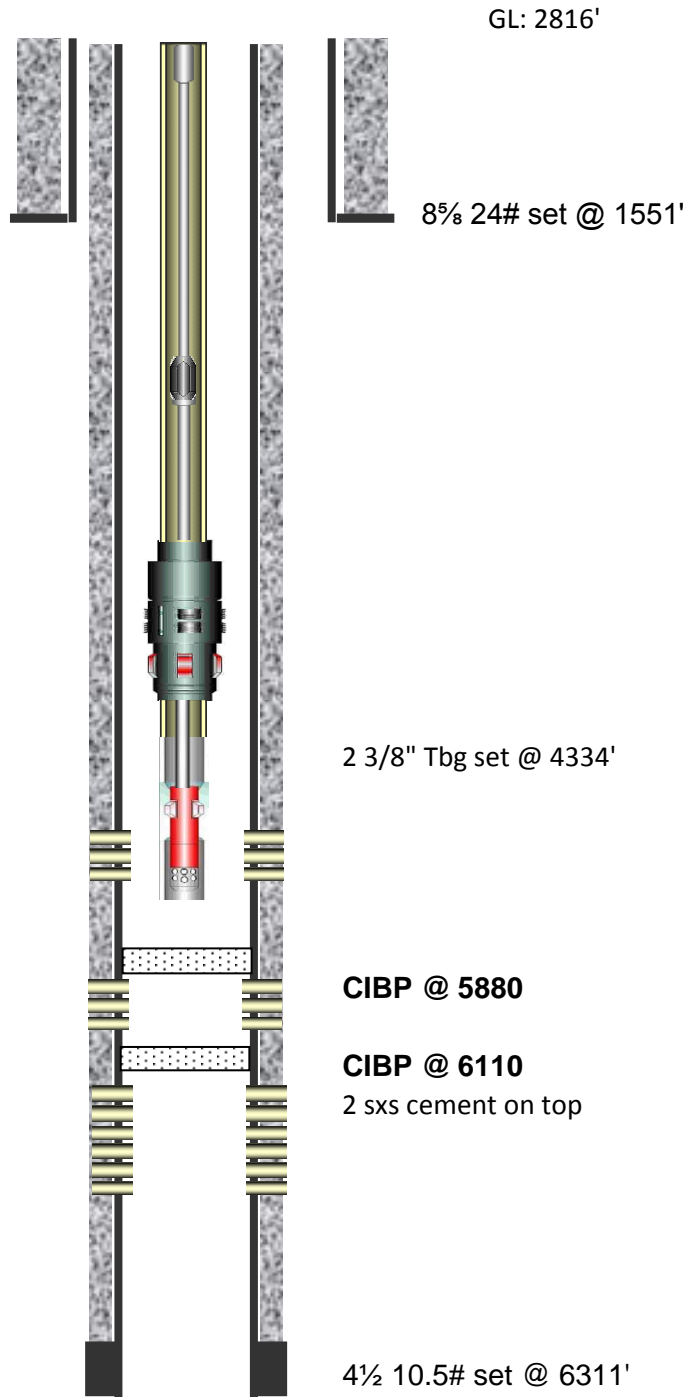

GL: 2816'

8 5/8 24# set @ 1551'

2 3/8" Tbg set @ 4334'

CIBP @ 5880

CIBP @ 6110

2 sxs cement on top

4 1/2 10.5# set @ 6311'

TD: 6500'

PBSD: 6311'