


James P. Williams Enterprises, Inc

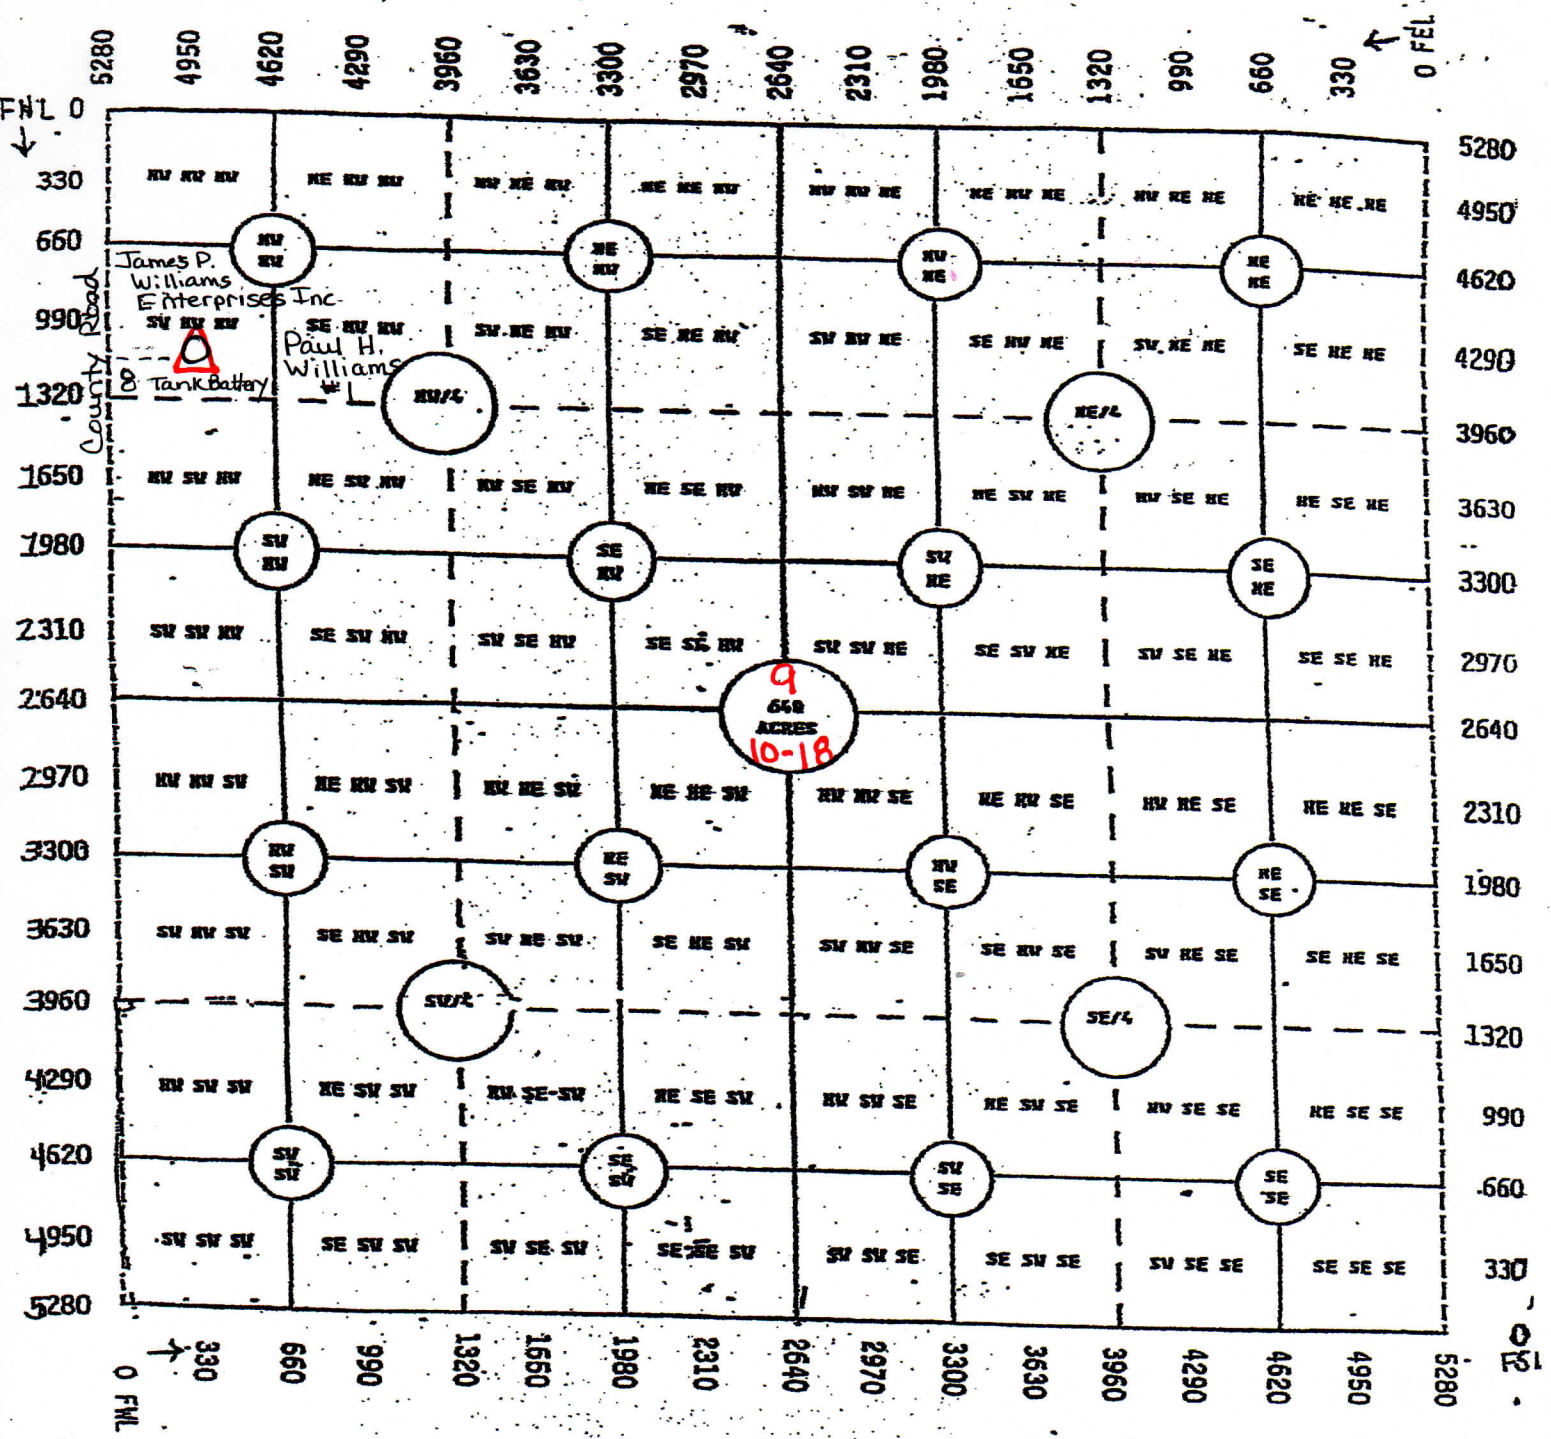

Paul H. Williams #1 (formerly Williams #1)

API # 15-163-01856 SW NW NW

of S9-T10S-R18W of Rooks County
Kansas

if owwo is a producer
a leadline will go south of location
going West to County Road to
Tank Battery