


Wellbore Schematic Input Report

Well Name: **MADDY B W-02**

Well Config: VERTICAL - Original Hole, 11/17/2011 8:58:09 AM

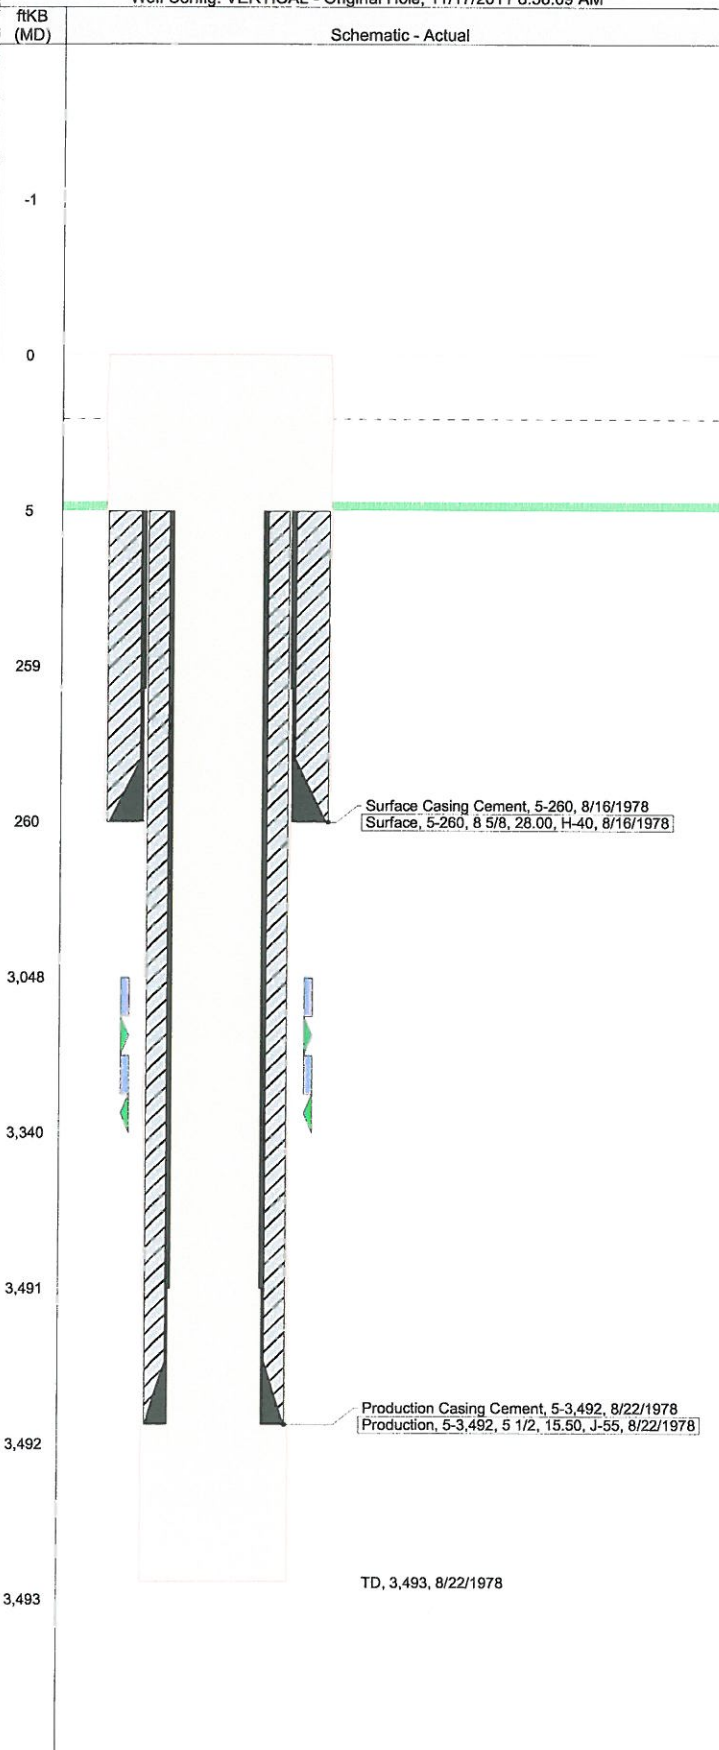

Well Header

API		Business Unit		Spud Date		Well Configuration Type	
15-163-20834		ROCKIES MID-CON		8/16/1978		VERTICAL	
Orig KB Elev (ft)	KB - GL / ...	Quarter Quarter	Sec/Abs	Twn/Su...	Range	P & A Date	
1,985.00	5	SE SE NE	36	8S	18W		
Comment							

Comment

Directions To Well

Bottom Hole Location

North-South Distance (ft)	From N or S Line	East-West Distance (ft)	From E or W Line
---------------------------	------------------	-------------------------	------------------

PBTDs

Date	Depth (ftKB)	Method	Comment
------	--------------	--------	---------

Wellbore Sections

Section	Size (in)	Act Top (ftKB)	Act Btm (ftKB)
SURFACE	12 1/4	0.0	260.0
PRODUCTION	7 7/8	260.0	3,493.0

Zone Statuses

Zone	Status Date	Status	Job
ARBUCKLE		SI	

Casing Strings

Surface, 260.0ftKB

Casing Description	Run Date	String ...	String Wt...	String ...	Top (ftKB)	Set Depth ...
Surface	8/16/1978	8 5/8	28.00	H-40	0.0	260.0

Production, 3,492.0ftKB

Casing Description	Run Date	String ...	String Wt...	String ...	Top (ftKB)	Set Depth ...
Production	8/22/1978	5 1/2	15.50	J-55	-1.0	3,492.0

Cement

Description	Top (ftKB)	Bottom (ftKB)
Surface Casing Cement	5.0	260.0
Description	Top (ftKB)	Bottom (ftKB)
Production Casing Cement	5.0	3,492.0

Tubing Components

Item Description	OD (in)	Wt (lbs/ft)	Grade	Jts	Len (ft)	Btm (ftKB)	Bottom Depth (TVD) (ftKB)
------------------	---------	-------------	-------	-----	----------	------------	---------------------------

Perforation Data

Zone	Bnch/Stg	Entered Shot Total	Top (ftKB)	Btm (ftKB)	Date
------	----------	--------------------	------------	------------	------

Stimulations & Treatments

Date	Zone	Primary Job Type
11/1/2010		ACID TREATMENT
Technical Result	Tech Result Details	Tech Result Notes

Comment

Other In Hole

Run Date	Description	OD (in)	Top (ftKB)	Btm (ftKB)
----------	-------------	---------	------------	------------

Logs

Date	Type	Top (ftKB)	Btm (ftKB)
------	------	------------	------------

R-4 packer set @ 3000'

WELL MADDDY B-2 INJ
LEGAL SE-SE-NE S W 36-8-18 ROOKS
AVG DAILY PROD 80 BW
DATE DRILLED MO 8 YR 78
CUM PROD 80
CUM PROD 80 (LEASE)
BUYER _____
UTL SUPPL _____
AVG COST _____ MO.
CHEM _____
AVG COST _____ MO

PUMPING UNIT MAN. NONE
SIZE _____
SN _____

ENGINE MAN. NONE
SIZE _____
SN _____

TUBING 2 7/8" @ 3000' CEMENT LINED

RODS NONE OF " _____ OF " _____

PUMP MAN. NONE
SIZE _____

GUN BBL RW FG ST BBL
STOCK NO
SALT WTR SIZE 200# FIBERGLASS

LOGS OH CB GN GRDC NONE

SURF 8 5/8" @ 215'

SQUEEZE @ 125'

PERF _____
HOLE _____
DV _____

ANHY _____

PROD. PERFS

3048 - 3052

3144 - 3148

3178 - 3182

3227 - 3231

3238 - 3242

3245 - 3302

3313 - 3320

3336 - 3340

CEM TOP SURFACE
CEM 350 SX

PBTD 5 1/2"
SET 3493
RTD 3493

COMMENTS