


DNR OIL & GAS, INC.
 ZUEGE LEASE
 SW. 1/4, SECTION 23, T15S, R41W
 CHEYENNE COUNTY, KANSAS

GRAVEL ROAD (CO RD 88) ROAD


Notes:

1. Set (2) wood stakes at location site.
2. All flogging Red & Yellow.
3. Overhead power available at W. line and W. 1/2 of S. line, Sec. 23.
4. Kansas One Call System Inc. should be notified before excavation (1-800-344-7233).
5. CAUTION: Various pipelines in Sec. 23.
6. Contact landowner for best access and as to location of wood stakes in wheat.

• Highways and roads to location as shown on this plot is for usage only and may not be legally opened for public use. Contact landowner, tenant and county road department for access.

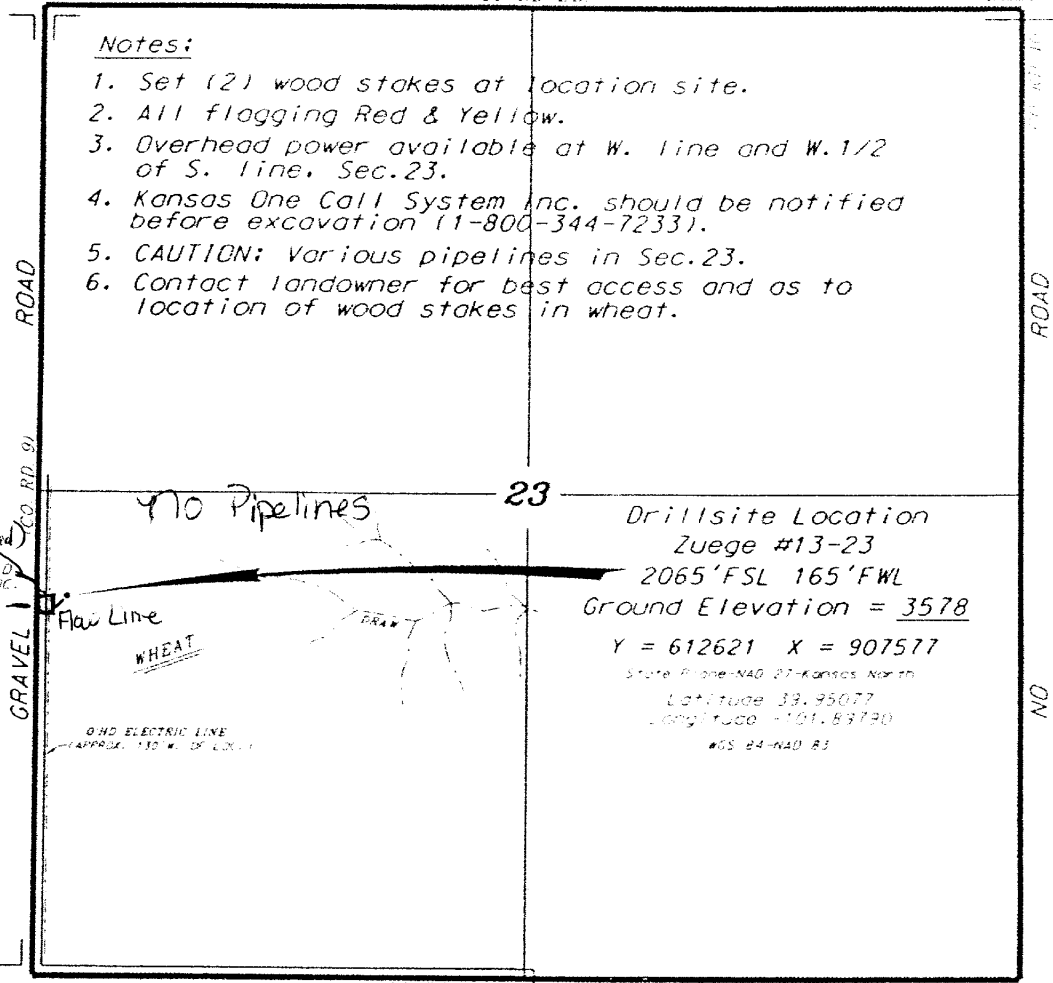

GRAVEL ROAD (CO RD 44) NO ROAD

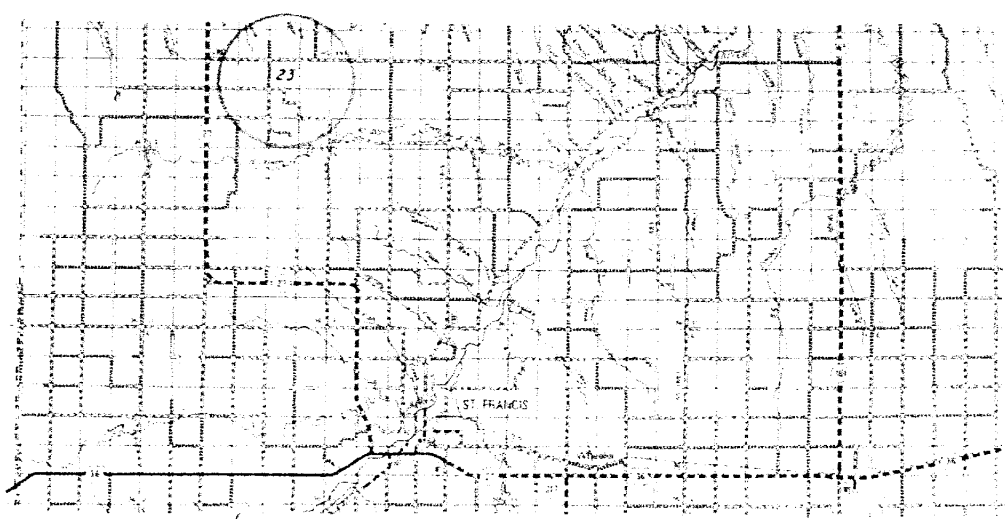

• Control and data is based upon the best data and information available to us and does not represent a warranty of location of, and location of, 23, zones.



• All locations derived from this and other data are approximate.

Date April 4, 2019