N/A
CRD NO.

00-24s-23w
DMT NO.

# PRO-STAKE LLC
Construction Site Staking

14204
INVOICE NO.

P.O. Box 2324 Garden City, Kansas 67846
Office/Fax: (620) 276-6159 – Cell: (620) 272-1499
burt@prostakellc.com

Mull Drilling Company, Inc.
OPERATOR

Hodgeman County, KS
COUNTY

Fagen A #1-16
LEASE NAME

C S/2 NE/4 NW/4 (KGS)
LOCATION SPOT

2398' (KGS)
GR ELEVATION

37.968573
NAD 83 LAT

99.856402
NAD 83 LONG

| 16 | 24s | 23w |
|---|---|---|
| Sec. | Twp. | Rng. |

SCALE: 1" = 1000'
DATE STAKED: April 9th, 2019
MEASURED BY: Burt W.
DRAWN BY: Pierce R.
AUTHORIZED BY: Tannis T.
DATE REVISED:

N

LEGEND

- irr. well
- water hydrant
- tank battery
- staked loc.
- prod. well / aband. well
- house
- building
- gas line
- water line
- transmission powerline
- 3 phase powerline
- single phase powerline
- fence
- gravel / sand rd.
- gravel trail / lease rd.
- dirt rd.
- dirt trail / lease rd.
- Hwy / blacktop rd.

**DIRECTIONS:** From Jetmore, KS at the intersection of Hwy. 283 & Hwy 156 – Now go 6.1 miles South on Hwy. 283 – Now go 2 miles East on SE G Rd. – Now go 2 miles South on SE 220 Rd to the NW corner of section 16-24s-23w – Now continue approx. 740' South on SE 220 Rd. to ingress stake East into at cattle guard – Now go approx. 0.4 miles East, along trail and through pasture grass into staked location

**Final ingress must be verified with landowner or operator.**
*This drawing does not constitute a monumented survey or a land survey plat.*
*This drawing is for construction purposes only.*
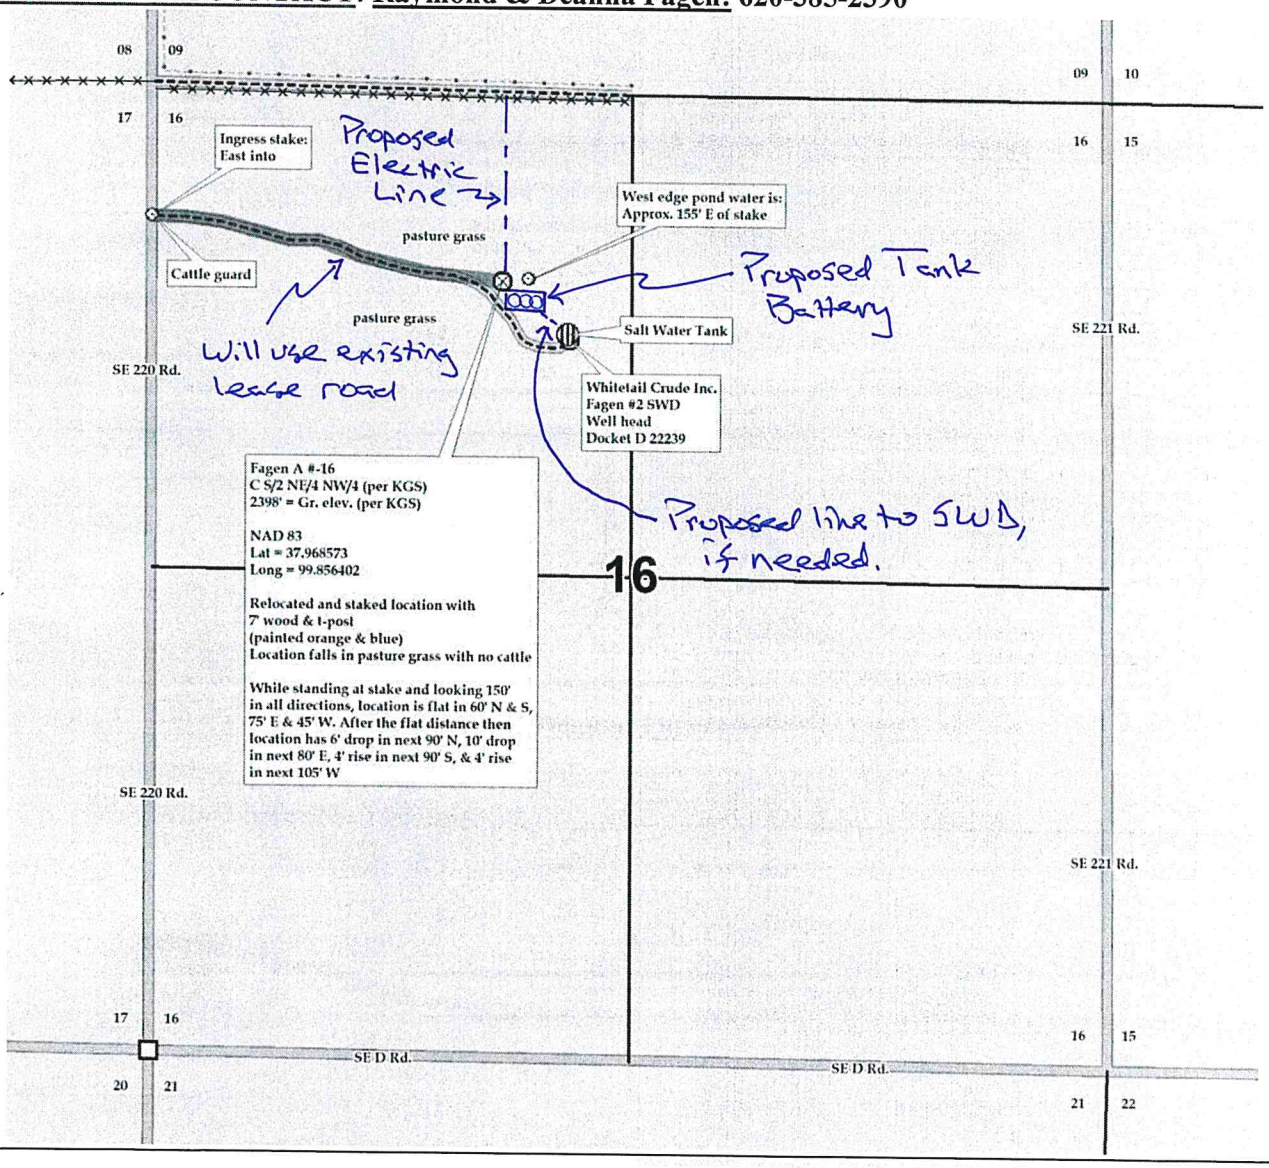
## LANDOWNER/CONTACT: Raymond & Deanna Fagen: 620-385-2390