


**GRIFFIN MANAGEMENT, LLC**  
**ADDIE LEASE**  
**SW.1/4, SECTION 28, T29S, R15W**  
**PRATT COUNTY, KANSAS**

GRAVEL (SW. 100TH ST.) ROAD

**Notes:**


1. Set iron rod at location site.
2. All flagging Red & Yellow.
3. Overhead power available at N., S. & W. lines, Sec. 28.
4. Kansas One Call System, Inc. should be notified before excavation (1-800-344-7233).
5. CAUTION; Various pipelines in Sec. 28.
6. Contact landowner for best access.

\* Ingress and egress to location as shown on this plat is per usage only and may not be legally opened for public use. Contact landowner, tenant and county road department for access.

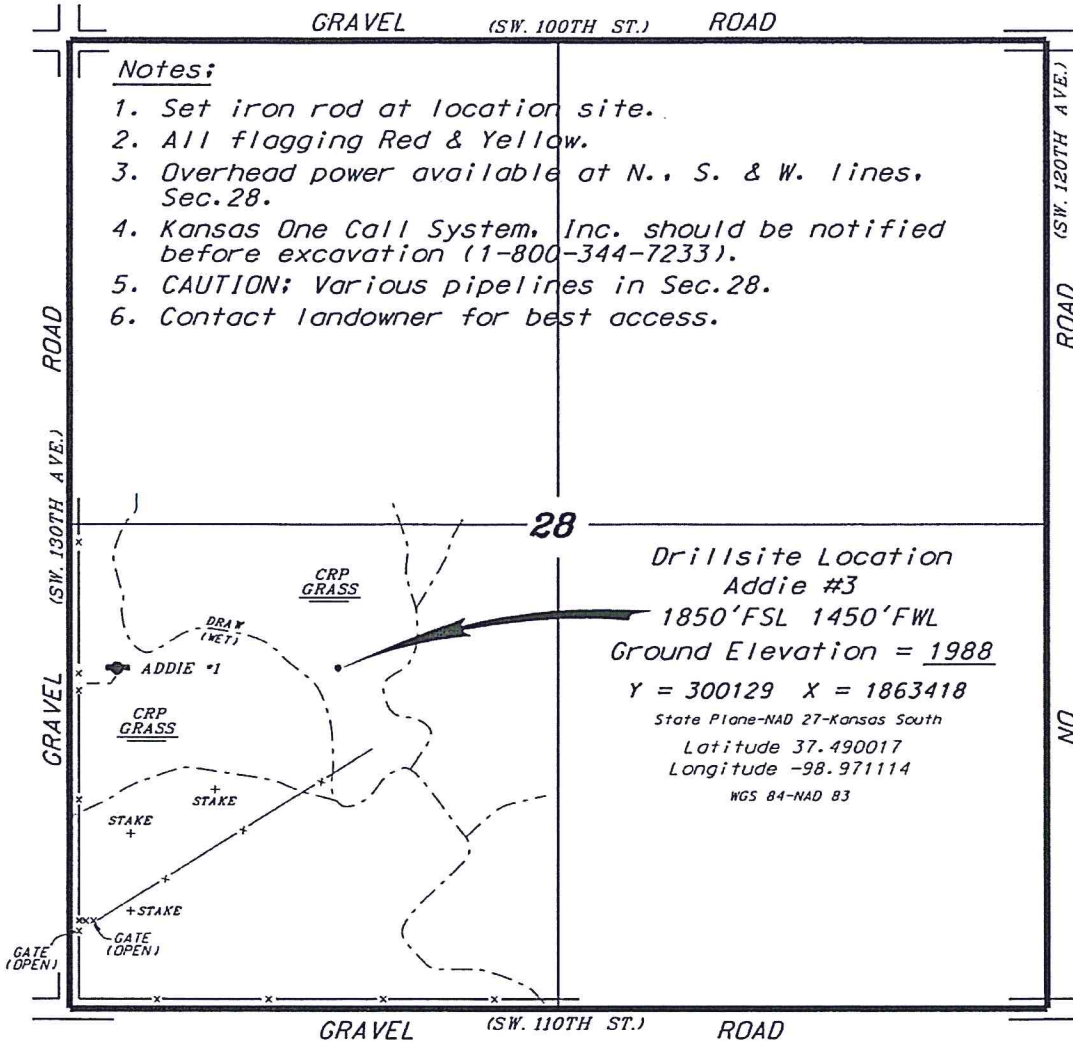

**28**

**Drillsite Location**  
**Addie #3**  
**1850'FSL 1450'FWL**  
**Ground Elevation = 1988**  
**Y = 300129 X = 1863418**  
 State Plane-NAD 27-Kansas South  
 Latitude 37.490017  
 Longitude -98.971114  
 WGS 84-NAD 83

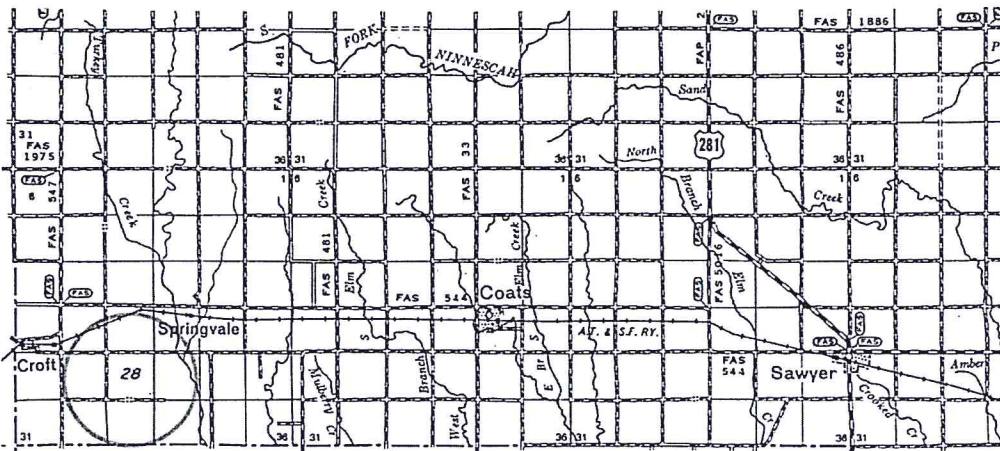

\* Controlling data is based upon the best maps and photographs available to us and upon a regular section of land containing 640 acres.  
 \* Approximate section lines were determined using the normal standard of care of oilfield surveyors practicing in the state of Kansas. The section corners, which establish the precise section lines, were not necessarily located, and the exact location of the drillsite location in the section is not guaranteed. Therefore, the operator securing this service and accepting this plat and all other parties relying thereon agree to hold Central Kansas Oilfield Services, Inc., its officers and employees harmless from all losses, costs and expenses and said entities released from any liability from incidental or consequential damages.  
 \* Elevations derived from National Geodetic Vertical Datum.

Date April 10, 2019

UNITED STATES  
DEPARTMENT OF THE INTERIOR  
BIOLOGICAL SURVEY

STATE (

