



Fall & Associates
 Stake and Elevation Service
 P.O. Box 222
 Pretty Prairie, KS. 67570
 785-243-7506

Date 4-25-19

Invoice Number 04203191

BRITO OIL COMPANY

1-28

Four Boys

Operator

Number

Farm Name

Cheyenne-KS

28

4s

37w

2000'FSL 1320'FWL

County-State

S

T

R


Location

Brito Oil Company
 8100 N. 22nd
 Bldg. 600, Suite R
 Wichita, Ks. 67226

Elevation 3381 Gr.

Ordered By: Raul

Scale 1"=1000'

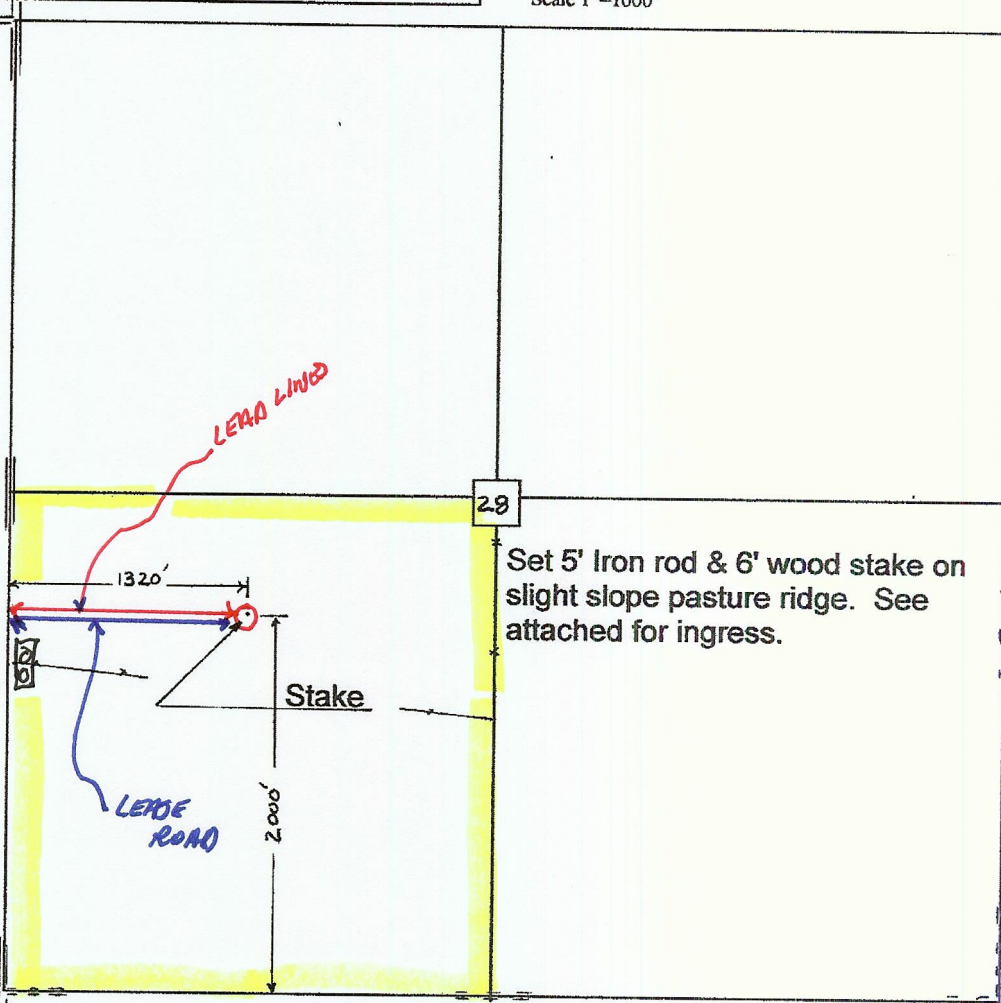

28

Set 5' Iron rod & 6' wood stake on slight slope pasture ridge. See attached for ingress.

LEAD LINES


Stake


1320'

2000'