


VINCENT OIL CORPORATION
 IMEL-ROTZ LEASE
 SW.1/4, SECTION 5, T29S, R22W
 FORD COUNTY, KANSAS

GRAVEL (WILBURN ROAD) ROAD

Notes:



1. Set (2) wood stakes at location site.
2. All flagging Red & Yellow.
3. Overhead power available at N. & W. lines, Sec.5.
4. Kansas One Call System Inc. should be notified before excavation (1-800-344-7233).
5. CAUTION; Various pipelines in Sec.5.
6. Section 5 is irregular.
7. Contact landowner for best access and as to location of wood stakes in wheat.
8. Location fell 10'NE. of a NW-SE terrace, no alternate set per representative.

* Ingress and egress to location as shown on this plat is per usage only and may not be legally opened for public use. Contact landowner, tenant and county road department for access.

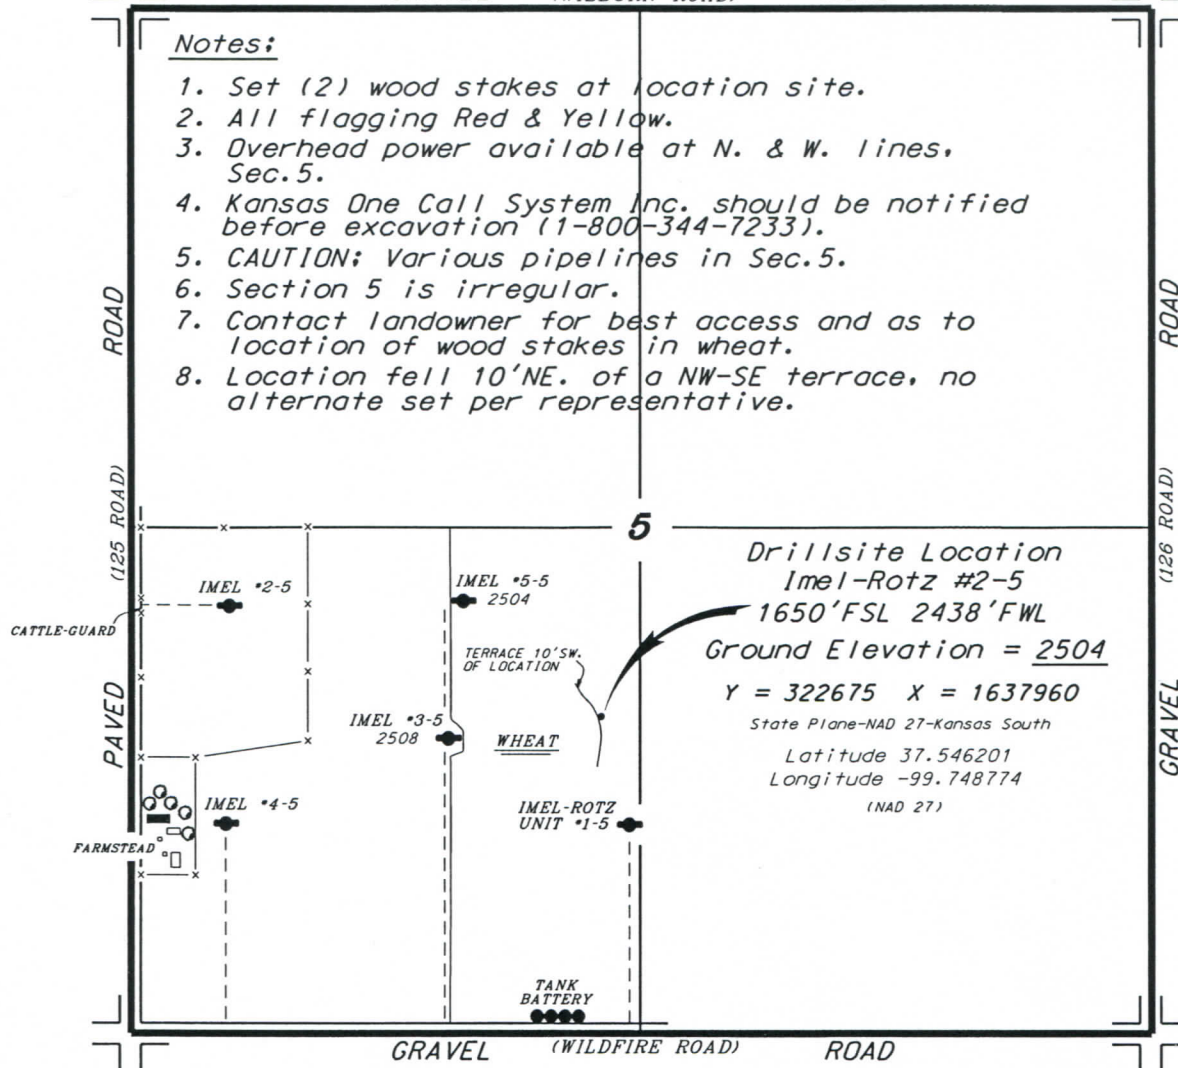

Drillsite Location
 Imel-Rotz #2-5
 1650'FSL 2438'FWL
 Ground Elevation = 2504

Y = 322675 X = 1637960
 State Plane-NAD 27-Kansas South
 Latitude 37.546201
 Longitude -99.748774
 (NAD 27)

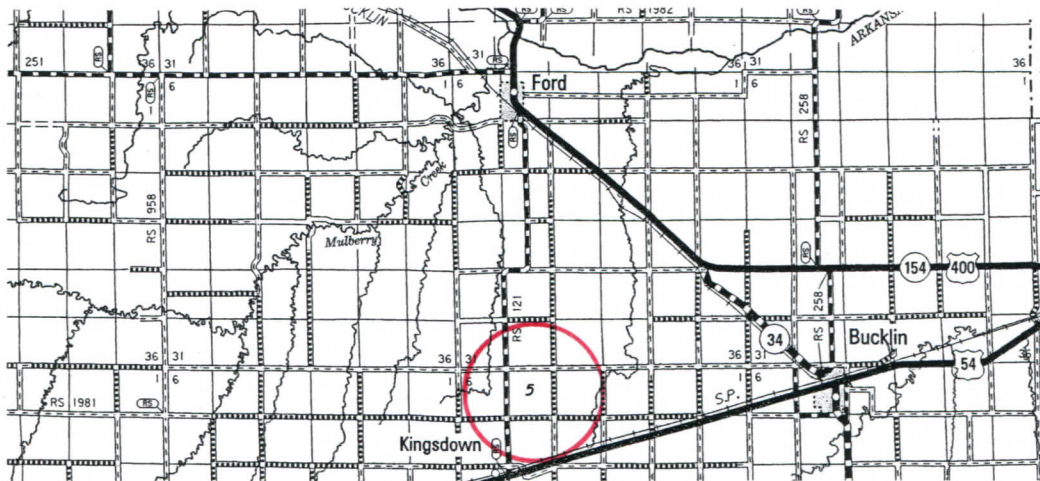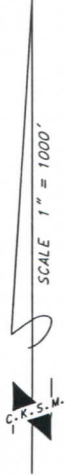

* Controlling data is based upon the best maps and photographs available to us and upon a regular section of land containing 640 acres.
 * Approximate section lines were determined using the normal standard of care of oilfield surveyors practicing in the state of Kansas. The section corners, which establish the precise section lines, were not necessarily located, and the exact location of the drillsite location in the section is not guaranteed. Therefore, the operator securing this service and accepting this plat and all other parties relying thereon agree to hold Central Kansas Oilfield Services, Inc., its officers and employees harmless from all losses, costs and expenses and said entities released from any liability from incidental or consequential damages.
 * Elevations derived from National Geodetic Vertical Datum.

Date April 16, 2019

