NewGulf RESOURCES

Well Name: **A C Felts #1**
State: KS
County: Scott
Field: White
API: 15-171-20878
Location: 6-18-34 W
Operator: NGO

Elevations	
RKB	3164'
DF	
GL	3154'

Directional Data		
KOP		RKB
Max DEV	o	RKB
Max Dogleg	o	RKB
Dev @ Perfs	o	RKB
Return to Vertical		RKB

Last Update: 1/30/2017
Schematic AS OF Date: 5/3/2018

Spud 5/14/2012
TD: 5/24/2012
Completion: 5/25/2012

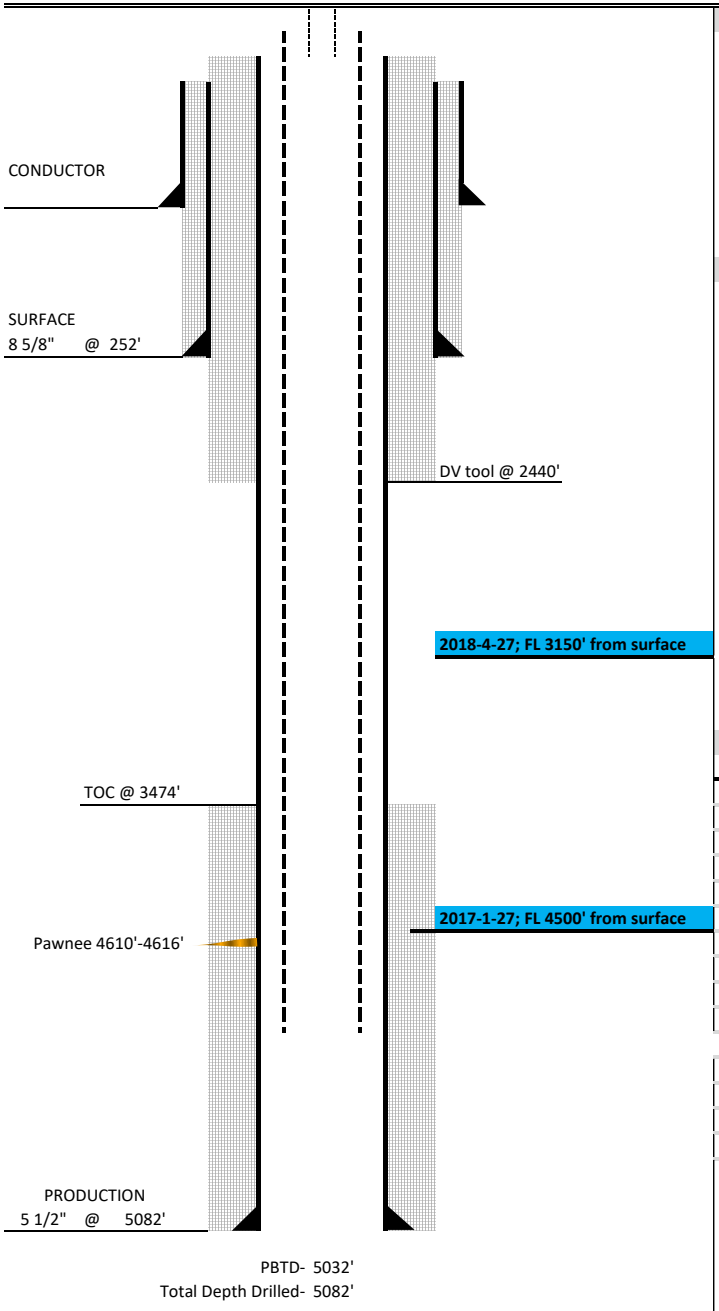

CASING / CEMENT

INTERVAL	HOLE	CSG	WT.	GR.	Depth Top	Depth Btm	LENGTH	CMT	TOC
COND.	-	-	-	-	'	'	'		
SURF.	12.25"	8 5/8"	24#	J-55	'	263'		200 sx	
Production	7.25"	5 1/2"		J-55	'	5082'			
DV Tool									
Tbg									
SN									
Rods									

Perf Data

Stage #	Formation	Top Perf	Btm Perf	Length	Net ft	SPF	Total Holes
1	Pawnee	4,610'	4,616'	6'	6'	6	36
				'			-
				'			-

NOTES: 12/29/16
TA well in January 2017, pumping unit will go to the Riedel 2-5.

Stimulation Data

Stage #	Water	Proppant	Acid	Avg R	Max R	Avg P	ISIP	FG