


[Empty rectangular box]

Township: \_\_\_\_\_ Range: \_\_\_\_\_ County: \_\_\_\_\_ State: \_\_\_\_\_

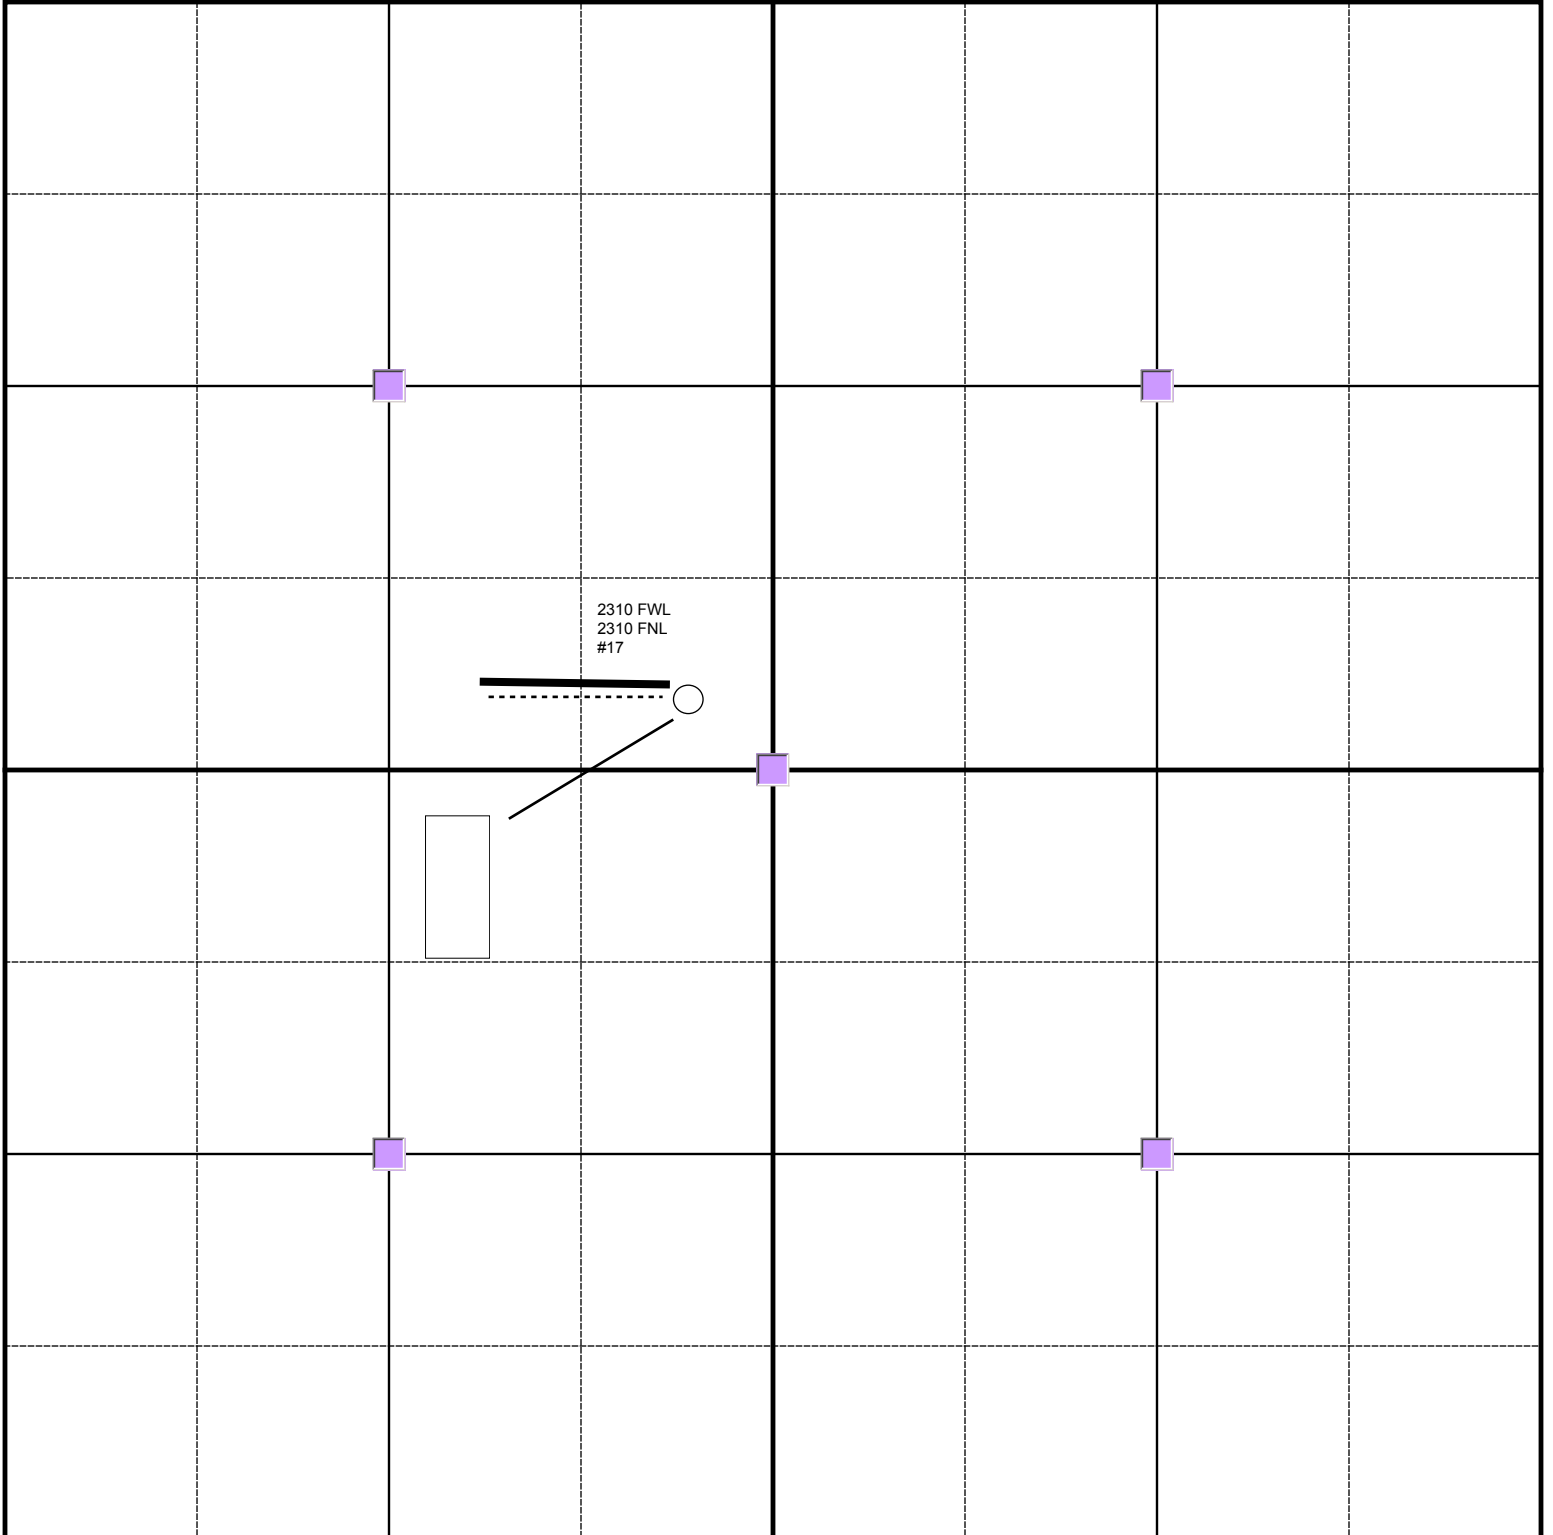

[Empty rectangular box] Tank Battery

— Road

— Pipeline

- - - - - Electric Line