


Sun City NE, KS Scale: 1" = 0.189MI 305Mt 1,000Ft, 1 Mi = 5,280', 1 cm = 120Mt

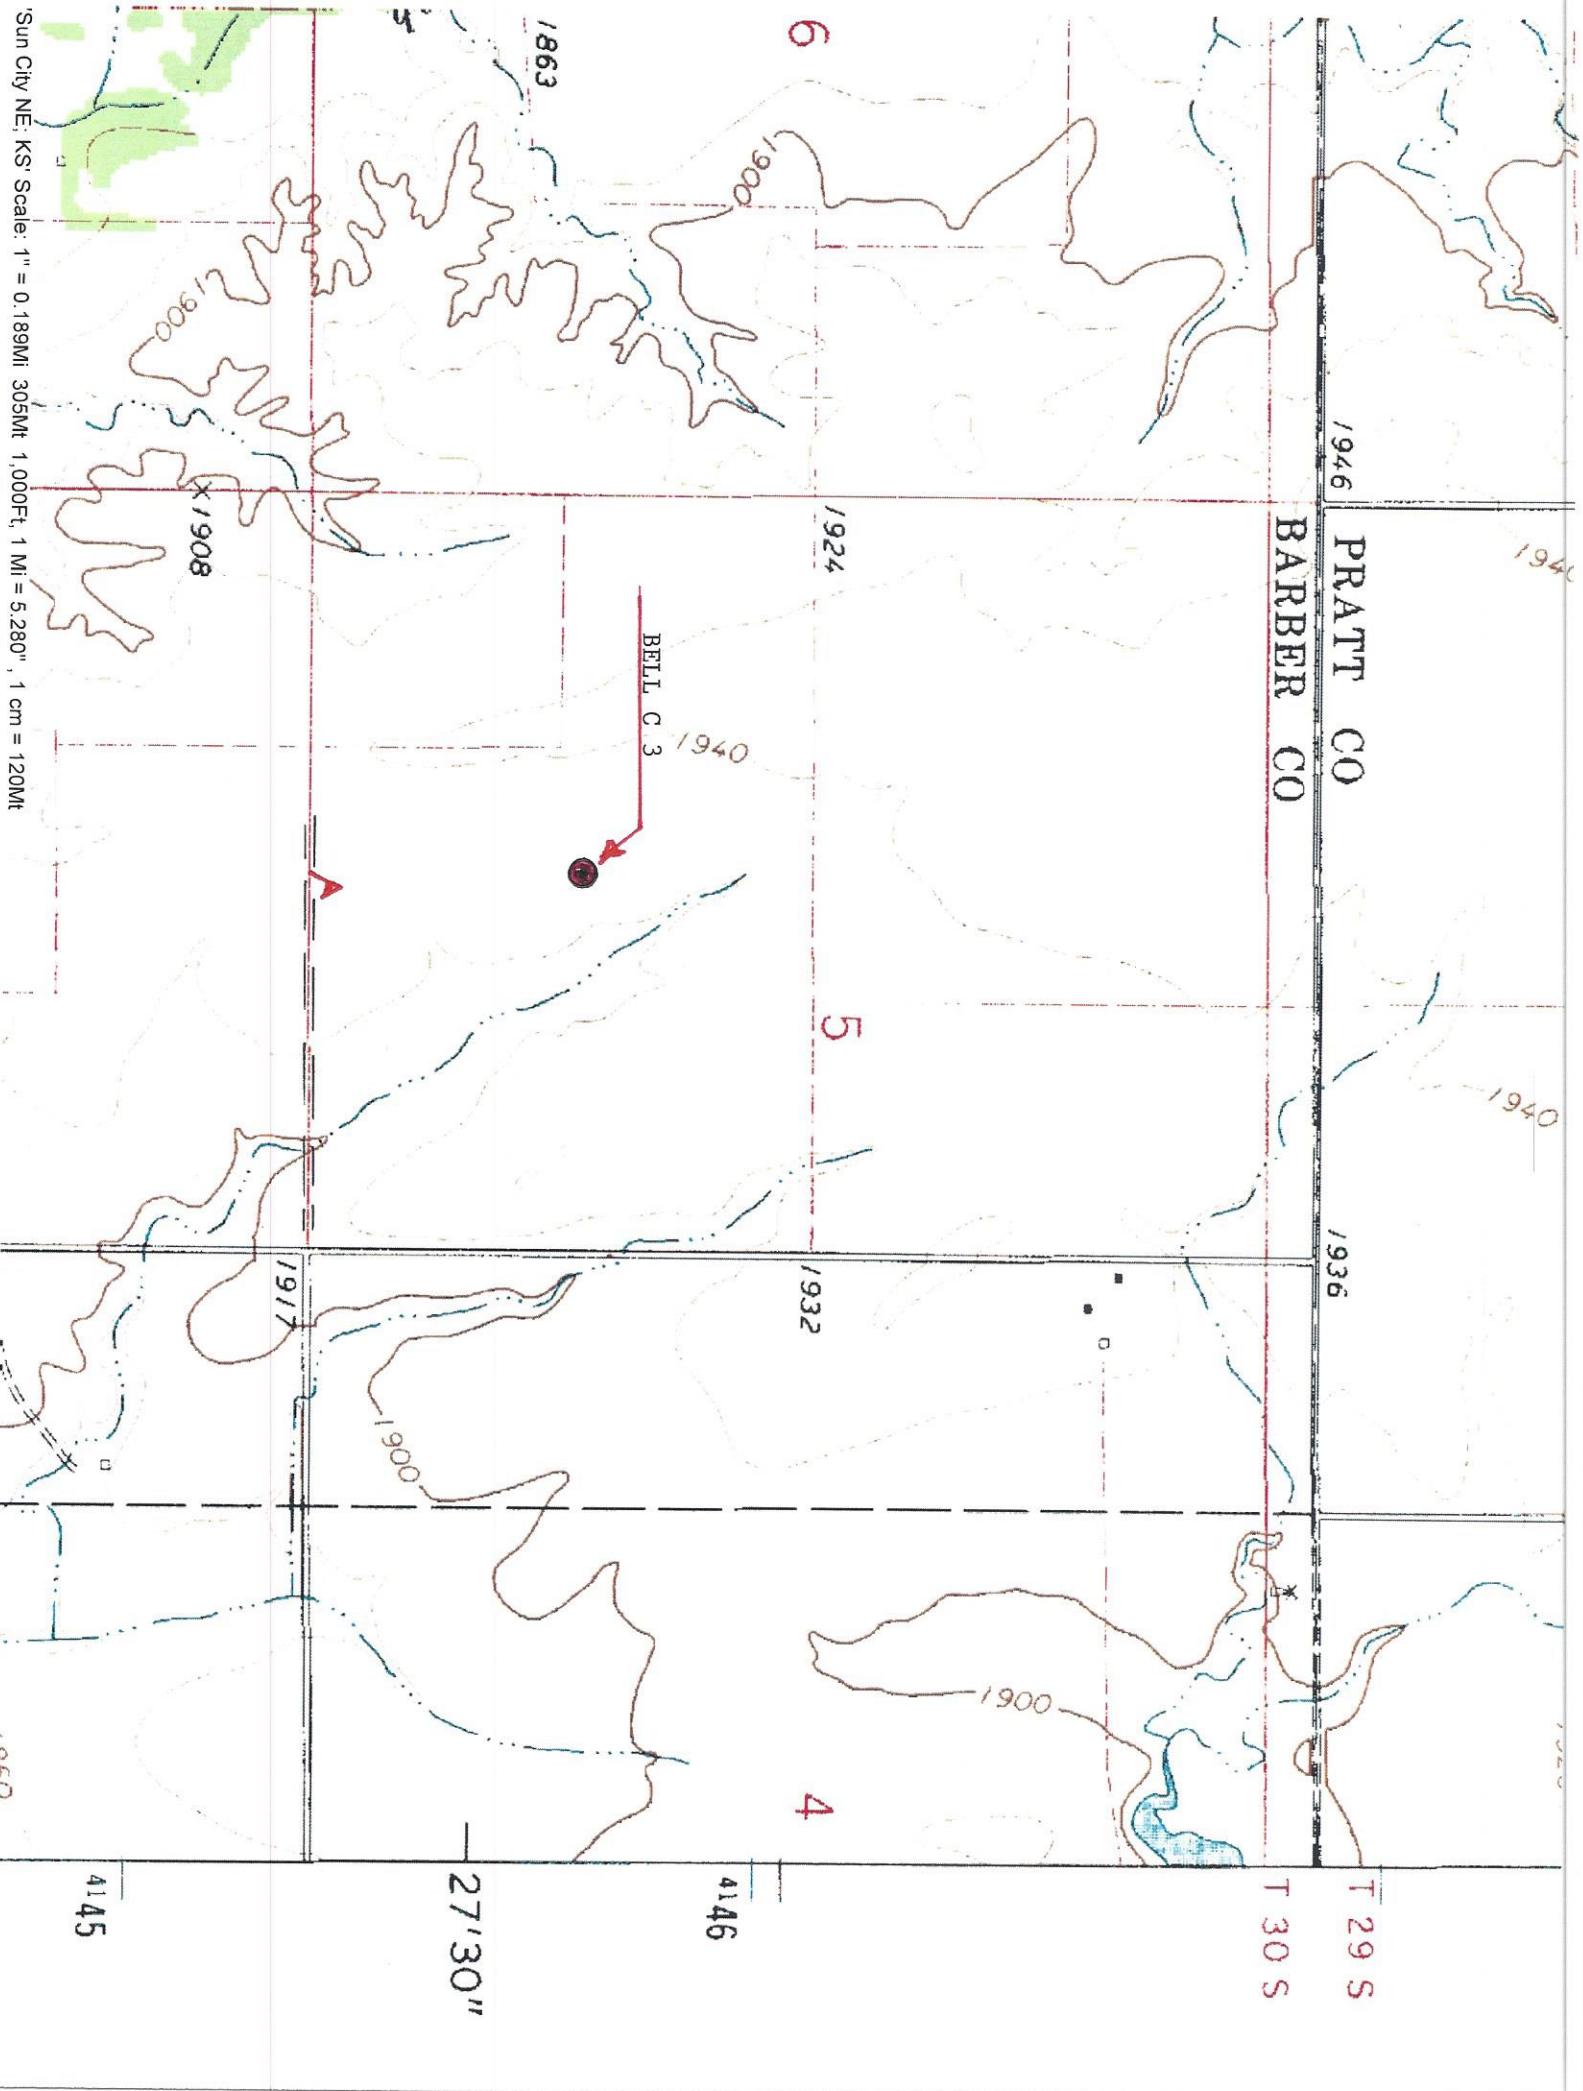

PRATT CO
BARBER CO

1946

1940

1940

1936

6

1924

5

1932

4

1863

1900

1900

X 1908

BELL C 3

1940

1917

1900

1900

4145

27'30"

4146

T 30 S

T 29 S

INDIAN OIL CO INC

BELL C 3


1400' FSL & 3300' FEL OF SEC.

SEC 5-30S-13W

BARBER CO. KS

GPS COORDINATES: NAD83

 37.459915 -98.768159

Legend
 37.459915 -98.768159

Falcon Rd

Pinto Rd