

# ADVANTAGE ELEVATIONS

OIL FIELD SURVEYORS

BOX 8604 - PRATT, KS 67124  
(620) 672-6491

422194  
INVOICE NO.

LOTUS OPERATING CO LLC  
OPERATOR

#2  
NO.

PERKINS  
FARM

PRATT COUNTY      13 29s 15w  
S                      T                      R

165' FSL & 2390' FWL of Sec  
LOCATION


ELEVATION: 1995' GR



LOTUS OPERATING CO LLC  
100 S Main, Ste 420  
Wichita, KS 67202

AUTHORIZED BY: Tim Hellman

SCALE: 1" = 1000'

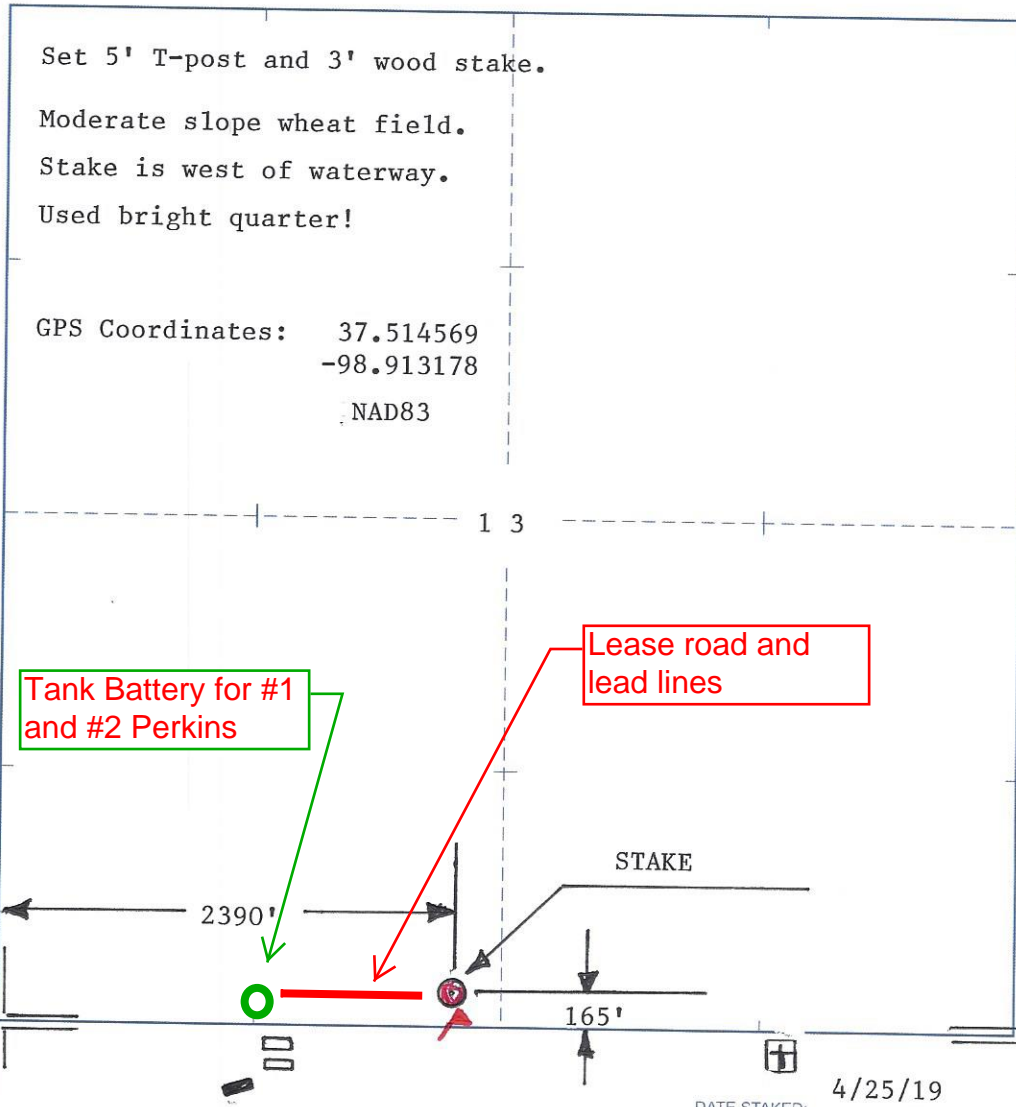

CL  
2016.5 GR


DATE STAKED: 4/25/19      4 mi. east to Coats, KS




# LOTUS OPERATING

PERKINS #2  
165' FSL & 2390' FWL OF SEC.  
PRATT CO, KS  
GPS DATUM: NAD83

## Legend

 37.515036 -98.916872

SW 100th Ave

 37.5145686 -98.91317882

SW 90th St

Google Earth

© 2018 Google

© 2018 Google

