



**Fall & Associates**  
 Stake and Elevation Service  
 P.O. Box 222  
 Pretty Prairie, KS. 67570  
 785-243-7506

Date 5-6-19

Invoice Number 0501191

CHOLLA PRODUCTION, LLC  
 Operator

1-3  
 Number

Zimmerman  
 Farm Name

Rush-KS  
 County-State

3 16s 20w  
 S T R


735'FNL 2065'FWL  
 Location

Cholla Production, LLC  
 10390 Bradford Rd.  
 Suite 201  
 Littleton, CO. 80127

Elevation 2166 Gr.

Ordered By: Emily

Scale 1"=1000'

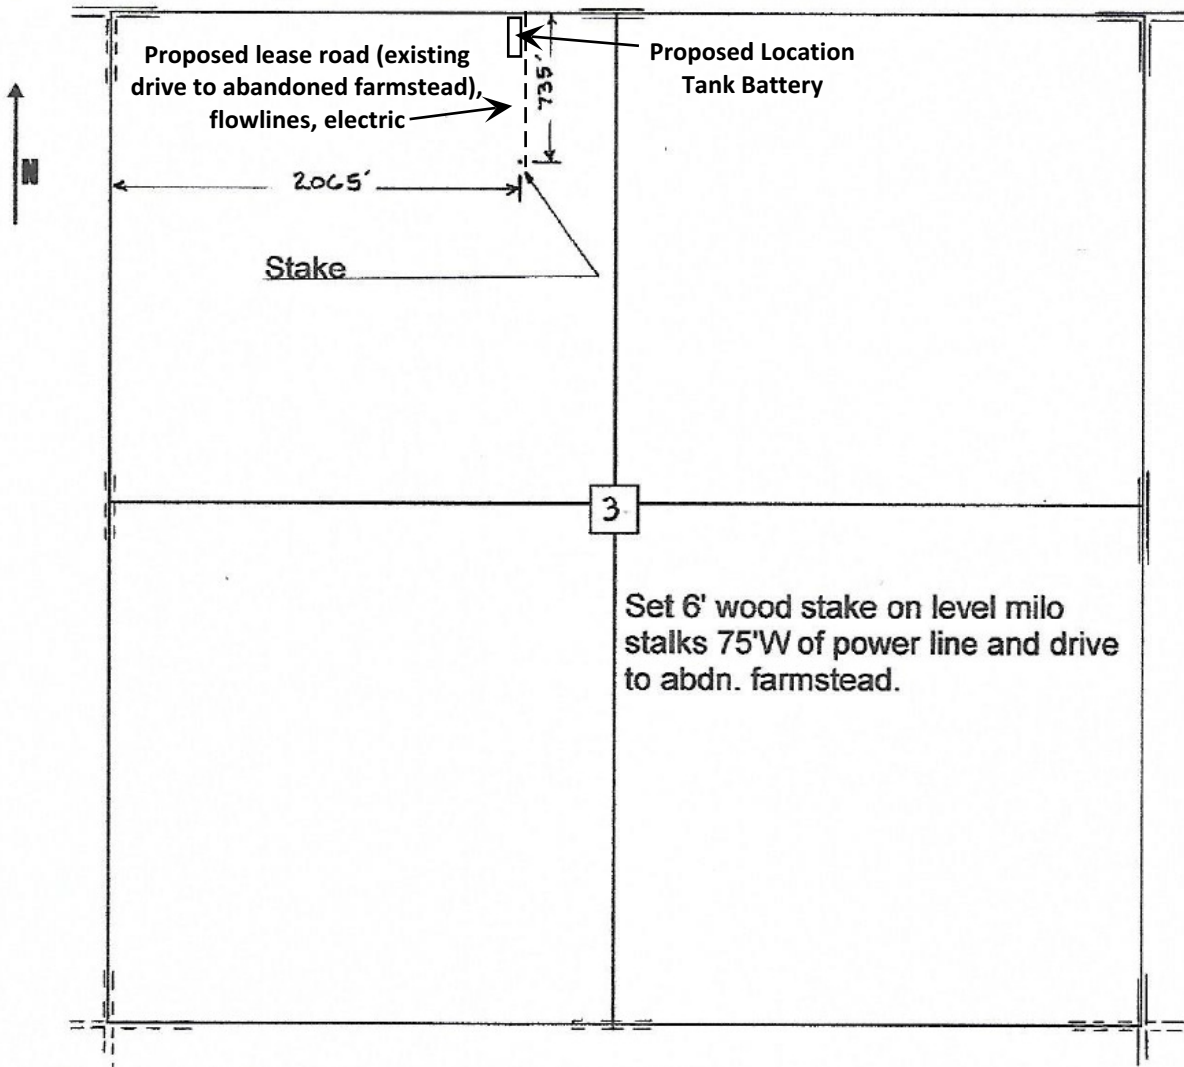

**Cholla Production, LLC - Plat of Proposed Facilities  
 Zimmerman #1-3, Sec.3-16S-20W, Rush County, KS**