



**Fall & Associates**  
 Stake and Elevation Service  
 P.O. Box 222  
 Pretty Prairie, KS. 67570  
 785-243-7506

Date 5-6-19

Invoice Number 0501191

CHOLLA PRODUCTION, LLC

1-3

Zimmerman

Operator

Number

Farm Name

Rush-KS

3

16s

20w

735'FNL 2065'FWL

County-State

S

T

R


Location


Cholla Production, LLC  
 10390 Bradford Rd.  
 Suite 201  
 Littleton, CO. 80127

Elevation 2166 Gr.

Ordered By: Emily

Scale 1"=1000'

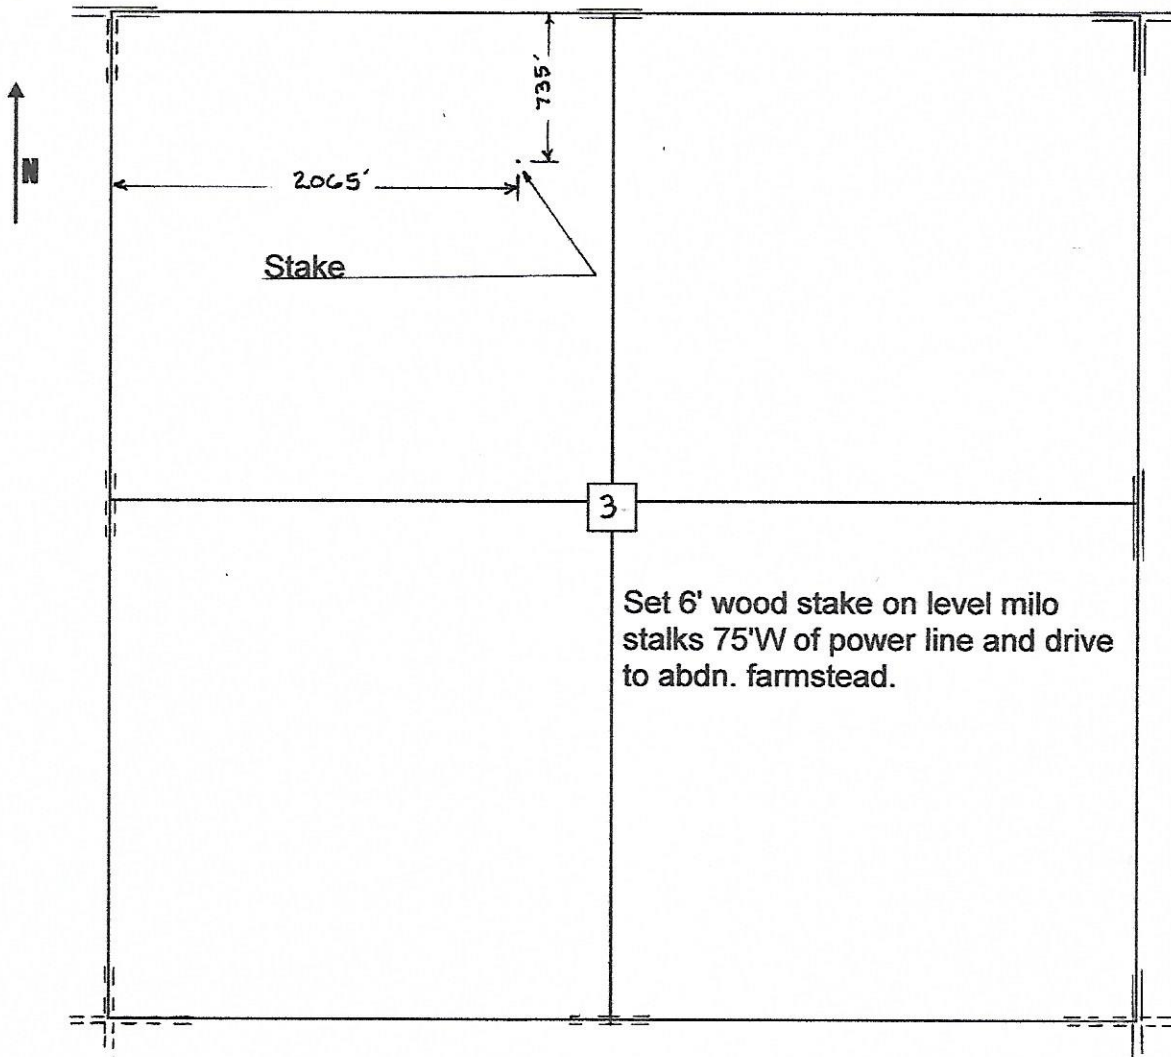

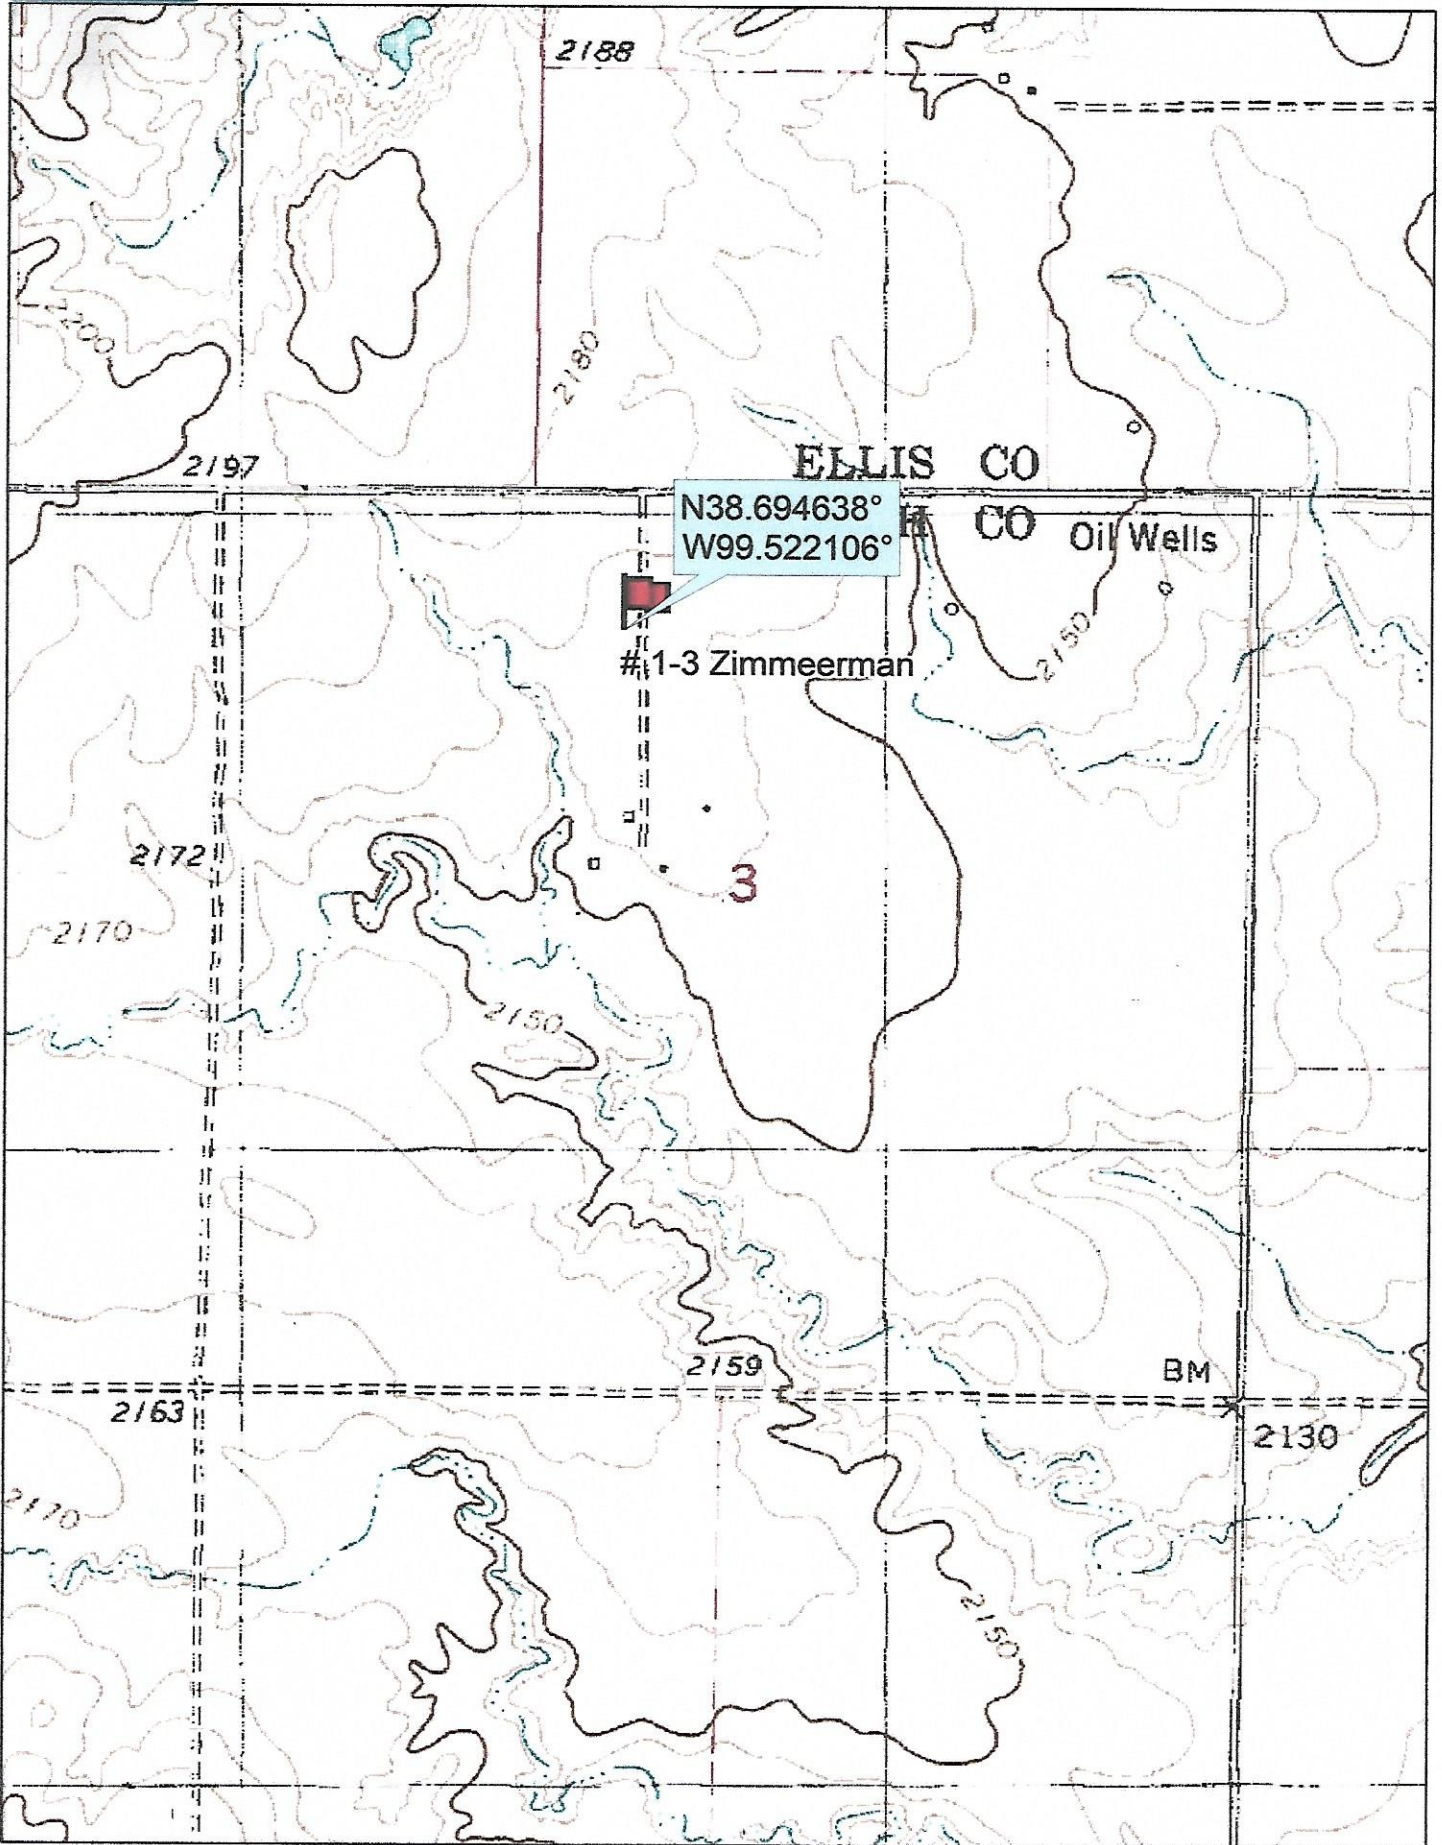


Data use subject to license.

© DeLorme. Topo North America™ 9.

www.delorme.com



Scale 1 : 12,000

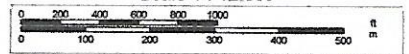

1" = 1,000.0 ft Data Zoom 13-1