


# James P. Williams Enterprises, Inc

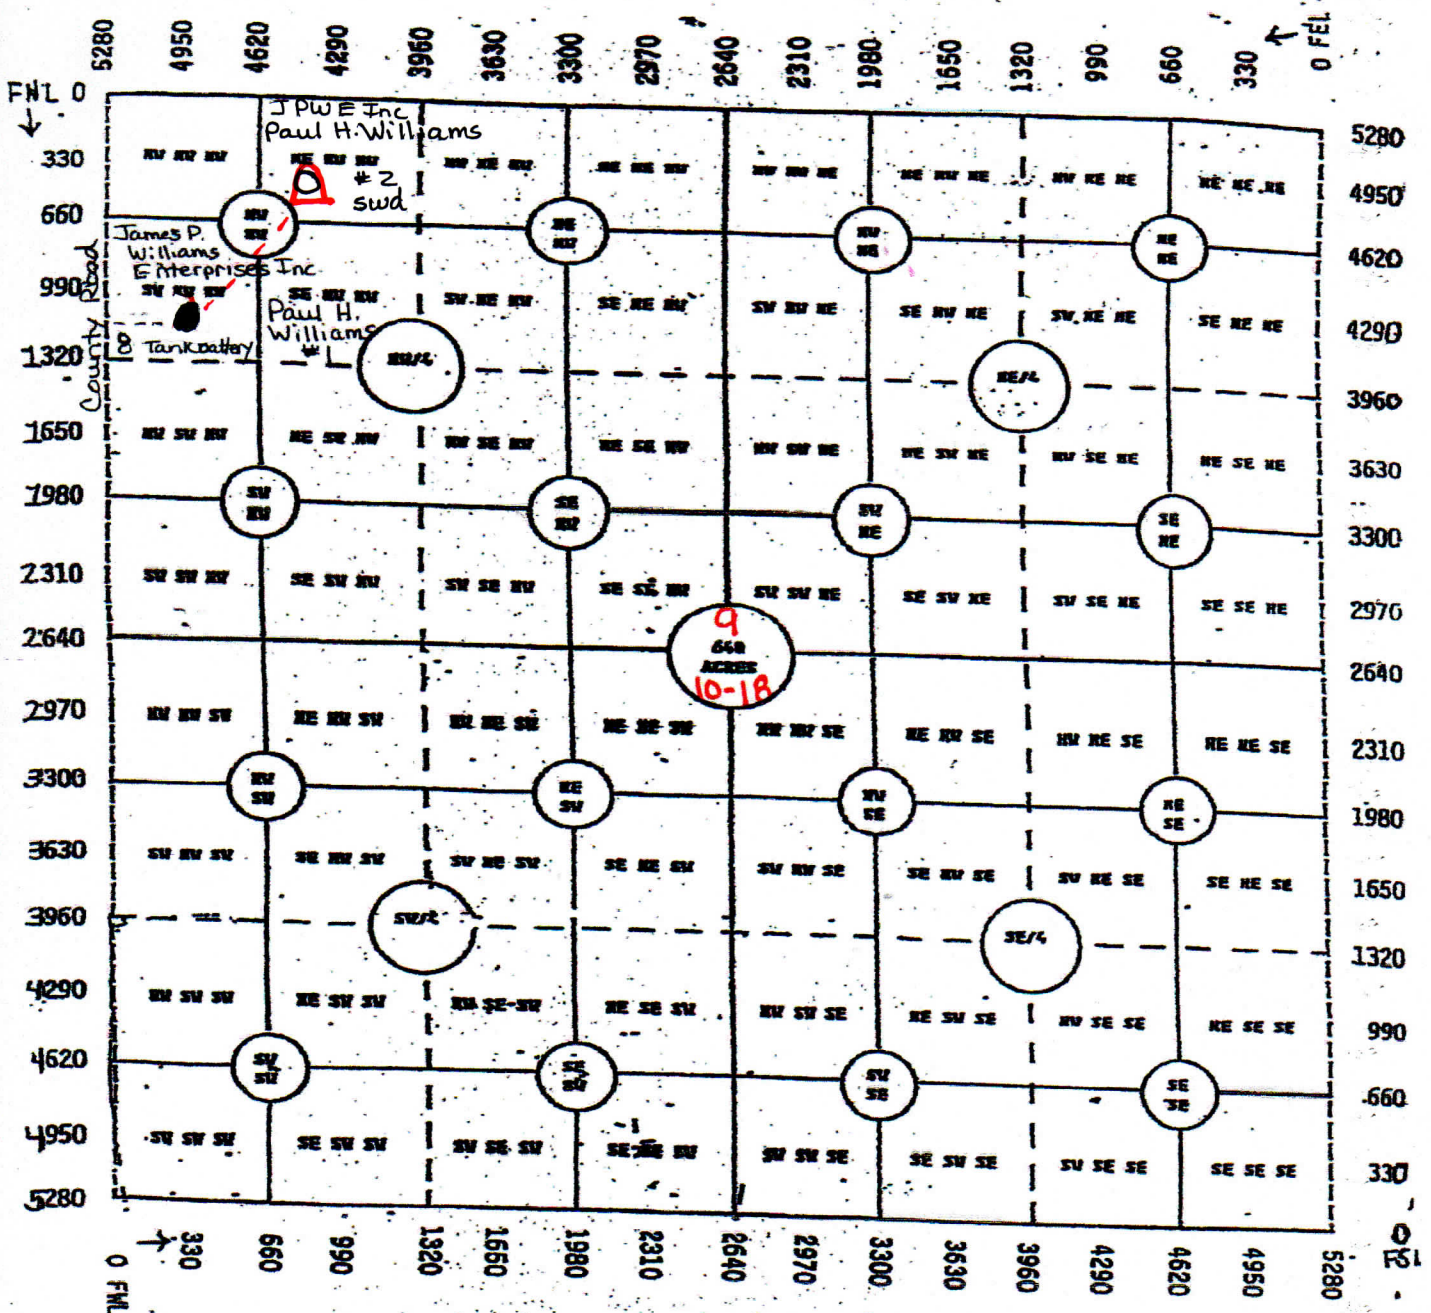

Paul H. Williams #2 (formerly Williams #1)

API # 15-163-23748 - 0001

of S9-T10S-R18W of Rooks County  
Kansas

If OWWO is approved by KCC  
for salt water disposal, a leadline  
will be laid from Paul H. Williams #1  
to Paul H. Williams #2 swd