


[Empty rectangular box]

Township: \_\_\_\_\_ Range: \_\_\_\_\_ County: \_\_\_\_\_ State: \_\_\_\_\_

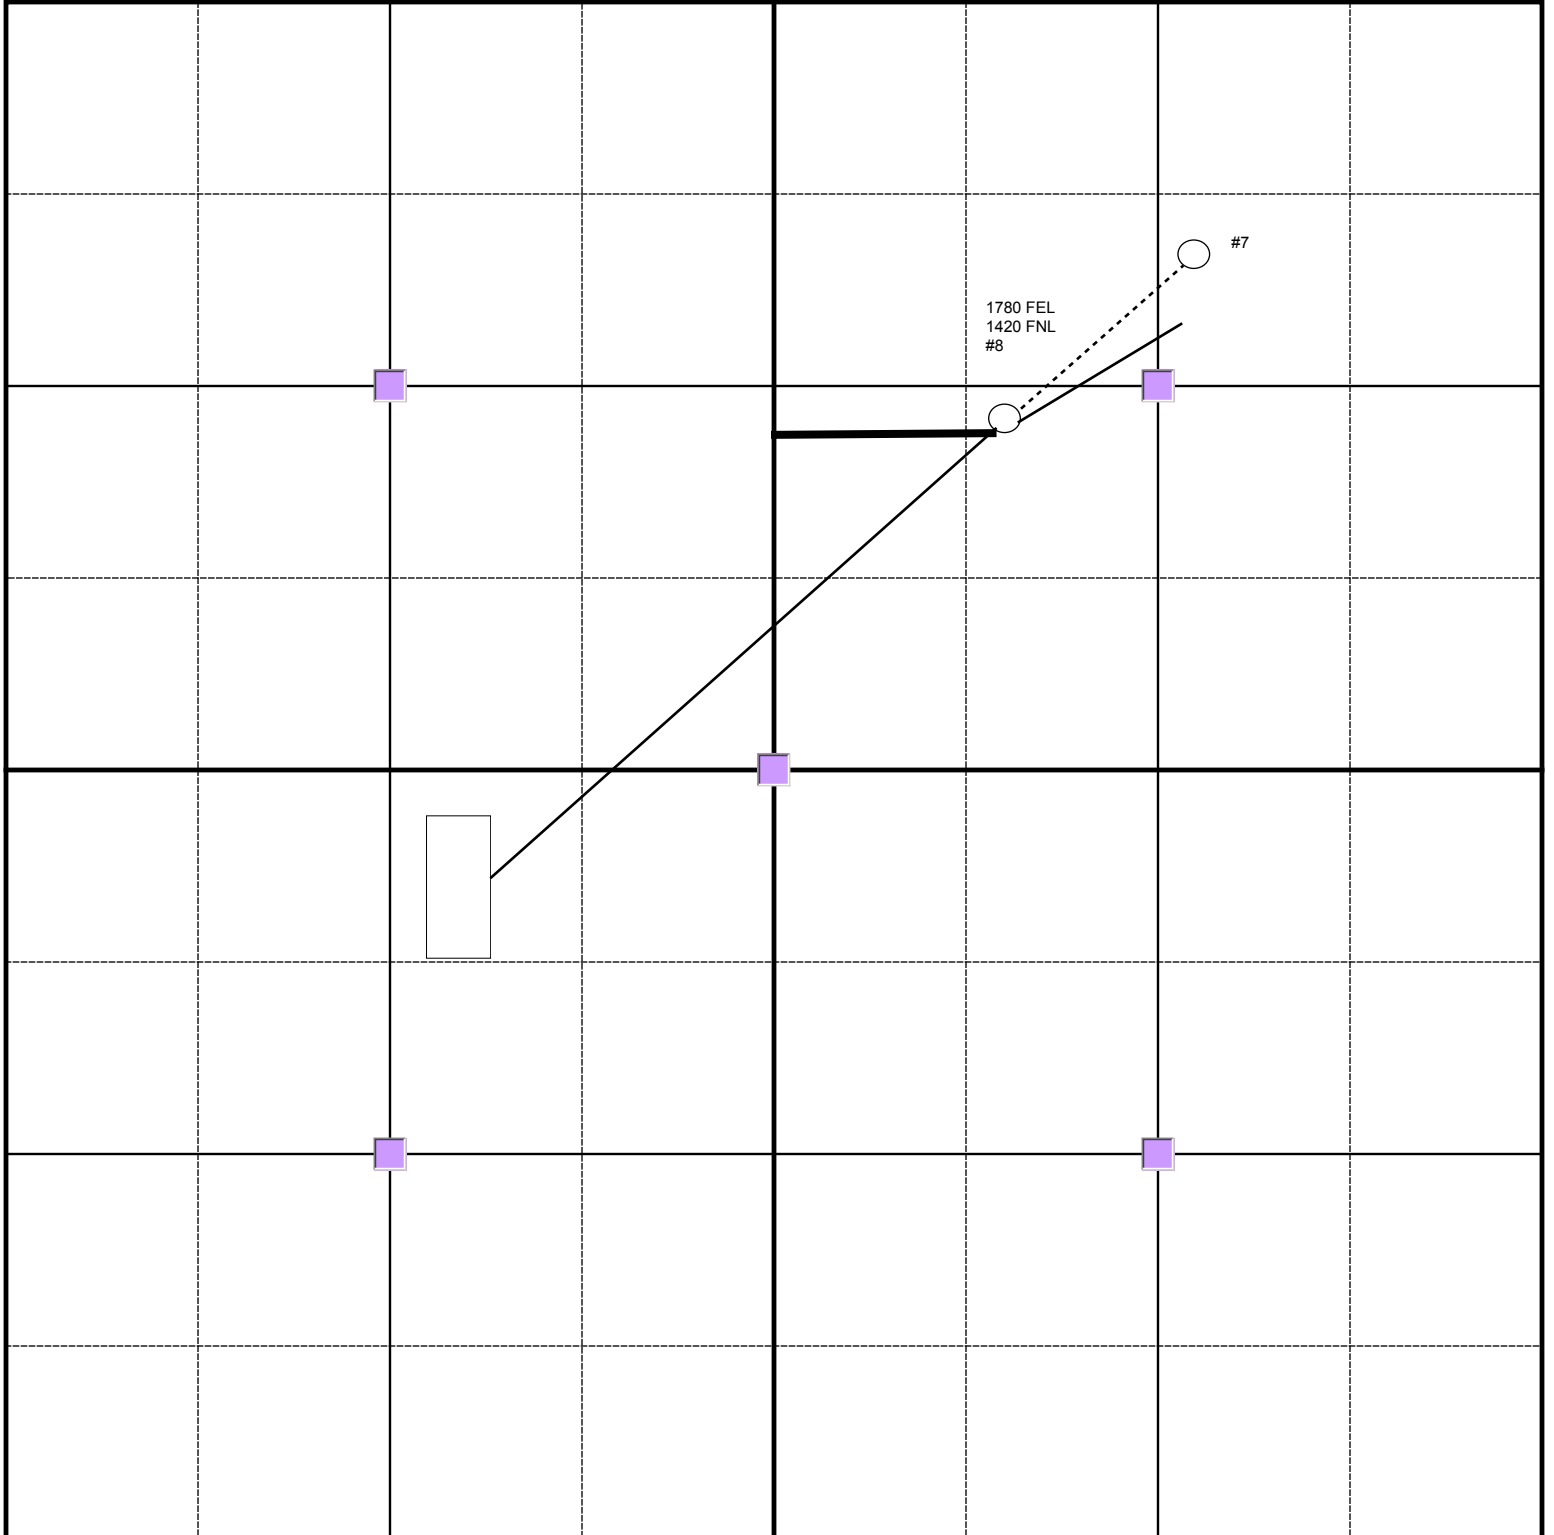

[Rectangle symbol] Tank Battery

[Thick black line symbol] Road

[Thin solid line symbol] Pipeline

[Dashed line symbol] Electric Line