13-16s-38w-K-USGS-T
CRD NO.

00-16s-38w
DMT NO.

PRO-STAKE LLC
Construction Site Staking

P.O. Box 2324 Garden City, Kansas 67846
Office/Fax: (620) 276-6159 – Cell: (620) 272-1499
burt@prostakellc.com

14277
INVOICE NO.

Ritchie Exploration, Inc.
OPERATOR

Wichita County, KS
COUNTY

#1 MJW 10C
LEASE NAME

856′ FSL – 1938′ FWL
LOCATION SPOT

3449.3′
GR ELEVATION

38.672230829
NAD 83 LAT

101.506871150
NAD 83 LONG

10	16s	38w
Sec.	Twp.	Rng.

SCALE: 1″ = 1000′
DATE STAKED: June 4th, 2019
MEASURED BY: Pierce R.
DRAWN BY: Pierce R.
AUTHORIZED BY: Justin C.
DATE REVISED:

N

LEGEND

- irr. well
- water hydrant
- tank battery
- staked loc.
- prod. well / aband. well
- house
- building
- gas line
- water line
- transmission powerline
- 3 phase powerline
- single phase powerline
- fence
- gravel / sand rd.
- gravel trail / lease rd.
- dirt rd.
- dirt trail / lease rd.
- Hwy / blacktop rd.

DIRECTIONS: From Leoti, KS at the intersection of Hwy. 25 & Hwy. 96 – Now go 12.2 miles North on Hwy. 25 – Now go 4.9 miles West on Co. Rd. D – Now go 1 mile North on Co. Rd. 7 – Now go 2 miles West on Co. Rd. C to the SE corner of section 10-16s-38w – Now continue approx. 0.5 miles West on Co. Rd. C to ingress stake North into at trail entrance – Now go approx. 850' North on trail to ingress stake West into – Now go approx. 90' West through dryland wheat, then continue approx. 580' West through irrigated corn stubble with growing corn into staked location

Final ingress must be verified with landowner or operator.

This drawing does not constitute a monumented survey or a land survey plat.
This drawing is for construction purposes only.
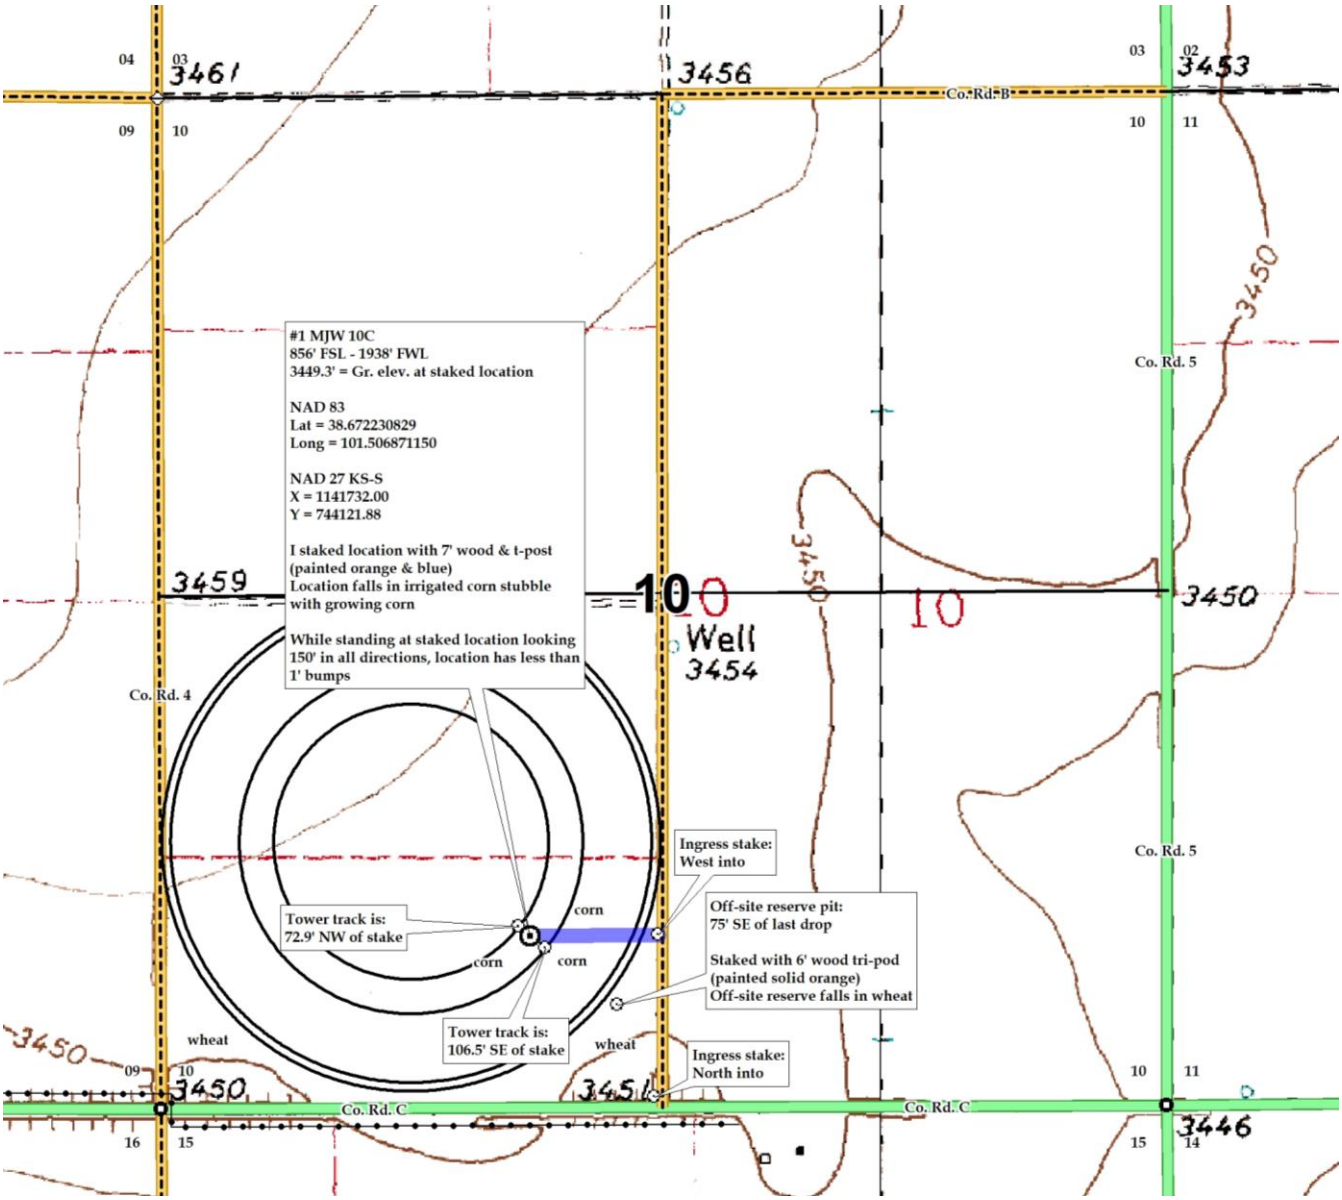
LANDOWNER/CONTACT: Marshall Woodbury: 480-390-8103