

KANSAS CORPORATION COMMISSION  
OIL & GAS CONSERVATION DIVISION

Form ACO-4  
Form must be typed  
March 2009

APPLICATION FOR COMMINGLING OF PRODUCTION (K.A.R. 82-3-123) OR FLUIDS (K.A.R. 82-3-123a) *Commingling ID #* \_\_\_\_\_

OPERATOR: License # \_\_\_\_\_ API No. 15 - \_\_\_\_\_  
Name: \_\_\_\_\_ Spot Description: \_\_\_\_\_  
Address 1: \_\_\_\_\_ - - - - - Sec. \_\_\_\_\_ Twp. \_\_\_\_\_ S. R. \_\_\_\_\_  East  West  
Address 2: \_\_\_\_\_ Feet from  North /  South Line of Section  
City: \_\_\_\_\_ State: \_\_\_\_\_ Zip: \_\_\_\_\_ + \_\_\_\_\_ Feet from  East /  West Line of Section  
Contact Person: \_\_\_\_\_ County: \_\_\_\_\_  
Phone: ( \_\_\_\_\_ ) \_\_\_\_\_ Lease Name: \_\_\_\_\_ Well #: \_\_\_\_\_

1. Name and upper and lower limit of each production interval to be commingled:  
Formation: \_\_\_\_\_ (Perfs): \_\_\_\_\_  
Formation: \_\_\_\_\_ (Perfs): \_\_\_\_\_  
Formation: \_\_\_\_\_ (Perfs): \_\_\_\_\_  
Formation: \_\_\_\_\_ (Perfs): \_\_\_\_\_  
Formation: \_\_\_\_\_ (Perfs): \_\_\_\_\_

2. Estimated amount of fluid production to be commingled from each interval:  
Formation: \_\_\_\_\_ BOPD: \_\_\_\_\_ MCFPD: \_\_\_\_\_ BWPD: \_\_\_\_\_  
Formation: \_\_\_\_\_ BOPD: \_\_\_\_\_ MCFPD: \_\_\_\_\_ BWPD: \_\_\_\_\_  
Formation: \_\_\_\_\_ BOPD: \_\_\_\_\_ MCFPD: \_\_\_\_\_ BWPD: \_\_\_\_\_  
Formation: \_\_\_\_\_ BOPD: \_\_\_\_\_ MCFPD: \_\_\_\_\_ BWPD: \_\_\_\_\_  
Formation: \_\_\_\_\_ BOPD: \_\_\_\_\_ MCFPD: \_\_\_\_\_ BWPD: \_\_\_\_\_

3. Plat map showing the location of the subject well, all other wells on the subject lease, and all wells on offsetting leases within a 1/2 mile radius of the subject well, and for each well the names and addresses of the lessee of record or operator.

4. Signed certificate showing service of the application and affidavit of publication as required in K.A.R. 82-3-135a.

**For Commingling of PRODUCTION ONLY, include the following:**

- 5. Wireline log of subject well. Previously Filed with ACO-1:  Yes  No
- 6. Complete Form ACO-1 (*Well Completion form*) for the subject well.

**For Commingling of FLUIDS ONLY, include the following:**

- 7. Well construction diagram of subject well.
- 8. Any available water chemistry data demonstrating the compatibility of the fluids to be commingled.

**AFFIDAVIT:** I am the affiant and hereby certify that to the best of my current information, knowledge and personal belief, this request for commingling is true and proper and I have no information or knowledge, which is inconsistent with the information supplied in this application.

Submitted Electronically

**KCC Office Use Only**  
 Denied  Approved  
15-Day Periods Ends: \_\_\_\_\_  
Approved By: \_\_\_\_\_ Date: \_\_\_\_\_

*Protests may be filed by any party having a valid interest in the application. Protests must be in writing and comply with K.A.R. 82-3-135b and must be filed within 15 days of publication of the notice of application.*

# LEGAL PROOF OF PUBLICATION

Account #	Ad Number	Identification	PO	Amount	Cols	Lines
731422	0004258110	Re: This is an Application for Commingling Produ	ACO4 Application	\$185.77	1	31

**Attention:** Stephen W. Marden

MAREXCO, INC.  
 P.O. BOX 21598  
 OKLAHOMA CITY, OK 73156

Re: This is an Application for  
 Commingling Production (ACO4) of the  
 Lundgren #32-28 oil well, located in NE  
 SE SW NE/4 of Section 28, 14S-29W,  
 Gove County, Kansas.

To: All Oil and Gas Producers, Unleased  
 Mineral Interest owners, landowners and  
 all persons whomever are concerned.

You and each of you are hereby informed  
 that MAREXCO, Inc. is filing an ACO4 ap-  
 plication to Commingle Production in the  
 Lundgren #32-28 oil well. This will be  
 from the depths of 4216-4218', the Chero-  
 kee Limestone Formation, and from 3708-  
 3714', the Lansing 'B' Formation. The pro-  
 duction rate is 45 BOPD with no water.  
 Any person who objects to or protests this  
 application shall be required to file their  
 objections or protests with the Conserva-  
 tion Division of the State Corporation  
 Commission of the state of Kansas within  
 (30) days from the date of this publica-  
 tion. These protests shall be filed pursuant  
 to Commission regulations and must state  
 specific reasons why the grant of the ap-  
 plication may cause waste, violate correla-  
 tive rights, or pollute the natural resources  
 of the State of Kansas.

All persons interested or concerned shall  
 take notice of the foregoing and shall gov-  
 ern themselves accordingly.

In The STATE OF KANSAS  
 In and for the County of Sedgwick  
 AFFIDAVIT OF PUBLICATION

1 Insertions

Beginning issue of: 06/17/2019

Ending issue of: 06/17/2019

STATE OF KANSAS)

.SS

County of Sedgwick)

Dale Seiwert, of lawful age, being first duly  
 sworn, deposeth and saith: That he is  
 Record Clerk of The Wichita Eagle, a daily  
 newspaper published in the City of Wichita,  
 County of Sedgwick, State of Kansas, and  
 having a general paid circulation on a daily  
 basis in said County, which said  
 newspaper has been continuously and  
 uninterruptedly published in said County for  
 more than one year prior to the first  
 publication of the notice hereinafter  
 mentioned, and which said newspaper has  
 been entered as second class mail matter  
 at the United States Post Office in Wichita,  
 Kansas, and which said newspaper is not a  
 trade, religious or fraternal publication and  
 that a notice of a true copy is hereto  
 attached was published in the regular and  
 entire Morning issue of said The Wichita  
 Eagle from 6/17/2019 to 06/17/2019.

I certify (or declare) under the penalty of  
 perjury that the foregoing is true and correct.



(Signature of Principal Clerk)

DATED: 6/17/2019

  
 Notary Public Sedgwick County, Kansas

JENNIFER RAE BAILEY  
 Notary Public - State of Kansas  
 My Appt. Expires 6/19/2021

**AFFIDAVIT OF PUBLICATION**

State of Kansas,  
Gove County, ss:

Frank Mercer \_\_\_\_\_  
being first duly sworn, deposes and  
says: That he is  
**Publisher** of

**Gove County Advocate**, a weekly newspaper printed in the State of Kansas, and published in and of general circulation in Gove County, Kansas, with a general paid circulation on a weekly basis in Gove County, Kansas, and that said newspaper is not a trade, religious or fraternal publication.

Said newspaper is a weekly published at least 50 times a year; and has been so published continuously and uninterruptedly in said county and state for a period of more than five years prior to the first publication of said notice; and has been admitted at the post office in Quinter in said county as periodical class mail-matter.

That the attached notice is a true copy thereof and was published in the regular and entire issue of said newspaper for 1 consecutive week(s), the first publication thereof being made as aforesaid on the 19 day of June, 19, with subsequent publications being made on the following dates:

\_\_\_\_\_  
\_\_\_\_\_  
\_\_\_\_\_  
\_\_\_\_\_

Printer's Fee ..... \$ 35.07  
Additional Copies ..... \$ \_\_\_\_\_  
Affidavit Fees ..... \$ 2.05  
Total Publication Fees \$ 37.12

Subscribed and sworn to before me this \_\_\_\_\_ day of \_\_\_\_\_, \_\_\_\_\_  
*[Signature]*  
Notary Public  
My commission expires: Aug 3-2020



**LEGAL ADVERTISING**

(Published in the Gove County Advocate, Quinter, KS, Wed., June 19, 2019 - 1t)

**Notice of Application**

Re: This is an Application for Commingling Production (ACO4) of the Lundgren #32-28 oil well, located in NE SE SW NE/4 of Section 28, 14S-29W, Gove County, Kansas.

To: All Oil and Gas Producers, Unleased Mineral Interest owners, landowners and all persons whomever are concerned.

You and each of you are hereby informed that MAREXCO, Inc. is filing an ACO4 application to Commingle Production in the Lundgren #32-28 oil well. This will be from the depths of 4216-4218', the Cherokee Limestone Formation, and from 3708-3714', the Lansing 'B' Formation. The production rate is 45 BOPD with no water. Any person who objects to or protests this application shall be required to file their objections or protests with the Conservation Division of the State Corporation Commission of the state of Kansas within (30) days from the date of this publication. These protests shall be filed pursuant to Commission regulations and must state specific reasons why the grant of the application may cause waste, violate correlative rights, or pollute the natural resources of the State of Kansas.

All persons interested or concerned shall take notice of the foregoing and shall govern themselves accordingly.

**Stephen W. Marden**  
MAREXCO, Inc.  
P.O. Box 21598  
Oklahoma City, OK 73156  
(405) 696-5644  
stevemarden@att.net

June 27, 2019

Mr. Darrel Lundgren  
4003 CR I  
Gove, KS 67736

Re: NW/4 Section 27, 14S-29W  
SW/4 Section 27, 14S-29W  
Gove County, Kansas

Dear Mr. Lundgren,

This letter is to notify you that MAREXCO, Inc. is in the process of filing an ACO-4 form with the Kansas Corporation Commission of Kansas for the purpose of commingling production from more than one producing zone in the Lundgren #32-28, NE SE SW NE/4 of Section 28, 14S-29W, Gove County, Kansas.

As a mineral owner of land that is within one half mile of the Lundgren #32-28 well, we are required to notify you of this information.

Enclosed is a copy of the notice that was published in the Gove County Advocate on June 19, 2019.

Sincerely,

Stephen W. Marden  
MAREXCO, Inc.


SWM:cm  
Enclosure



# Kansas Oil and Gas

Kansas Geological Survey


Statewide View | Zoom to Location | Filter Wells | Label Wells | Download Wells | Print to PDF | Clear Highlight |

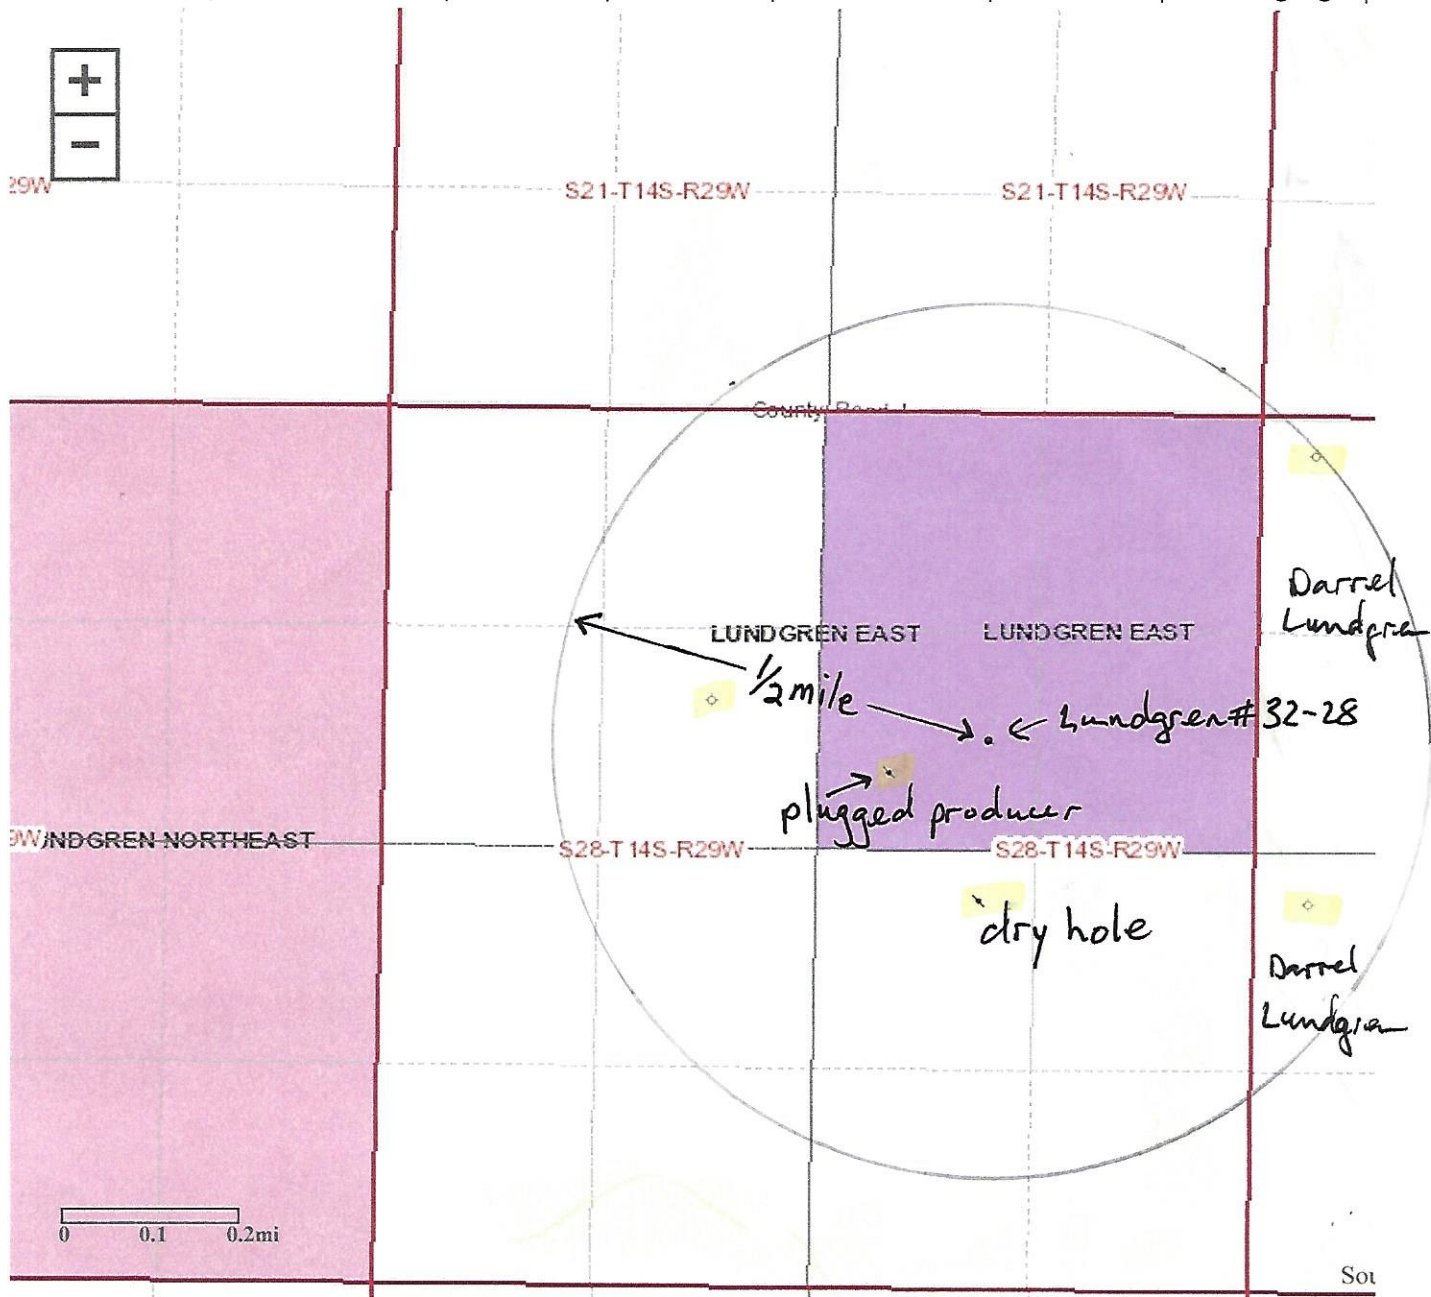

# Kansas Oil and Gas

Kansas Geological Survey

Statewide View | Zoom to Location | Filter Wells | Label Wells | Download Wells | Print to PDF | Clear Highlight |

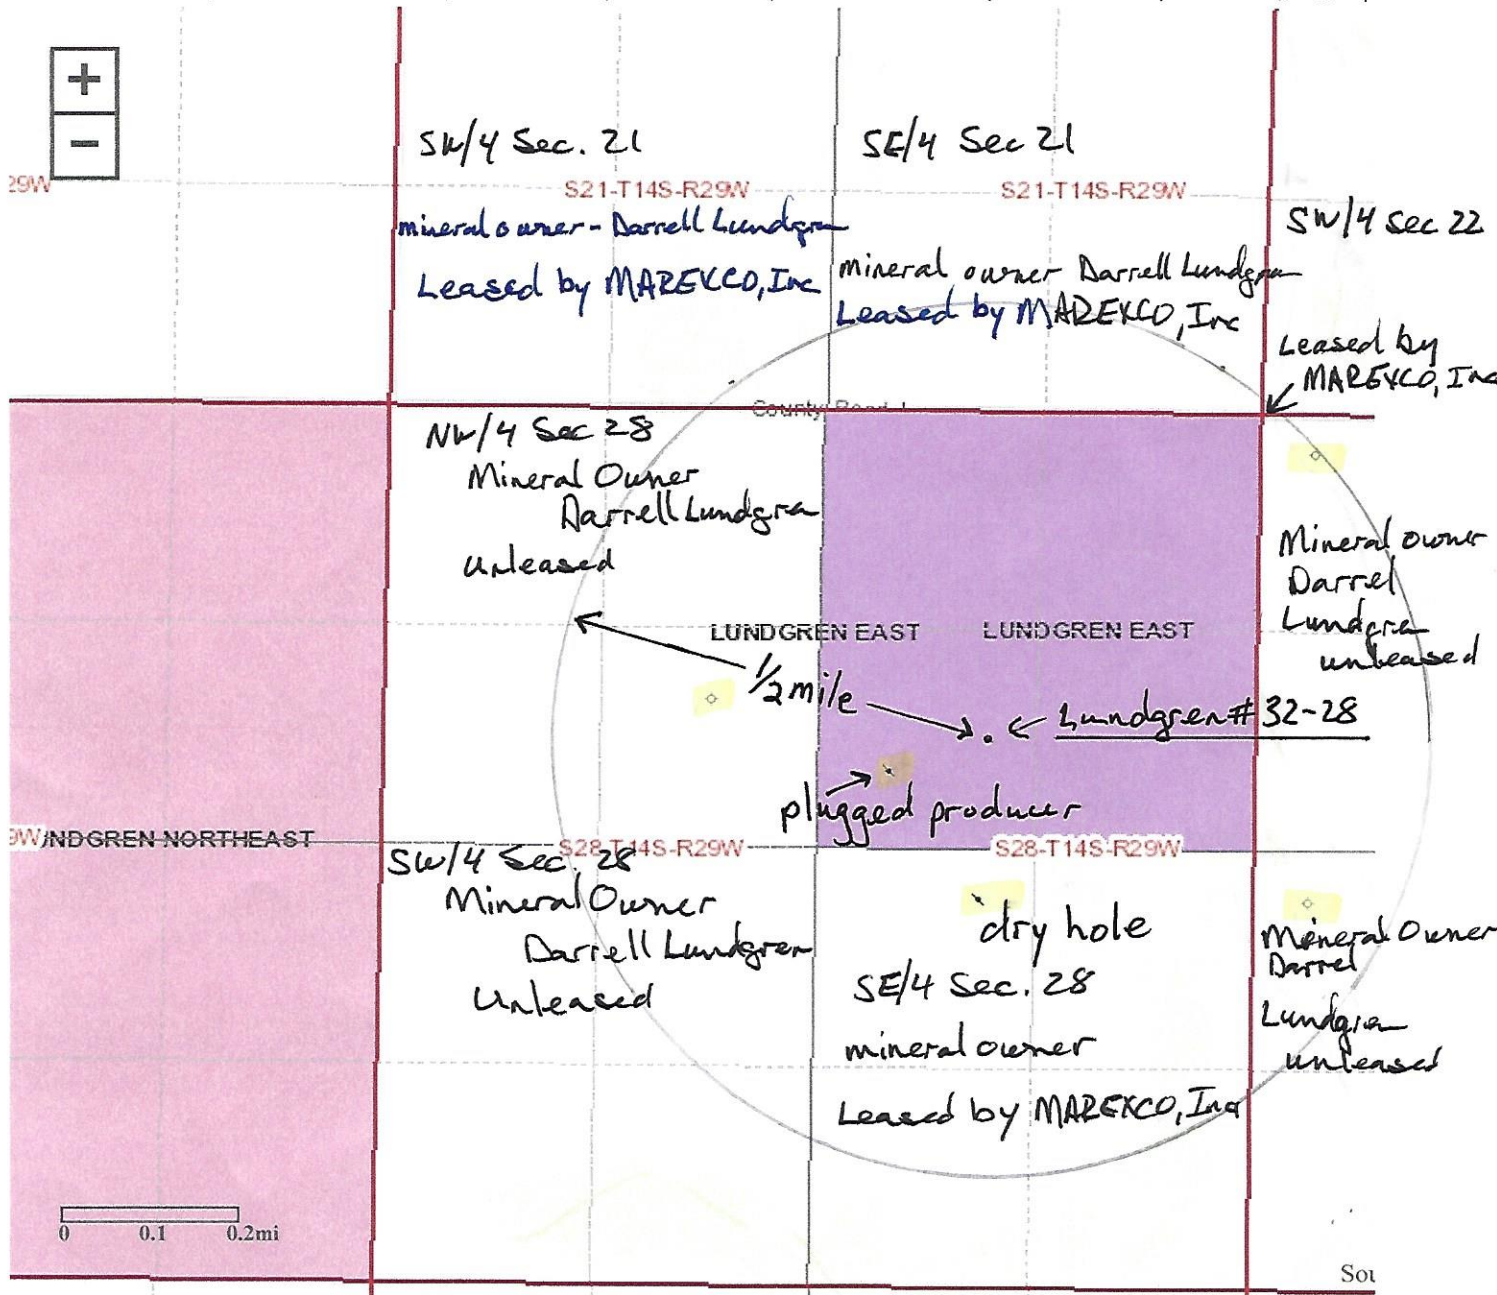

Conservation Division  
266 N. Main St., Ste. 220  
Wichita, KS 67202-1513



Phone: 316-337-6200  
Fax: 346-337-6211  
<http://kcc.ks.gov/>

Dwight D. Keen, Chair  
Shari Feist Albrecht, Commissioner  
Susan K. Duffy, Commissioner

Laura Kelly, Governor

July 12, 2019

Marexco, Inc.  
PO Box 21598  
Oklahoma City, OK 73156-1598

RE: Approved Commingling CO071916  
Lundgren 32-28  
API No. 15-063-22343-00-00

Dear Mr. Marden:

Your Application for Commingling (ACO-4) for the above described well has been reviewed and approved by the Kansas Corporation Commission (KCC) per K.A.R. 82-3-123. Notice was examined and found to be proper per K.A.R. 82-3-135a. No protest had been filed within the 15-day protest period.

Based upon the depth of the Cherokee Lime formation perforations, total oil production shall not exceed 200 BOPD and total gas production shall not exceed 50% of the absolute open flow (AOF).

Sincerely,

Rick Hestermann  
Production Department