KOLAR Document ID: 1464332

KANSAS CORPORATION COMMISSION OIL & GAS CONSERVATION DIVISION

Form CP-111 July 2017 Form must be Typed Form must be signed

TEMPORARY ABANDONMENT WELL APPLICATION

All blanks must be complete

Phone 620.902.6450

Phone 785.261.6250

				I			
OPERATOR: License#				API No. 15			
Name:					ription:		
Address 1:							R
Address 2:				1			I / S Line of Section W Line of Section
City:	State:	Zip: +			ion: Lat:		
Contact Person:				Datum:	(e.g. xx.xxxx) NAD27 NAD83	x) WGS84	(e.gxxx.xxxxx)
Phone:()							GL
Contact Person Email:				Lease Nan	ne:	We	II #:
Field Contact Person:							Other:
Field Contact Person Phone	e:()_						mit #:
	,				orage Permit #: :		
				Spud Date		Date Shut-in	
	Conductor	Surface	Pro	oduction	Intermediate	Liner	Tubing
Size							
Setting Depth							
Amount of Cement							
Top of Cement							
Bottom of Cement							
Casing Fluid Level from Su	rface:	How D	etermined?				Date:
Casing Squeeze(s):							
		_		(top)	(bottom)		
Do you have a valid Oil & G							
Depth and Type:	in Hole at	Tools in Hole at	Ca	sing Leaks:	Yes No Depth of	f casing leak(s):	
Type Completion: ALT							
Packer Type:						(depth)	
Total Depth:	Plug Bad	ck Denth:		Plug Back Meth	ood:		
	ug 2	<u></u>					
Geological Date:							
Formation Name	Formation	Top Formation Base			Completion I	nformation	
1	At:	to Fee	et Perfo	ration Interval	to Fee	t or Open Hole Interv	al toFeet
2	At:	to Fee	et Perfo	ration Interval	to Fee	t or Open Hole Interv	al toFeet
LINDED DENALTY OF DE	O ILIDV I LIEDEDV ATTE	CT TUAT TUE INCODM	IATION CO	NTAINED HE	DEIN IS TOLIE AND COL		OE MV KNOW! EDGE
		Submit	ted Ele	ctronical	У		
Do NOT Write in This	Date Tested:		Results:		Date Plugged:	Date Repaired: Da	te Put Back in Service:
Space - KCC USE ONLY			results.		Date i lugged.	Date Repaired. Da	te i ut back in dervice.
•							
Review Completed by:			Comr	nents:			
TA Approved: Yes	Denied Date:						
		Mail to the Ap	propriate	KCC Conser	vation Office:		
Strains Spine Street State State State and Spines w	KCC Distr	ict Office #1 - 210 E. Fro	ontview, Su	ite A, Dodge C	ity, KS 67801		Phone 620.682.7933
					Suite 601, Wichita, KS 6	7226	Phone 316.337.7400

KCC District Office #3 - 137 E. 21st St., Chanute, KS 66720

KCC District Office #4 - 2301 E. 13th Street, Hays, KS 67601-2651



Well Name: Dale #1

State: KS County: Scott

Operator: NGO


Field: White & Ellis
API: 15-171-20810

API: 15-171-20810 Location: 1400' FSL 1175' FWL Section 33-T17S-R34W

Elevations		Dir	rectional Data		
	RKB	3147	KOP		RKB
	DF		Max DEV	0	RKB
	GL	3137	Max Dogleg	0	RKB
		-	Dev @ Perfs	0	RKB
Section 33-T17S-R34W			Return to Vertical		RKB

Last Update: 1/30/2017 Schematic AS OF Date: 6/10/2014

Spud 6/16/2011 TD: 6/28/2011 Completion: 6/30/2011

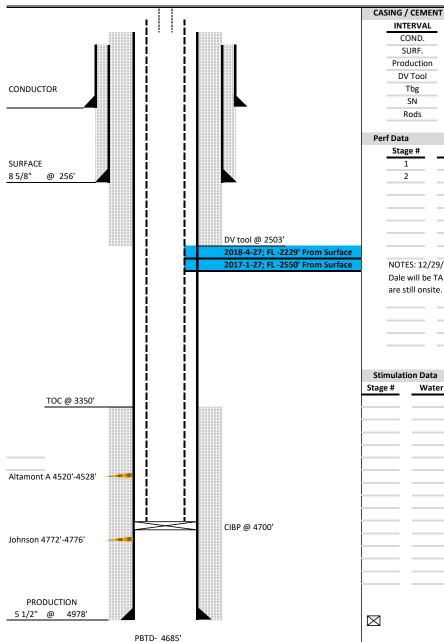

Total Depth Drilled- 4980'

NG / CEMENT									
INTERVAL	HOLE	CSG	WT.	GR.	Depth Top	Depth Btm	LENGTH	CMT	TOC
COND.	-			-	<u> </u>				
SURF.	12.25"	8 5/8"	24#	J-55	•	256'		180 sx	
Production	7.625"	5 1/2"	15.5#		•	4978'		400 sx	
DV Tool									
Tbg									
SN									
Rods									

Stage #	Formation	Top Perf	Btm Perf	Length	Net ft	SPF	Total Holes
1	Johnson	4,772'	4,776'	4'	4'	6	24
2	Altamont A	4,520'	4,528'	8'	8'	6	48
							-

Dale will be TA in Janauray 2017, pumping unit went to the Sowers 1-5, tubing and rods went to the Riedel 2-5, the tanks are still onsite.

Stimulat	ion Data							
Stage #	Water	Proppant	Acid	Avg R	Max R	Avg P	ISIP	FG
								_

Conservation Division District Office No. 1 210 E. Frontview, Suite A Dodge City, KS 67801



Phone: 620-682-7933 http://kcc.ks.gov/

Laura Kelly, Governor

Dwight D. Keen, Chair Shari Feist Albrecht, Commissioner Susan K. Duffy, Commissioner

July 02, 2019

Dillan Carney Culbreath Oil & Gas Company, Inc. 3501 S YALE AVE TULSA, OK 74135-8014

Re: Temporary Abandonment API 15-171-20810-00-00 DALE 1 SW/4 Sec.33-17S-34W Scott County, Kansas

Dear Dillan Carney:

"Your temporary abandonment (TA) application for the well listed above has been approved. In accordance with K.A.R. 82-3-111 the TA status of this well will expire 07/02/2020.

- * If you return this well to service or plug it, please notify the District Office.
- * If you sell this well you are required to file a Transfer of Operator form, T-1.
- * If the well will remain temporarily abandoned, you must submit a new TA application, CP-111, before 07/02/2020.

You may contact me at the number above if you have questions.

Very truly yours,

Scott Alberg"