


PATTERSON ENERGY, LLC
J.L. RUMSEY LEASE
NE.1/4, SECTION 23, T11S, R17W
ELLIS COUNTY, KANSAS

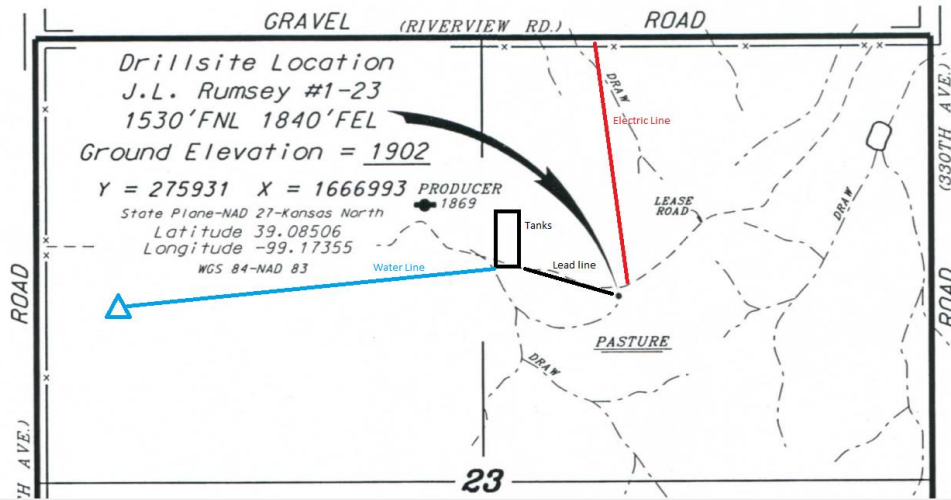

Location as shown on this
and may not be legally
Contract landowner,
department for access.

SCALE 1" = 1000'
K.S.M.