



Fall & Associates
 Stake and Elevation Service
 P.O. Box 222
 Pretty Prairie, KS. 67570
 785-243-7506

Date 6-26-19

Invoice Number 0612191

CHOLLA PRODUCTION, LLC
 Operator

1
 Number

Howat OWWO
 Farm Name

Trego-KS
 County-State

12 11s 23w
S T R


335'FNL 1650'FWL
 Location


Cholla Production, LLC
 10390 Bradford Rd.
 Suite 201
 Littleton, CO. 80127

Elevation 2243 Gr.

Ordered By: Emily

Scale 1"=1000'

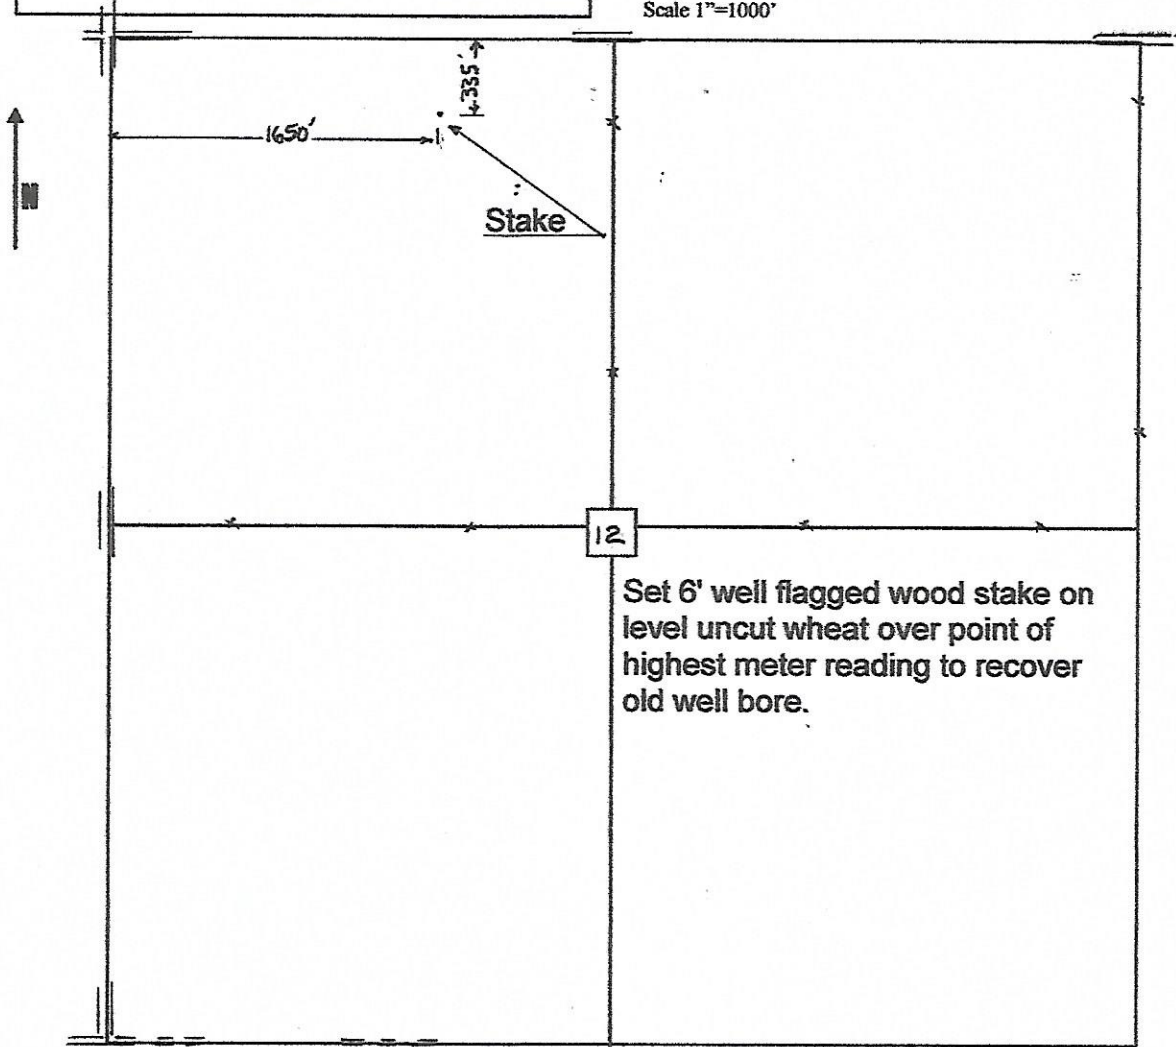

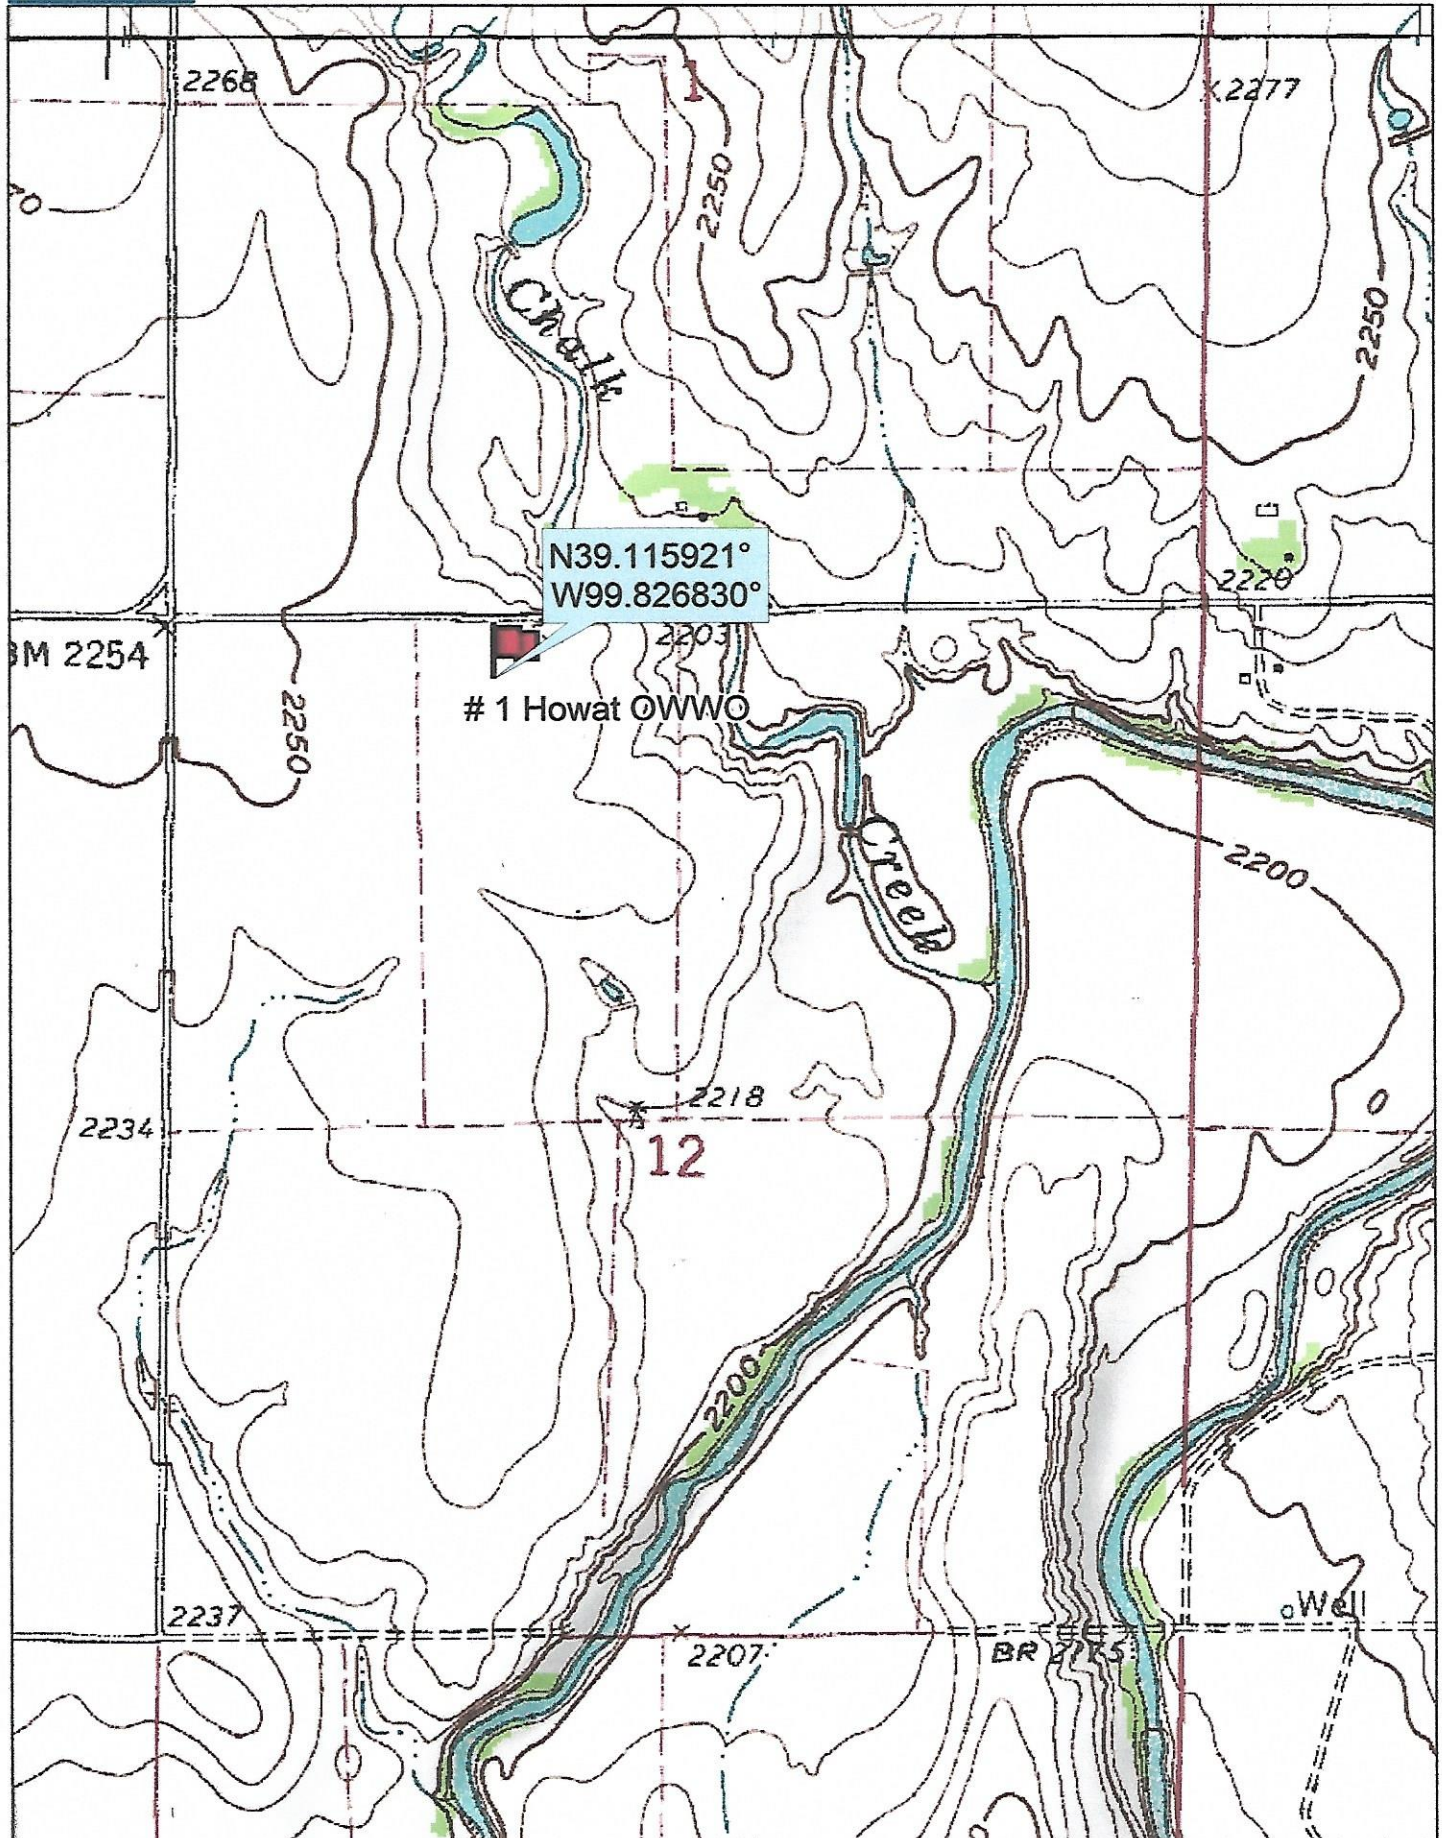


Data use subject to license.

© DeLorme. Topo North America™ 9.

www.delorme.com



Scale 1 : 12,000

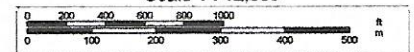

1" = 1,000.0 ft

Data Zoom 13-1

