

Confidentiality Requested:

Yes No

**KANSAS CORPORATION COMMISSION
OIL & GAS CONSERVATION DIVISION**

Form ACO-1

January 2018

Form must be Typed

Form must be Signed

All blanks must be Filled

**WELL COMPLETION FORM
WELL HISTORY - DESCRIPTION OF WELL & LEASE**

OPERATOR: License # _____

Name: _____

Address 1: _____

Address 2: _____

City: _____ State: _____ Zip: _____ + _____

Contact Person: _____

Phone: (_____) _____

CONTRACTOR: License # _____

Name: _____

Wellsite Geologist: _____

Purchaser: _____

Designate Type of Completion:

New Well Re-Entry Workover

Oil WSW SWD

Gas DH EOR

OG GSW

CM (Coal Bed Methane)

Cathodic Other (Core, Expl., etc.): _____

If Workover/Re-entry: Old Well Info as follows:

Operator: _____

Well Name: _____

Original Comp. Date: _____ Original Total Depth: _____

Deepening Re-perf. Conv. to EOR Conv. to SWD

Plug Back Liner Conv. to GSW Conv. to Producer

Commingled Permit #: _____

Dual Completion Permit #: _____

SWD Permit #: _____

EOR Permit #: _____

GSW Permit #: _____

Spud Date or Recompletion Date _____ Date Reached TD _____ Completion Date or Recompletion Date _____

API No.: _____

Spot Description: _____

_____ - _____ - _____ Sec. _____ Twp. _____ S. R. _____ East West

_____ Feet from North / South Line of Section

_____ Feet from East / West Line of Section

Footages Calculated from Nearest Outside Section Corner:

NE NW SE SW

GPS Location: Lat: _____, Long: _____
(e.g. xx.xxxxx) (e.g. -xxx.xxxxx)

Datum: NAD27 NAD83 WGS84

County: _____

Lease Name: _____ Well #: _____

Field Name: _____

Producing Formation: _____

Elevation: Ground: _____ Kelly Bushing: _____

Total Vertical Depth: _____ Plug Back Total Depth: _____

Amount of Surface Pipe Set and Cemented at: _____ Feet

Multiple Stage Cementing Collar Used? Yes No

If yes, show depth set: _____ Feet

If Alternate II completion, cement circulated from: _____

feet depth to: _____ w/ _____ sx cmt.

Drilling Fluid Management Plan

(Data must be collected from the Reserve Pit)

Chloride content: _____ ppm Fluid volume: _____ bbls

Dewatering method used: _____

Location of fluid disposal if hauled offsite: _____

Operator Name: _____

Lease Name: _____ License #: _____

Quarter _____ Sec. _____ Twp. _____ S. R. _____ East West

County: _____ Permit #: _____

AFFIDAVIT

I am the affiant and I hereby certify that all requirements of the statutes, rules and regulations promulgated to regulate the oil and gas industry have been fully complied with and the statements herein are complete and correct to the best of my knowledge.

Submitted Electronically

KCC Office Use ONLY

Confidentiality Requested

Date: _____

Confidential Release Date: _____

Wireline Log Received Drill Stem Tests Received

Geologist Report / Mud Logs Received

UIC Distribution

ALT I II III Approved by: _____ Date: _____

Operator Name: _____ Lease Name: _____ Well #: _____

Sec. _____ Twp. _____ S. R. _____ East West County: _____

INSTRUCTIONS: Show important tops of formations penetrated. Detail all cores. Report all final copies of drill stems tests giving interval tested, time tool open and closed, flowing and shut-in pressures, whether shut-in pressure reached static level, hydrostatic pressures, bottom hole temperature, fluid recovery, and flow rates if gas to surface test, along with final chart(s). Attach extra sheet if more space is needed.

Final Radioactivity Log, Final Logs run to obtain Geophysical Data and Final Electric Logs must be emailed to kcc-well-logs@kcc.ks.gov. Digital electronic log files must be submitted in LAS version 2.0 or newer AND an image file (TIFF or PDF).

Drill Stem Tests Taken <input type="checkbox"/> Yes <input type="checkbox"/> No <i>(Attach Additional Sheets)</i> Samples Sent to Geological Survey <input type="checkbox"/> Yes <input type="checkbox"/> No Cores Taken <input type="checkbox"/> Yes <input type="checkbox"/> No Electric Log Run <input type="checkbox"/> Yes <input type="checkbox"/> No Geologist Report / Mud Logs <input type="checkbox"/> Yes <input type="checkbox"/> No List All E. Logs Run:	<input type="checkbox"/> Log Formation (Top), Depth and Datum <input type="checkbox"/> Sample Name Top Datum
--	---

CASING RECORD <input type="checkbox"/> New <input type="checkbox"/> Used							
Report all strings set-conductor, surface, intermediate, production, etc.							
Purpose of String	Size Hole Drilled	Size Casing Set (In O.D.)	Weight Lbs. / Ft.	Setting Depth	Type of Cement	# Sacks Used	Type and Percent Additives

ADDITIONAL CEMENTING / SQUEEZE RECORD				
Purpose:	Depth Top Bottom	Type of Cement	# Sacks Used	Type and Percent Additives
<input type="checkbox"/> Perforate <input type="checkbox"/> Protect Casing <input type="checkbox"/> Plug Back TD <input type="checkbox"/> Plug Off Zone				

1. Did you perform a hydraulic fracturing treatment on this well? Yes No *(If No, skip questions 2 and 3)*
2. Does the volume of the total base fluid of the hydraulic fracturing treatment exceed 350,000 gallons? Yes No *(If No, skip question 3)*
3. Was the hydraulic fracturing treatment information submitted to the chemical disclosure registry? Yes No *(If No, fill out Page Three of the ACO-1)*

Date of first Production/Injection or Resumed Production/Injection:	Producing Method: <input type="checkbox"/> Flowing <input type="checkbox"/> Pumping <input type="checkbox"/> Gas Lift <input type="checkbox"/> Other <i>(Explain)</i> _____				
Estimated Production Per 24 Hours	Oil Bbls.	Gas Mcf	Water Bbls.	Gas-Oil Ratio	Gravity

DISPOSITION OF GAS: <input type="checkbox"/> Vented <input type="checkbox"/> Sold <input type="checkbox"/> Used on Lease <i>(If vented, Submit ACO-18.)</i>	METHOD OF COMPLETION: <input type="checkbox"/> Open Hole <input type="checkbox"/> Perf. <input type="checkbox"/> Dually Comp. <input type="checkbox"/> Commingled <i>(Submit ACO-5)</i> <i>(Submit ACO-4)</i>	PRODUCTION INTERVAL: Top Bottom
---	---	------------------------------------

Shots Per Foot	Perforation Top	Perforation Bottom	Bridge Plug Type	Bridge Plug Set At	Acid, Fracture, Shot, Cementing Squeeze Record <i>(Amount and Kind of Material Used)</i>

TUBING RECORD:	Size:	Set At:	Packer At:	
----------------	-------	---------	------------	--

Form	ACO1 - Well Completion
Operator	Stewart Producers, Inc.
Well Name	JR RANCH 1
Doc ID	1465822

All Electric Logs Run

DIL
Comp. Dens./Neutron/PE
Micro
Sonic

Form	ACO1 - Well Completion
Operator	Stewart Producers, Inc.
Well Name	JR RANCH 1
Doc ID	1465822

Tops

Name	Top	Datum
Lansing	1424	-20
KC	1594	-190
BKC	1787	-383
Miss.	2458	-1054
Hunton	2939	-1535
Viola	3088	-1684
Simpson Sh.	3196	-1792
Arbuckle	3271	-1867

Geologic Report
Aaron L. Young

Drilling Time and Sample Log

Scale 1:240 (5"=100') Imperial
Measured Depth Log

Well Name: JR Ranch #1
API: 15-197-20309
Location: Section 24 - T14S - R11E
License Number: 34996
Spud Date: 05/08/2019
Surface Coordinates: 840' FNL and 2230' FWL

Region: Wabaunsee Co., KS
Drilling Completed: 05/14/2019

Bottom Hole
Coordinates:
Ground Elevation (ft): 1395' K.B. Elevation (ft): 1404'
Logged Interval (ft): 1500' To: 3280' Total Depth (ft): 3280'
Formation: Arbuckle
Type of Drilling Fluid: Chemical - Fud Mud

Printed by MudLog from WellSight Systems 1-800-447-1534 www.WellSight.com

OPERATOR

Company: Stewart Producers, Inc
Address: PO Box 546
Mt. Vernon, IL 62864

GEOLOGIST

Name: Aaron L. Young, M.S.
Company: Young Consulting LLC
Address: 100 S Main, Suite 505
Wichita, Kansas 67202

General Info

CONTRACTOR: C & G Drilling, Rig #2

BIT RECORD:

No.	Size	Make	Jets	Out	Feet	Hours
1	12-1/4	Atlas 616 PDC	6x18's	315	315	2.0
2	7-7/8	Atlas 616 PDC	6x18's	3280	2965	64.0

GENERAL DRILLING AND PUMP INFORMATION:

Drilling with 8,000 lbs. on bit and approx 110 RPM.
Running 4 stands of collars; 245'
Pumping approx 500-600 psi at standpipe @ 60 SPM

Daily Status


5/8/19 C&G Drilling finished moving in and rigging up. Drilled rathole, starting on surface @11:00am.
 5/9/19 Drilling at 430' @ 8:15am. Drilled 315' 12-1/4" hole. Ran 300.14" of 8-5/8" surface casing. Pumped 180 sks cement. 3% calcium 2%gel. Circulated cement into pits. Plug down @9:30pm,(5/8/19). Break out nipple up drill mouse hole.
 5/10/19 Drilling @ 1503' @ 7:30am. Lost circulation @ 1390, got it back, ran bit trip to clean out LCM.
 5/11/19 Drilling @ 2500' @ 12:30pm. Bit plugged off again during the day, yesterday. Had to pull bit, clean and resume drilling. Penetration rate, sample tops and correlation much improved.
 5/12/19 Drilling at 2960', evaluating Hunton.
 5/13/19 TD 3217. Going back into hole following DST#1 (Simpson Dolomite). Simpson sand next target formation. Very poor show in Hunton. No shows in Viola.
 DST#1 3202-3217 Rec. 340' very slightly oil spotted muddy water.
 IFP: 21 - 70#, ISIP 1086#, FFP 76-161#, FSIP 1084#
 5/14/19 TD 3280. TOH for log. Plugged w/ 15 sks @ 3130' Simpson, 15 sks @ 3020' Viola, 15 sks @ 2890' Hunton, 15 sks @ 2440' Miss, 25 sks @ 1535' KC, 35sks @ 350', 25 sks @ 60', 30 sks in rathole, & 20 sks in

DST #1 SIMPSON DOLOMITE 3202' - 3217'









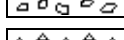


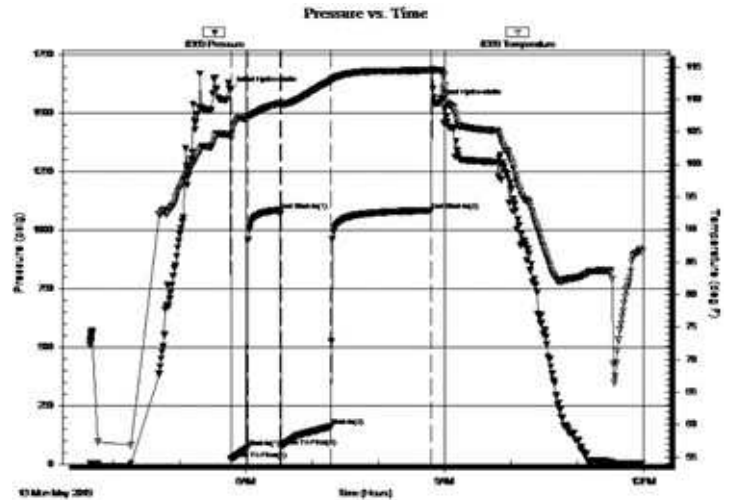
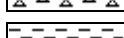



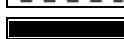




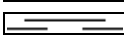
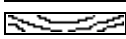


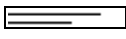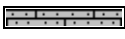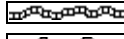





IF: Weak blow built to 6 inches
 ISL: No blowback
 FF: No blow built to 13 inches
 FSI: No blowback

Rec'd: 340' OSSMCW (Tr O, 89% W, 11% M)

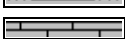SIP: 1086-1084#
 FP: 21-70#, 76-161#
 HP: 1598-1545#

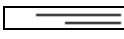

ROCK TYPES

	Anhy		Gyp		Shgy		Sandylms
	Bent		Igne		Sltst		Shale
	Brec		Lmst		Ss		Sltstn
	Cht		Meta		Till		Shlyslts
	Clyst		Mrlst		Carb sh		Sltyslts
	Coal		Salt		Dol		Sltyslts
	Congl		Shale		Dtd		Lms
	Dol		Shcol		Gry sh		

ACCESSORIES

MINERAL

- Anhy
- Arggrn
- Arg
- Bent
- Bit
- Breclrag
- Calc
- Carb
- Chtdk
- Chtlt
- Dol
- Feldspar
- Ferrpel
- Ferr
- Glau
- Gyp
- Hvymin
- Kaol
- Marl
- Minxl
- Nodule
- Phos
- Pyr



- Salt
- Sandy
- Silt
- Sil
- Sulphur
- Tuff
- Chlorite
- Dol
- Sand
- Silty

FOSSIL

- Algae
- Amph
- Belm
- Bioclst
- Brach
- Bryozoa
- Cephal
- Coral
- Crin
- Echin
- Fish
- Foram



- Fossil
- Gastro
- Oolite
- Ostra
- Pelec
- Pellet
- Pisolite
- Plant
- Strom
- Fuss
- Oomold

STRINGER

- Anhy
- Arg
- Bent
- Coal
- Dol
- Gyp
- Ls
- Mrst
- Sltstrg
- Ssstrg
- Carbsh



- Clystn
- Dol
- Grysh
- Gryslt
- Lms
- Sandylms
- Sh
- Sltstn

TEXTURE

- Boundst
- Chalky
- Cryxln
- Earthy
- Finexln
- Grainst
- Lithogr
- Microxln
- Mudst
- Packst
- Wackest

OTHER SYMBOLS

POROSITY TYPE

- Earthy
- Fenest
- Fracture
- Inter
- Moldic
- Organic
- Pinpoint
- Vuggy

SORTING

- Well
- Moderate
- Poor

ROUNDING

- Rounded
- Subrnd
- Subang
- Angular

OIL SHOWS


- Even
- Spotted
- Ques
- Dead
- Gas show



INTERVALS


- Core
- Dst



- Dst
- #### EVENTS
- Rft
 - Sidewall
 - Conn

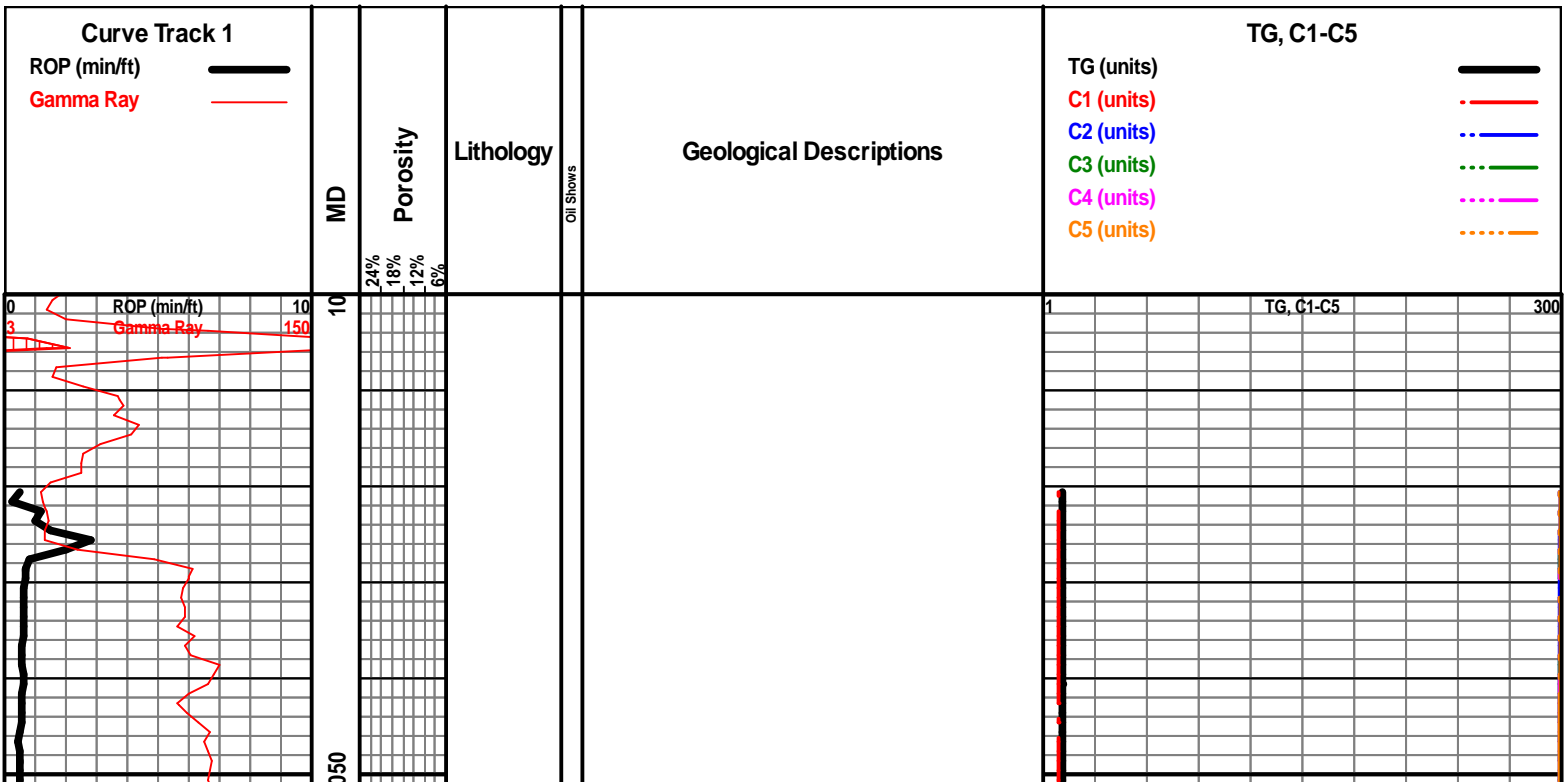

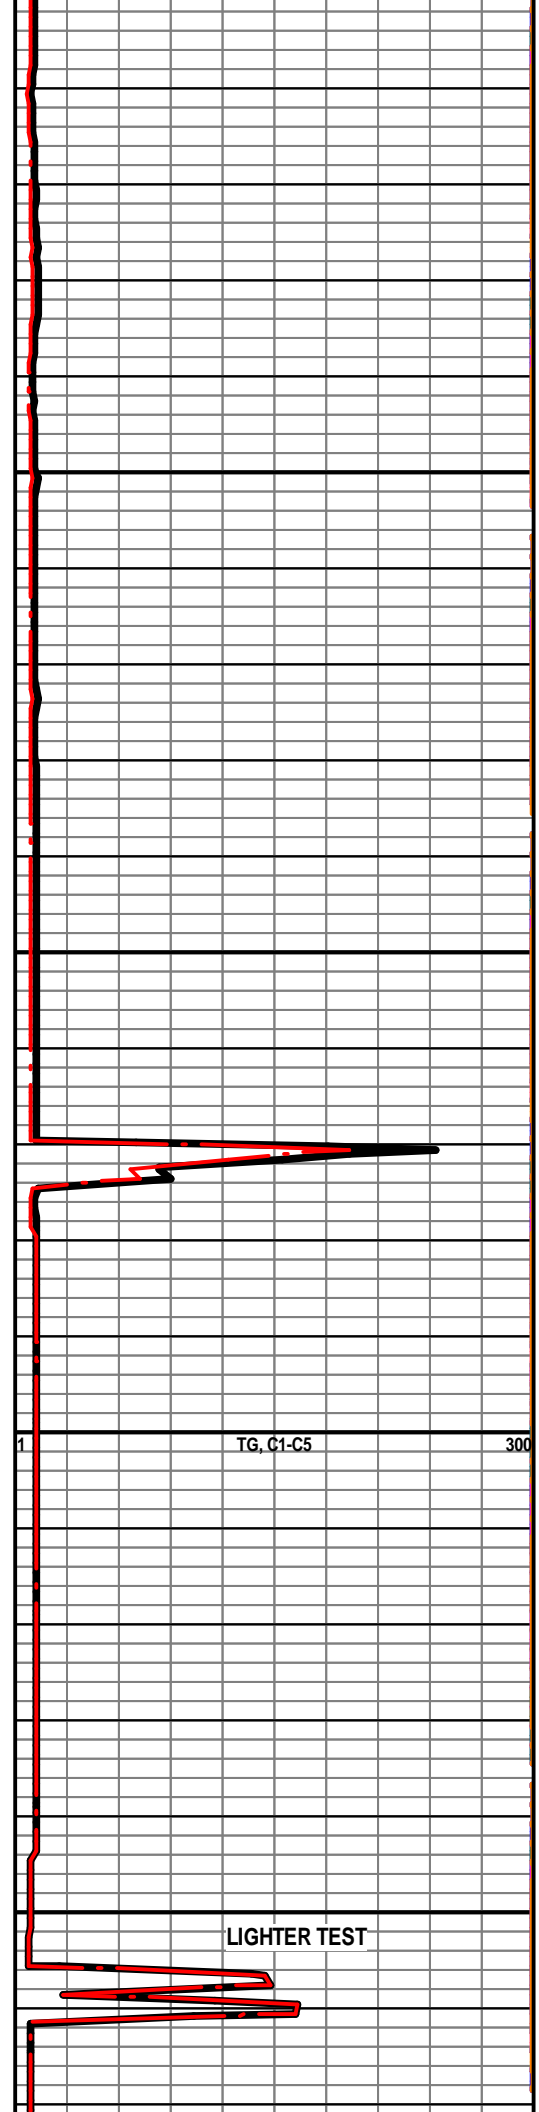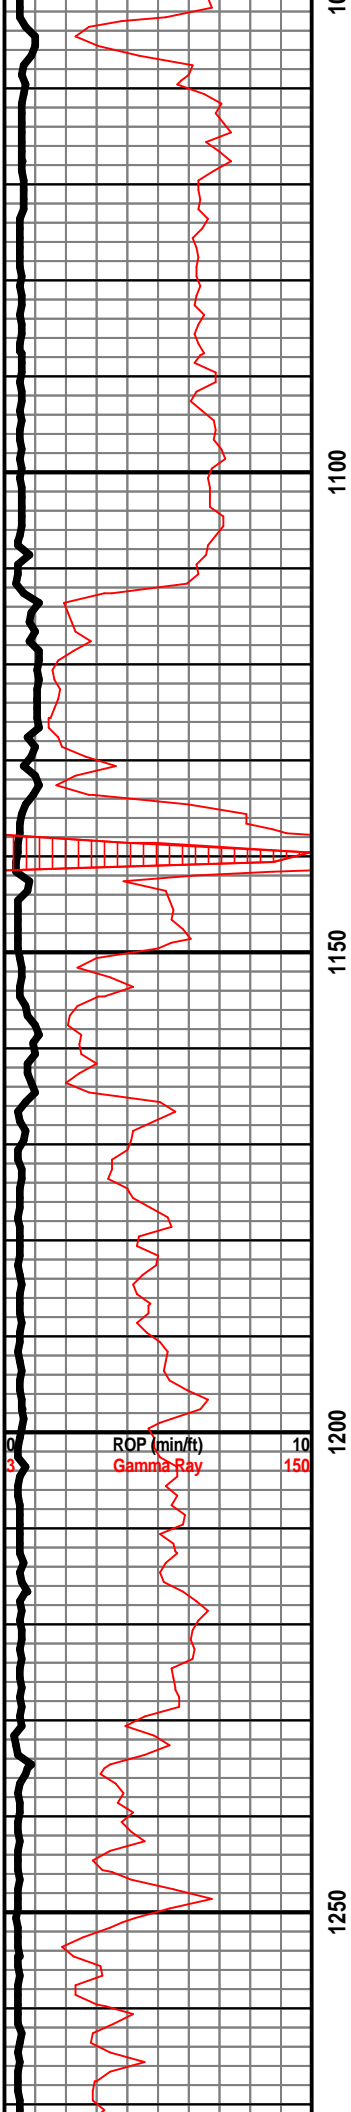

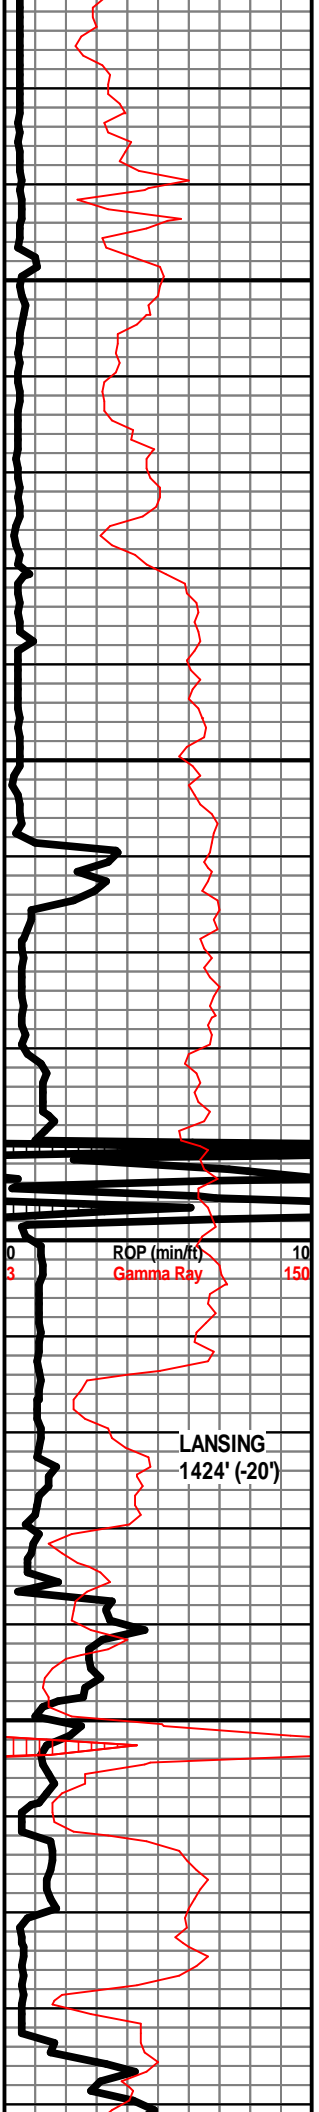


1300

1350

1400


1450

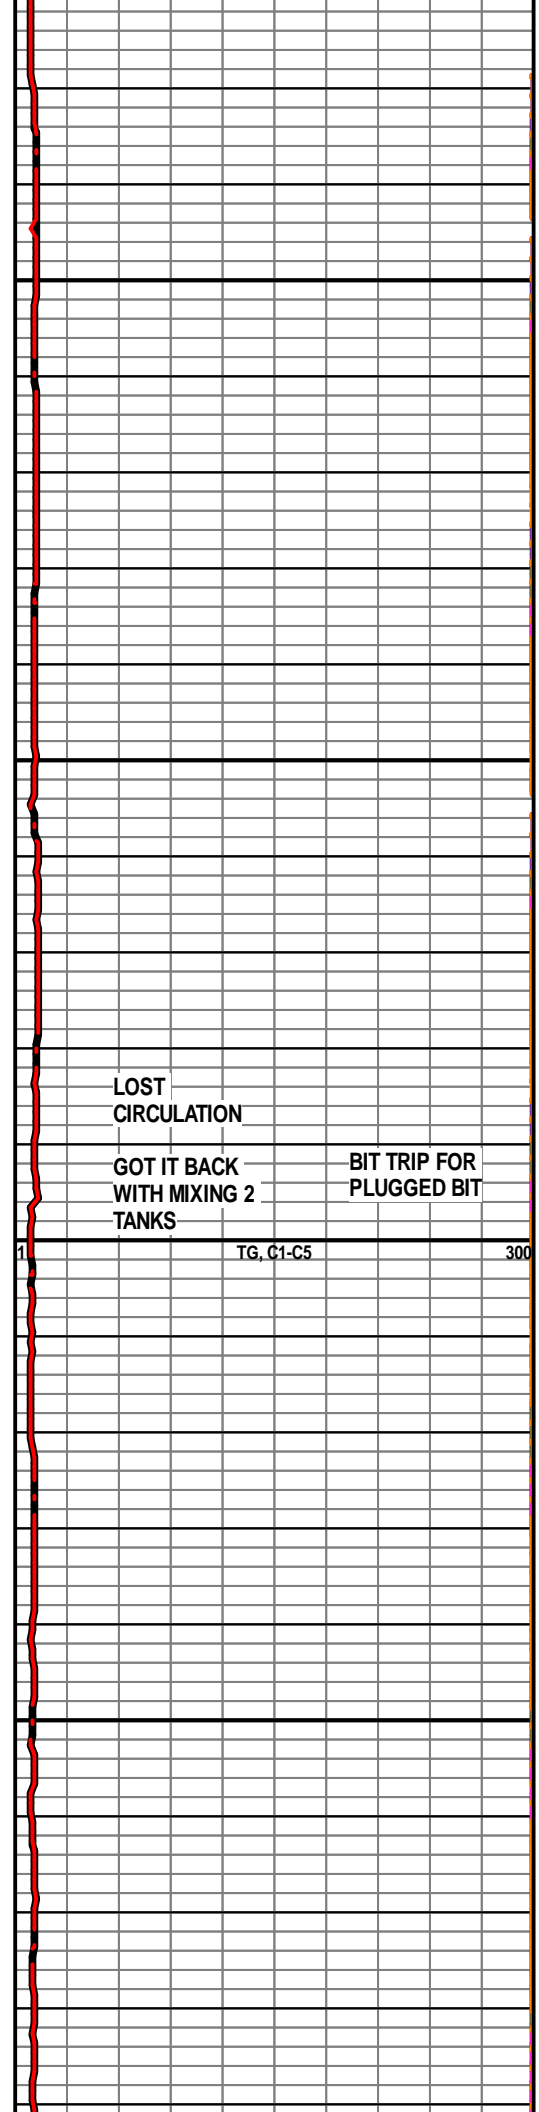


1

TG, C1-C5

300

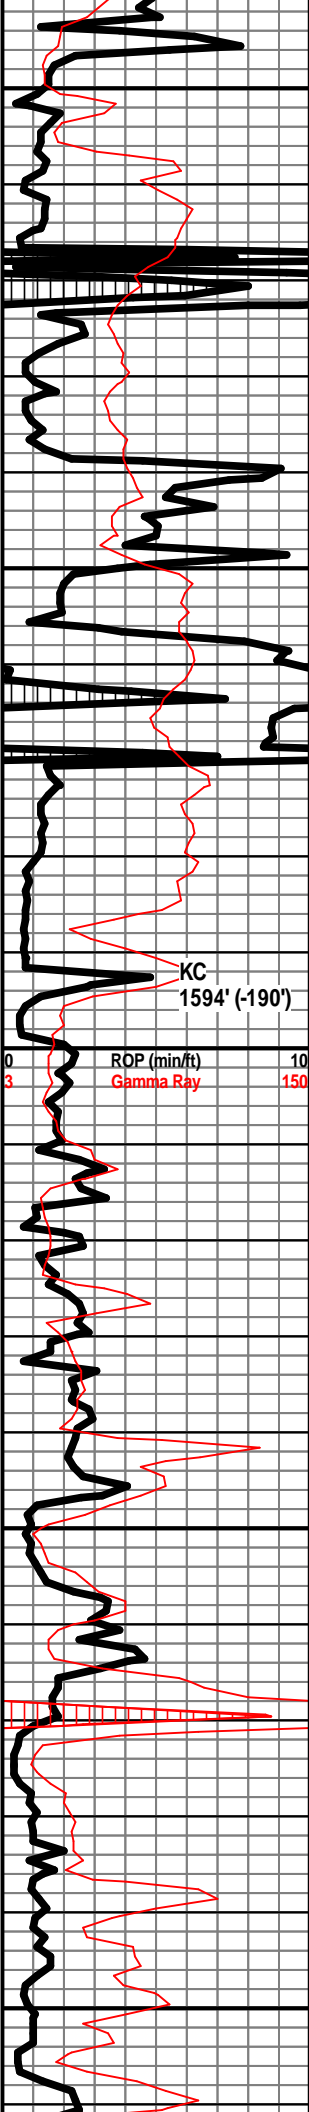

1500
1550
1600
1650
1700

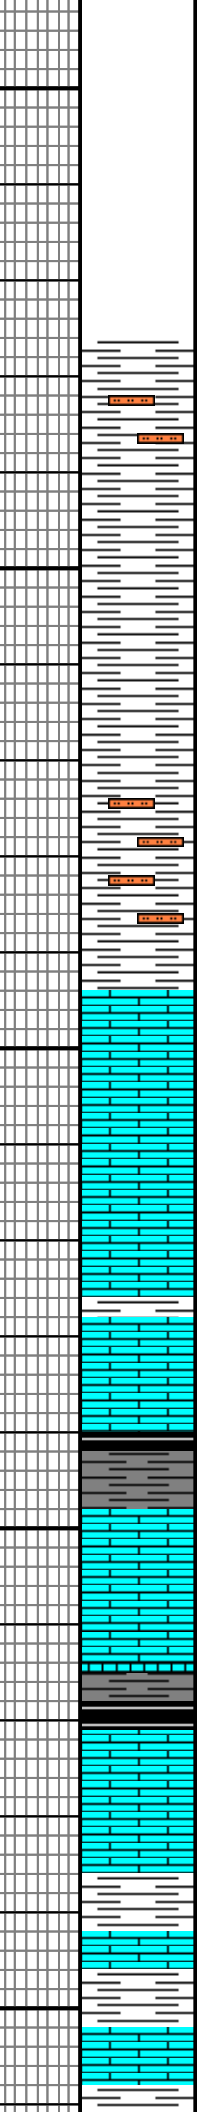

SH - LT GY / GY, PRED V SOFT, MOD DNS IN PT, SLTY IN PT, PYRITIC IN PT


SH - GY / GRN, RD / YEL IN PT

LS - CRM / WHT, F / VF XLN, MOD DNS / SUBCKY, CHKY IN PT, W/ SH - LT GY / GY, SLTY

LS - CRM / TAN, F XLN, MOD DNS, DNS IN PT, FOSS

SH - DK GY / BLK, SLI CARB IN PT, W/ LS - TAN / GY, VF / F XLN, MOD DNS / DNS, FEW PIECES CHKY, FOSS IN PT

SH - GRN, W/ LS - CRM / TAN, VF / F XLN, MOD DNS, FOSS IN PT, W/ SH - DK GY / BLK, CARB

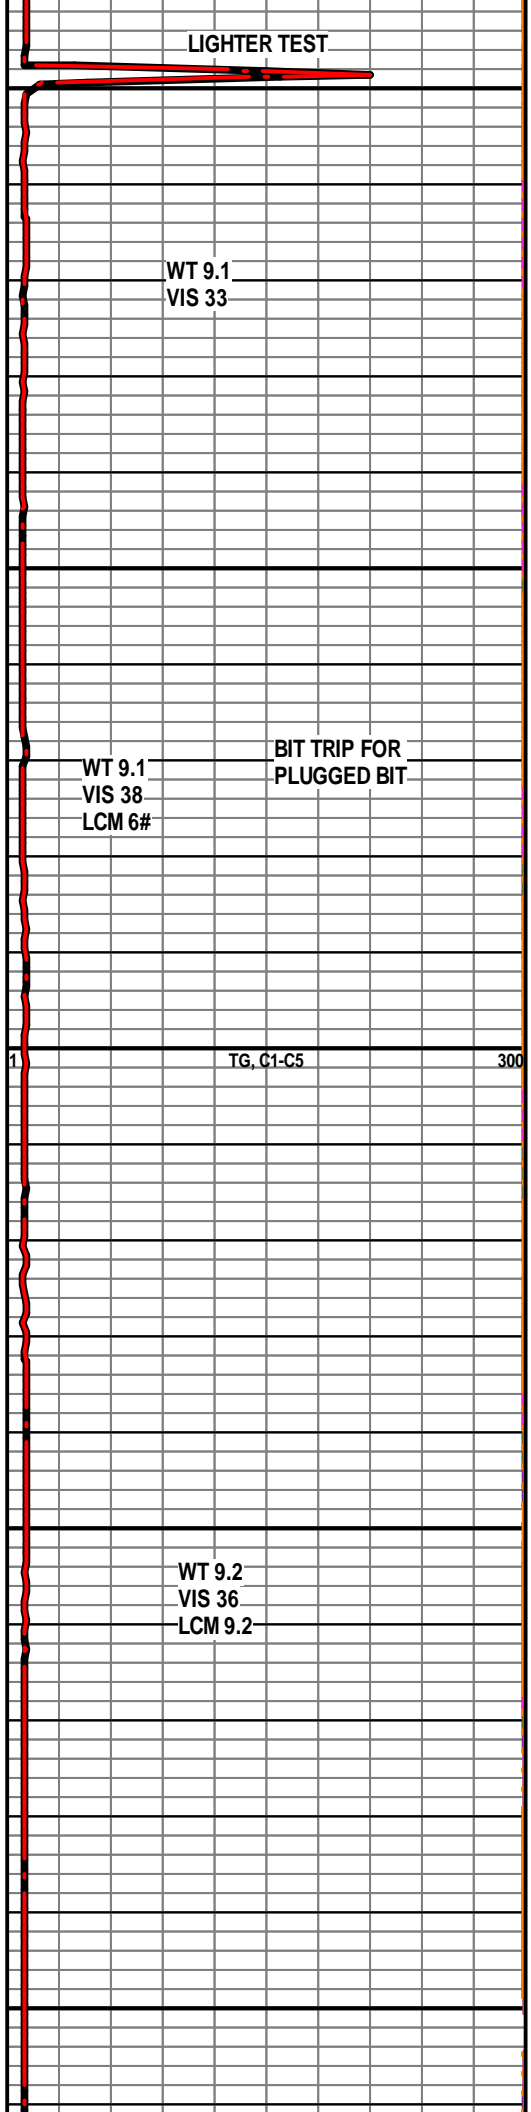

LIGHTER TEST

WT 9.1
VIS 33


WT 9.1
VIS 38
LCM 6#

BIT TRIP FOR
PLUGGED BIT

TG, C1-C5

300

WT 9.2
VIS 36
LCM 9.2

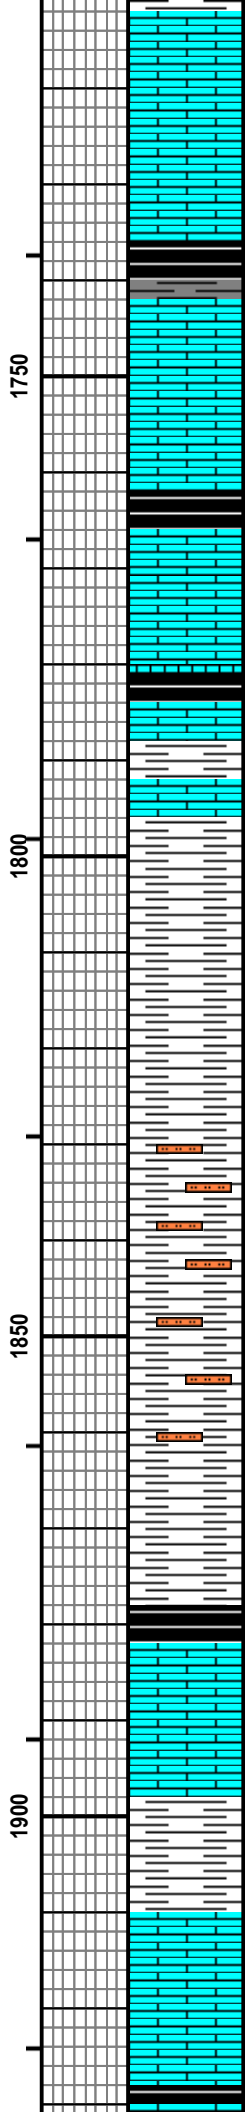

LS - WHT / CRM, VF / F XLN, PRED SUBCHKY / MOD DNS, CHKY IN FEW PIECES, W/ SH - GY

LS - WHT / CRM / TAN / GY, VF / F XLN, PRED SUBCHKY / MOD DNS, CHKY IN PT, W/ SH - BLK, CARB


SH - BLK, CARB, W/ SH - GRN / GY, W/ LS - CRM / TAN, VF XLN, SUBCHKY, W/ SCAT PYRITE


LS - TAN, F XLN, MOD DNS / DNS, FOSS, W/ SH - GRN / GY, ABUND SCAT PYRITE

SH - GY, SLTY, W/ SCAT PYRITE

SH - GRN / GRN IN PT, SLTY IN PT

LS - CRM / TAN, VF / F XLN, SUBCHKY / MOD DNS, W/ SH - GRN, W/ SH - BLK, V SLI CARB

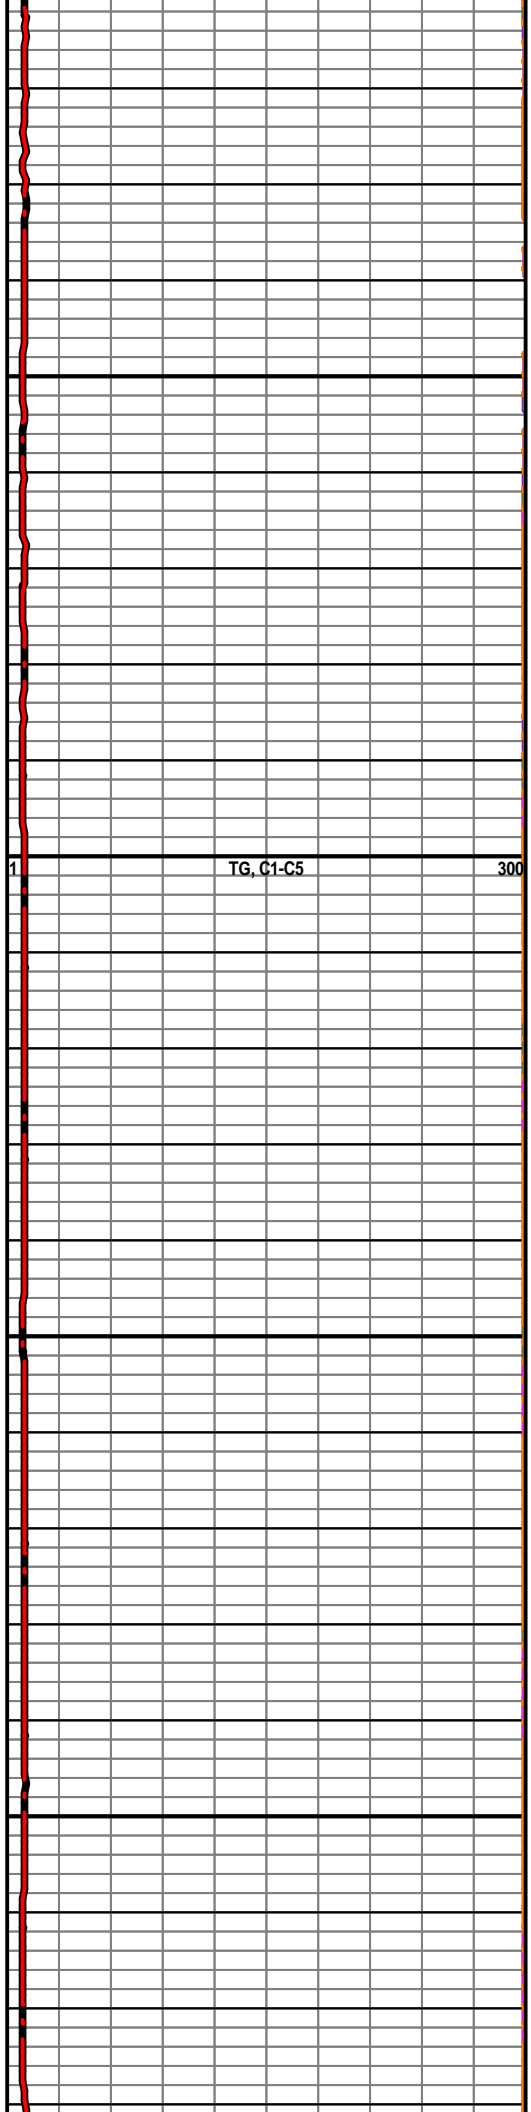

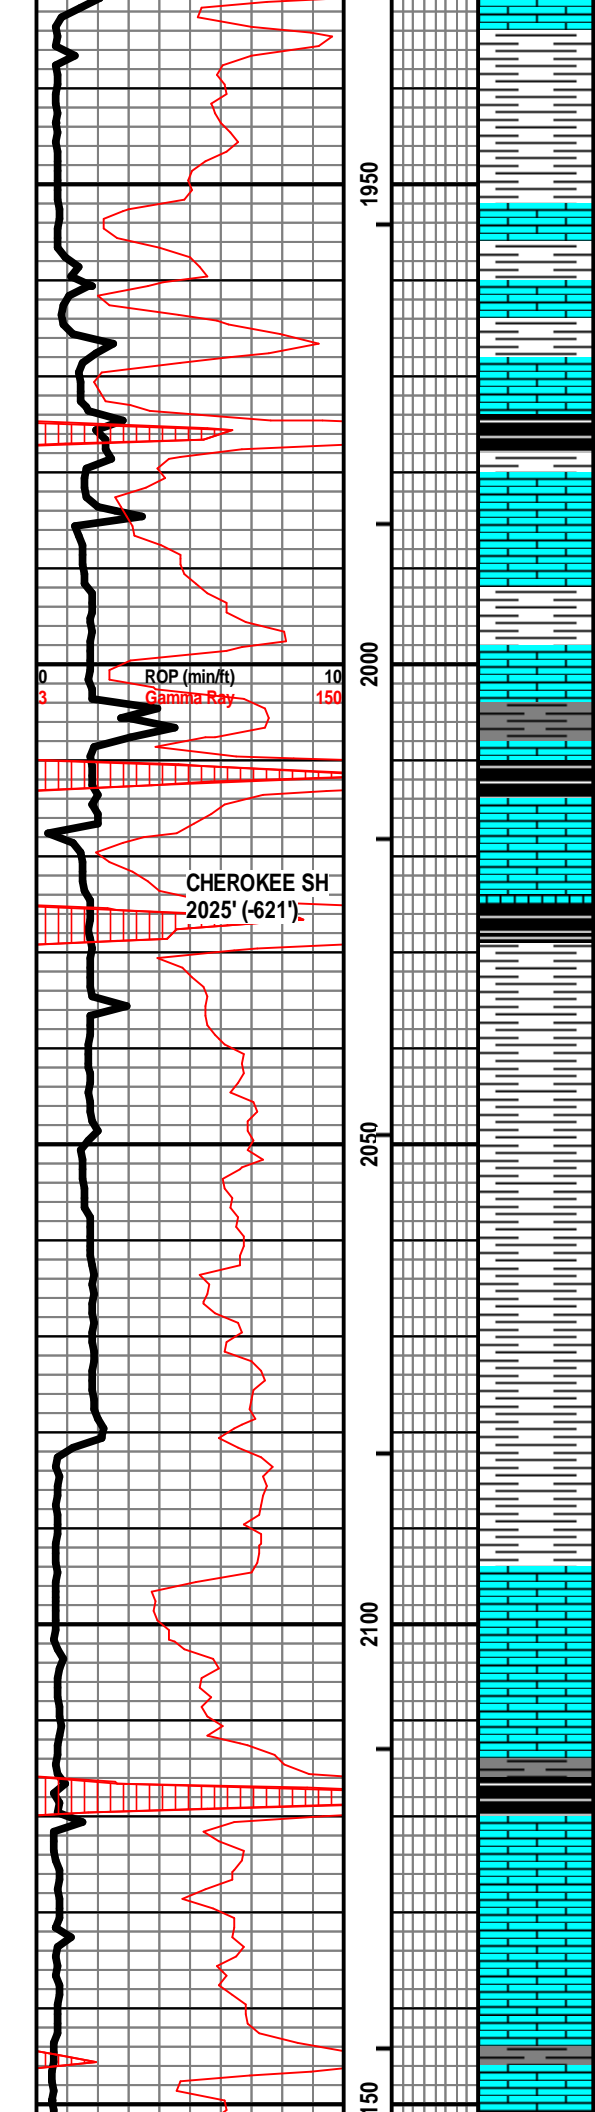

LS - CRM / TAN, VF / F XLN, PRED MOD DNS / DNS, SUBCHKY IN PT, W/ SH - LT GY / GRN

SH - BLK, CARB, W/ LS - CRM / TAN, V XLN, MOD DNS / DNS, W/ ABUND SH - GY


LS - TAN / LT GY / CRM, F XLN, MOD DNS / DNS, W/ SH - DK GY / GY, W/ SCAT PYRITE


SH - GY / DK GY / BLK, CARB

SH - LT GY / GY, SCAT PYRITE

SH - LT GY / GY, W/ LS - TAN / LT BRN, F XLN, MOD DNS / DNS

SH - BLK, SLI CARB, W/ LS - TAN / GY / BRN IN PT, F XLN, DNS

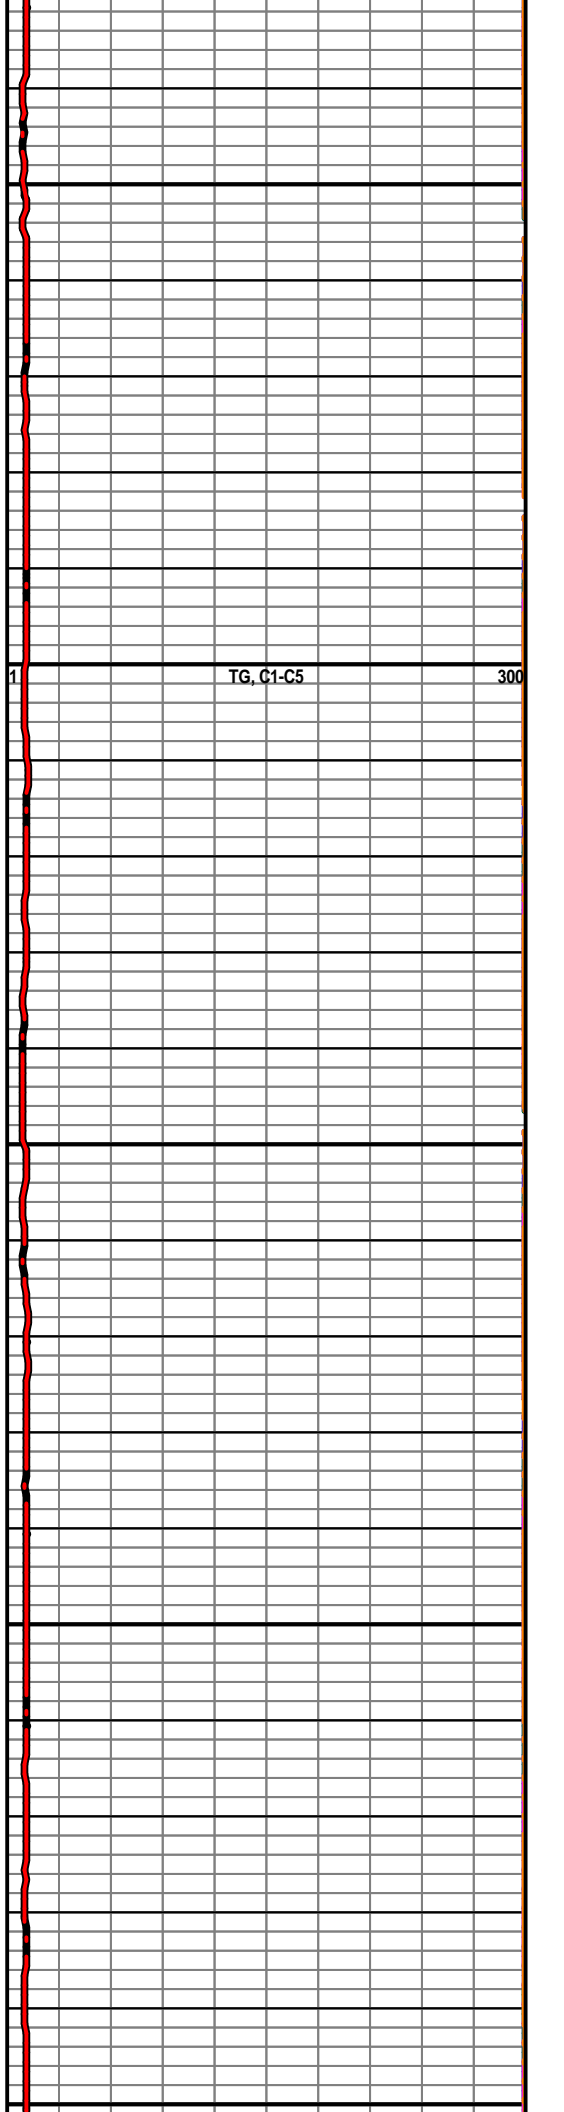

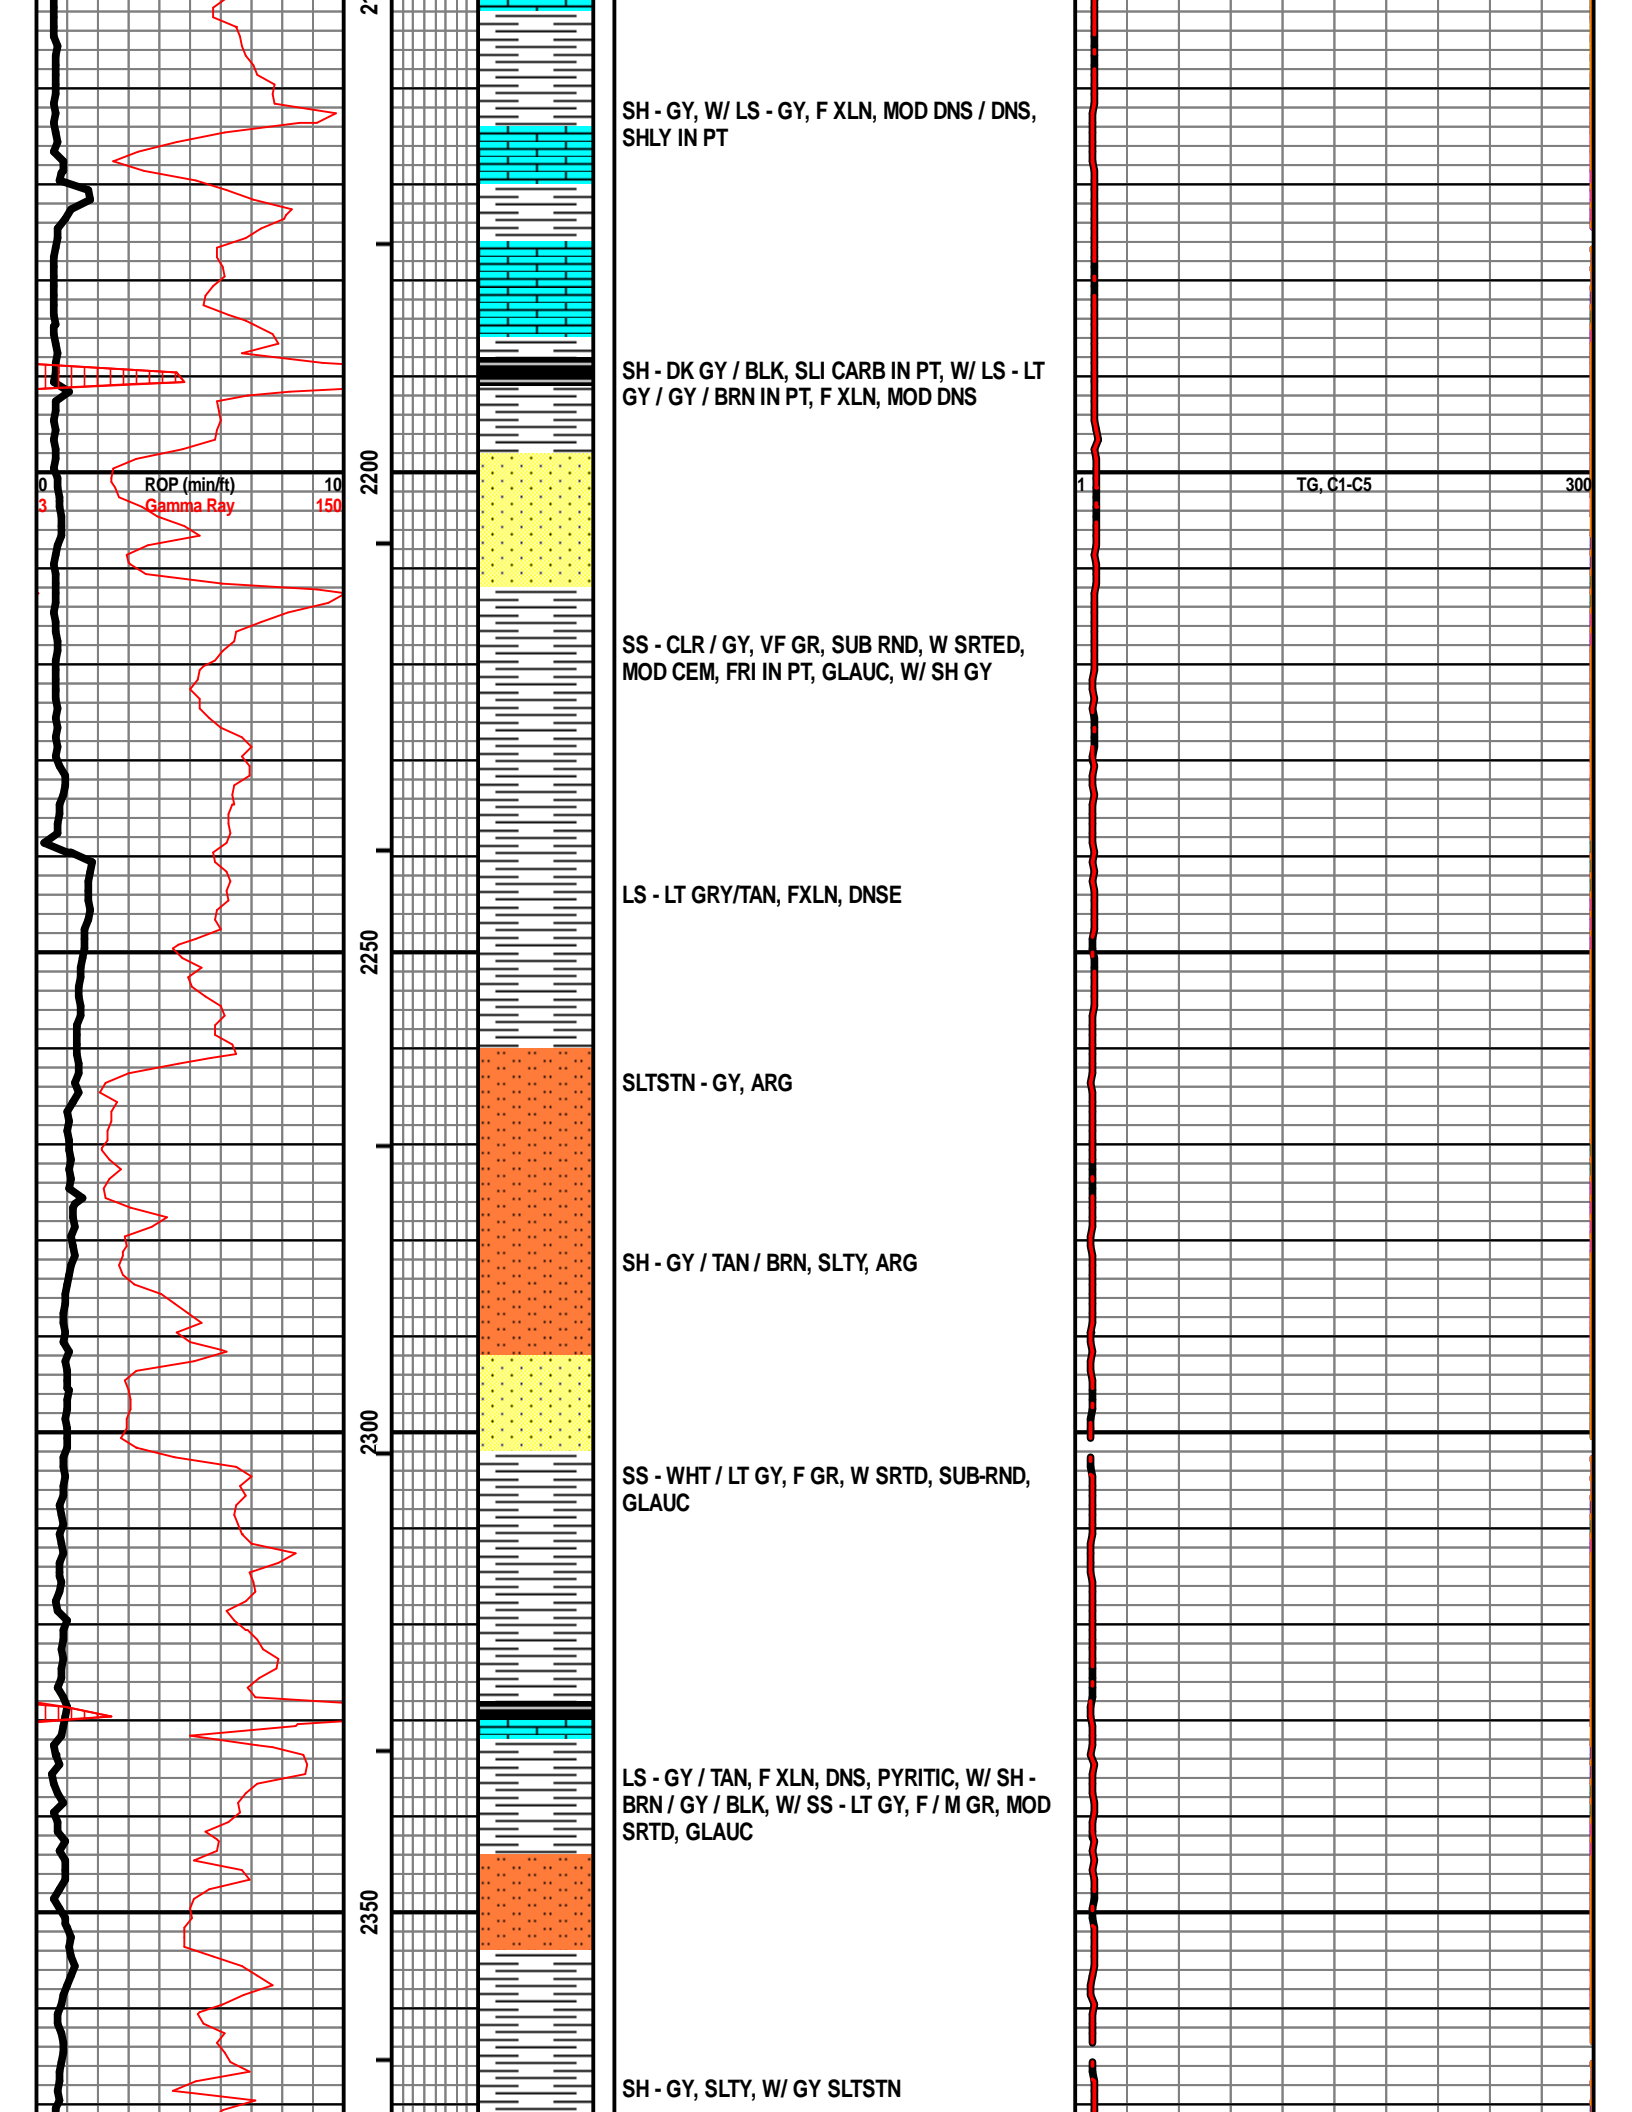

SH - GY, W/ LS - GY, F XLN, MOD DNS / DNS, SHLY IN PT

SH - DK GY / BLK, SLI CARB IN PT, W/ LS - LT GY / GY / BRN IN PT, F XLN, MOD DNS

SS - CLR / GY, VF GR, SUB RND, W SRTE, MOD CEM, FRI IN PT, GLAUC, W/ SH GY

LS - LT GRY/TAN, FXLN, DNSE

SLTSTN - GY, ARG

SH - GY / TAN / BRN, SLTY, ARG

SS - WHT / LT GY, F GR, W SRTE, SUB-RND, GLAUC

LS - GY / TAN, F XLN, DNS, PYRITIC, W/ SH - BRN / GY / BLK, W/ SS - LT GY, F / M GR, MOD SRTE, GLAUC

SH - GY, SLTY, W/ GY SLTSTN

ROP (min/ft)
Gamma Ray

TG, C1-C5

C1-C5

2200

2250

2300

2350

0



3

10

150

1

300

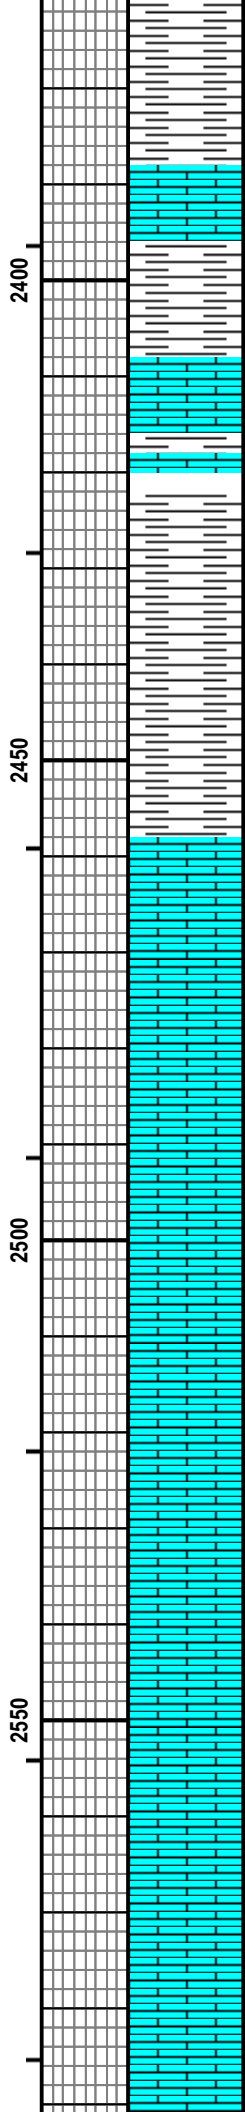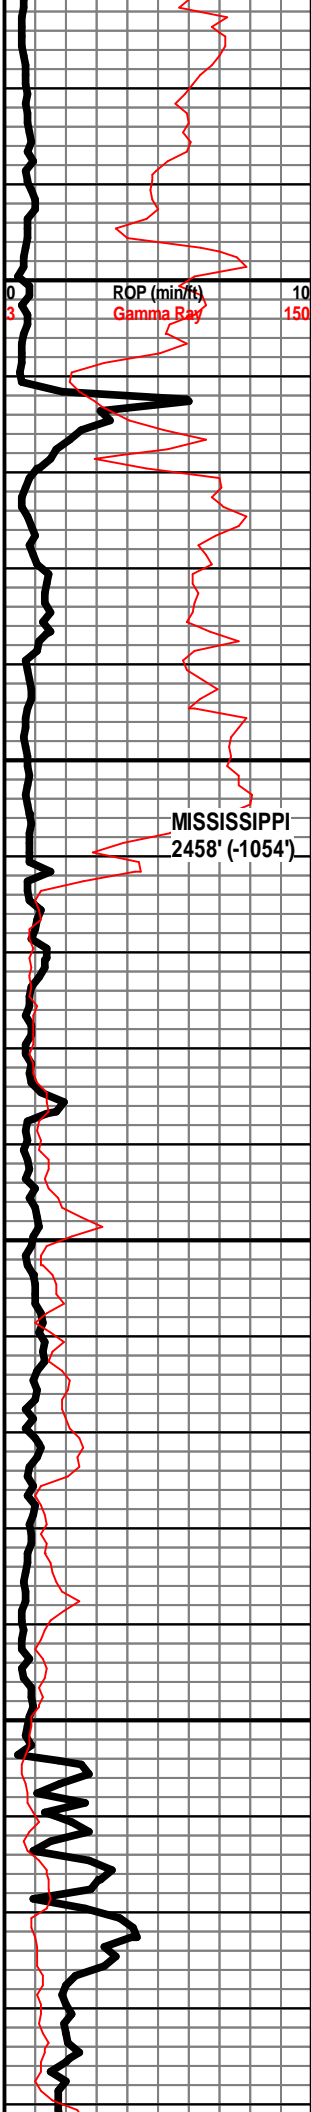

LS - LT GY / LT GRN, SLTY, ARG, W/ LS - TAN / LT BRN, F XLN, DNS

SH - BLK, CARB, W/ SH - GY / BRN, SLTY, W/ PYRITE

LS - CRM / TAN, F / M XLN, W/ SH - BLK, CARB, W/ SH - GY / BRN, SLTY, W/ PYRITE


LS- CRM TO LT TAN FN TO MED XLN POOR TO FR INTXLN AND VUG POR



LS- CRM TO LT TAN FN TO MED XLN POOR TO FR INTXLN AND VUG POR

LS - CRM FXLN, OOL IN PART, FN GR, SCAT GRN ARG NOD

LS - AS AB

LS-CRM, FN-MED XLN, DNSE TO POOR INTXLN POR

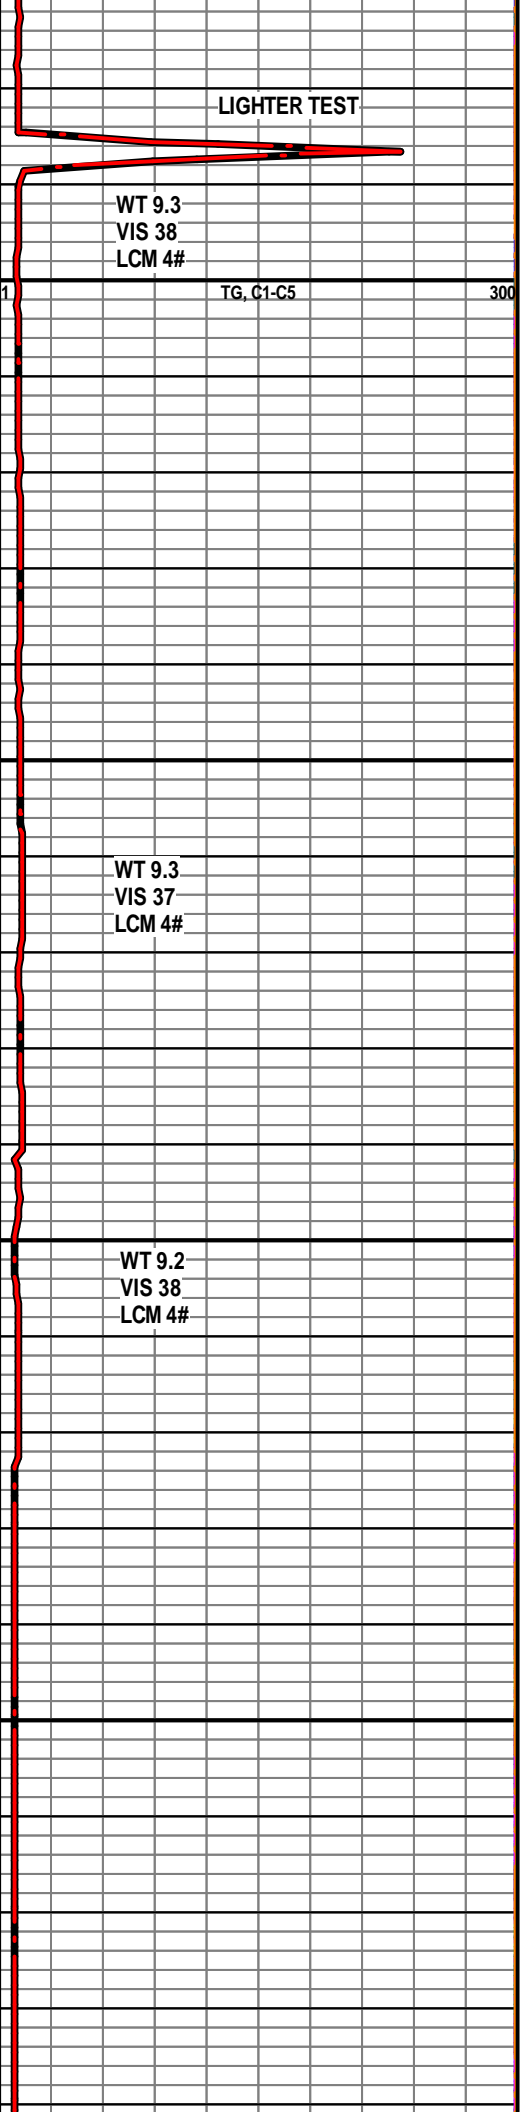

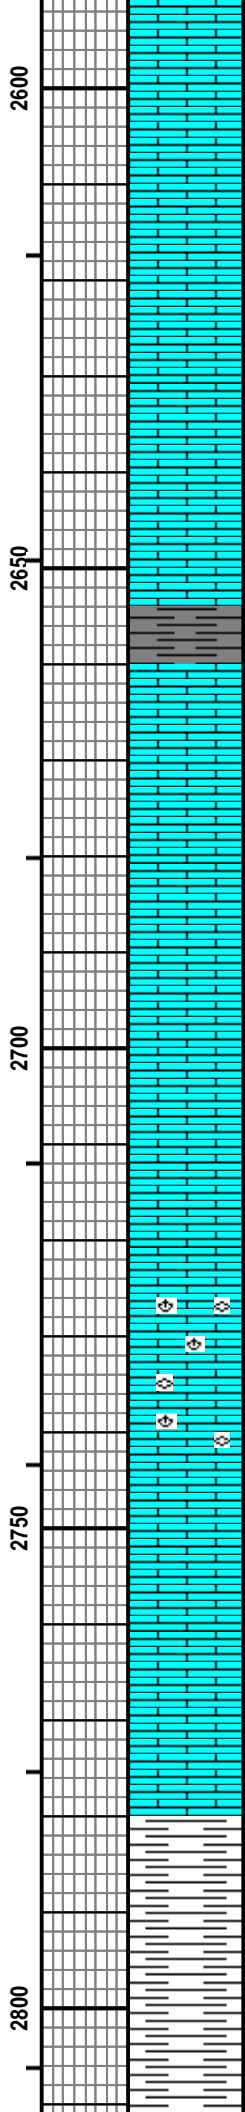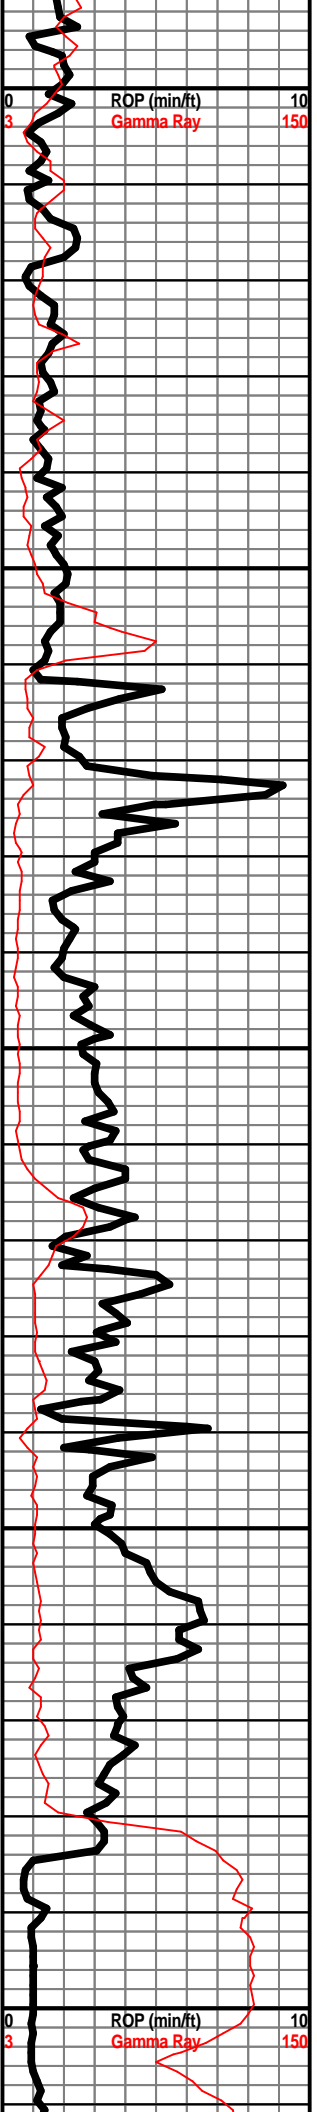

LS CRM-LT TAN,FXLN,DNSE, W/CHT WH - GRY,
LT GRN SH IN PART

LS, AS AB

LS, AS AB W/ GRY, GRN AND BLK SH

LS - WHT / CRM / TAN, VF / F XLN, SUBCHKY,
DNS IN PT, CHKY IN PT


LS - LT GY / TAN, VF XLN, MOD DNS, FOSS,
FUSILINIDS, BRACHS



LS - CRM / TAN / LT GY, VF XLN, SUBCHKY /
CHKY

LS - TAN / GY, F XLN, MOD DNS / DNS

SH - GRN / GY

SH - GRN / GY / BLK, FOSS IN BLK PIECES,
PYRITIC

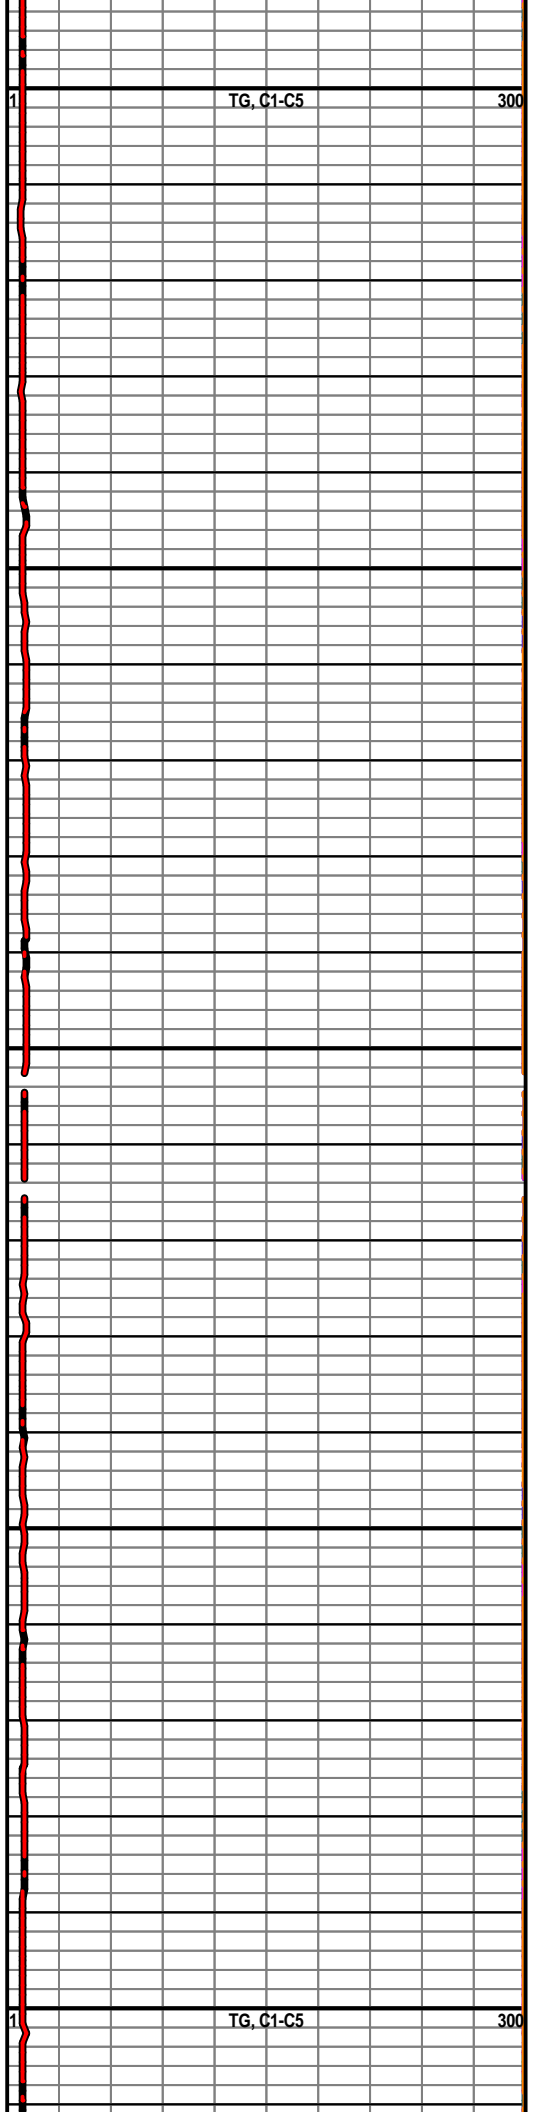

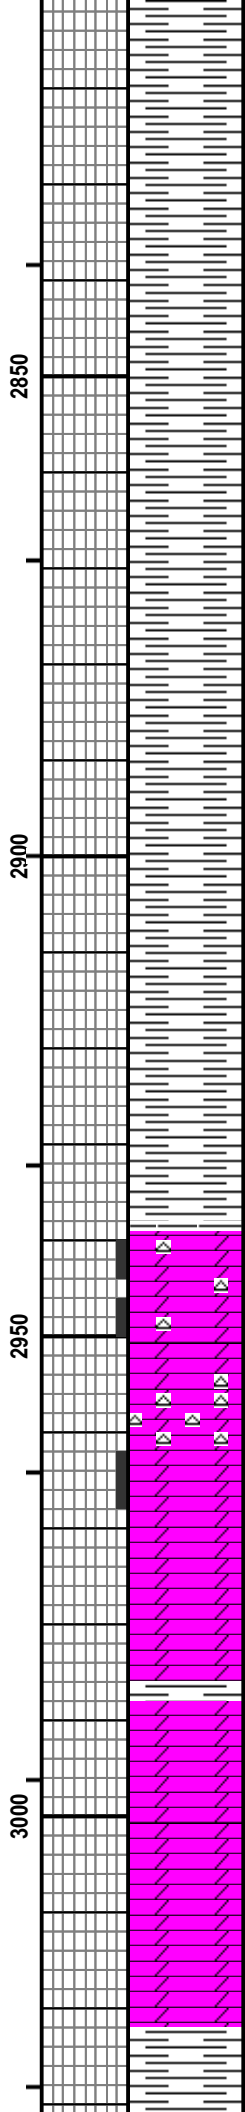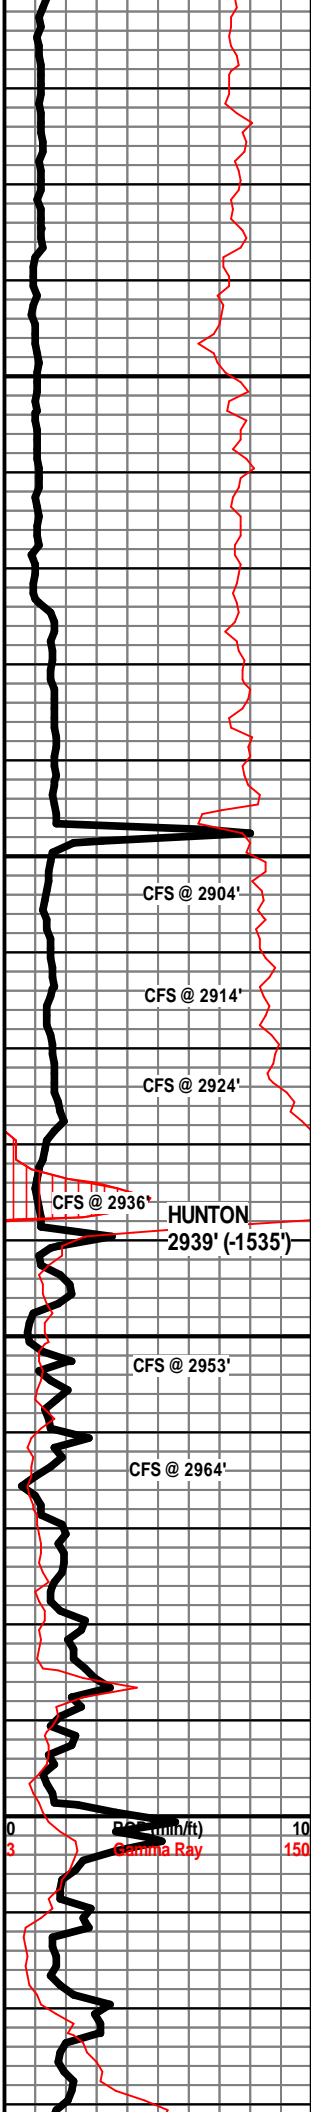

SH - LT GRN / LT GY

SH - PRED LT GY, LT GRN IN PT

SH - LT GY / BLK

SH - GY / BLK, PYRITIC IN PT, SCAT PYRITE

SH - GY / BLK, PYRITIC

DOLO - LT GY, F / M XLN, PRED DNS, LIKELY FRACT POR, NO VIS INTERXLN POR, SSFO, SHOW IN 4 PIECES, TARRY OIL, SLI ODOR, DULL MINERAL FLUOR IN PT, W/ SCAT CHT - TAN / GY, FRSH, SLI TRANSLUCNT


DOLO - GY, F XLN, DNS, NO VIS POR, NS, W/ ABUND CHT - WHT / GY / TAN, FRSH, PRED OPAQ, TRANSLUCNT IN PT

DOLO - GY, F XLN, MOD DNS, P INTERXLN & VUG POR IN PT, NS

DOLO - GY, F / M XLN, MOD DNS, W/ SH - GY / GRN

DOLO - WHT, V CHKY, W/ SH - LT GY / LT GRN

SH - GY, DOLOMITIC IN PT


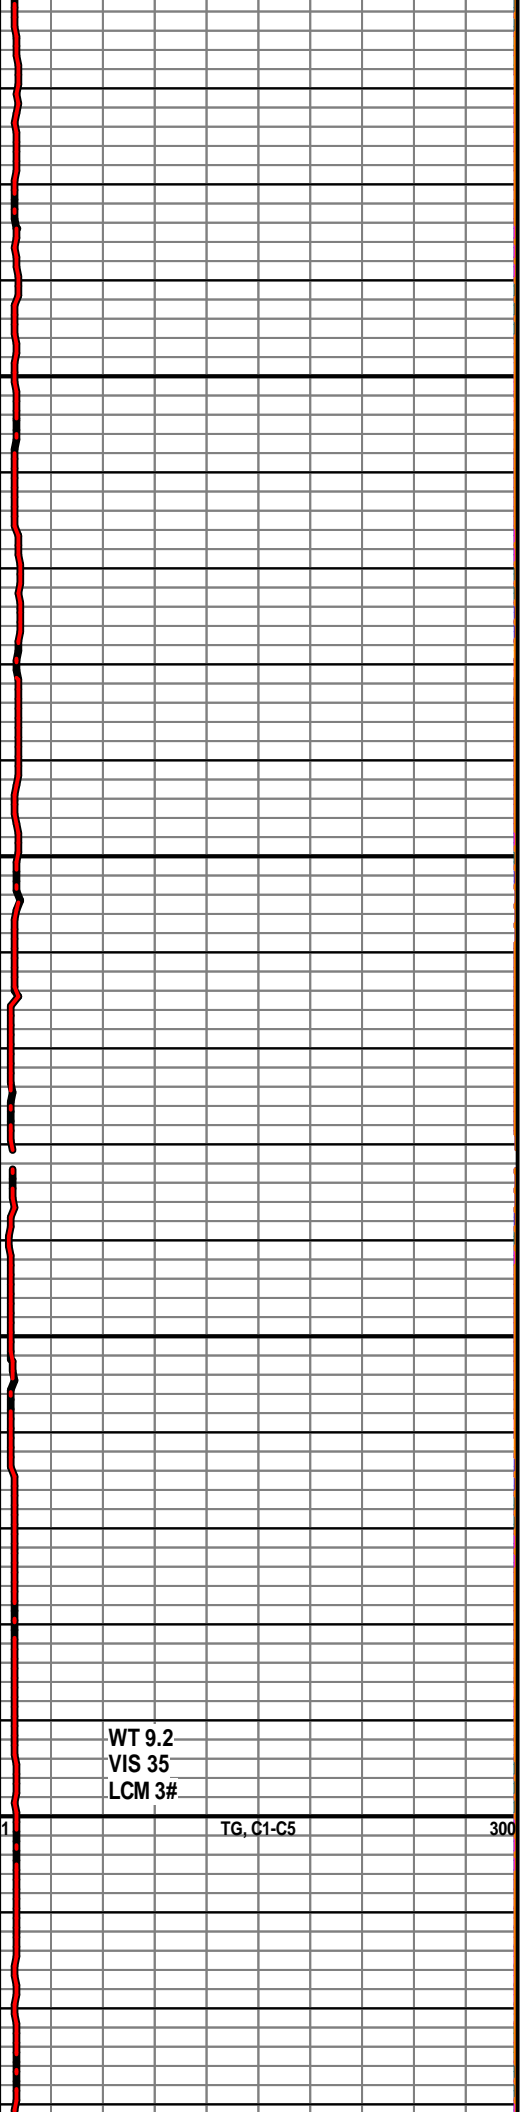


WT 9.2
VIS 35
LCM 3#

TG, C1-C5

0 10
3 Gamma Ray 150

300

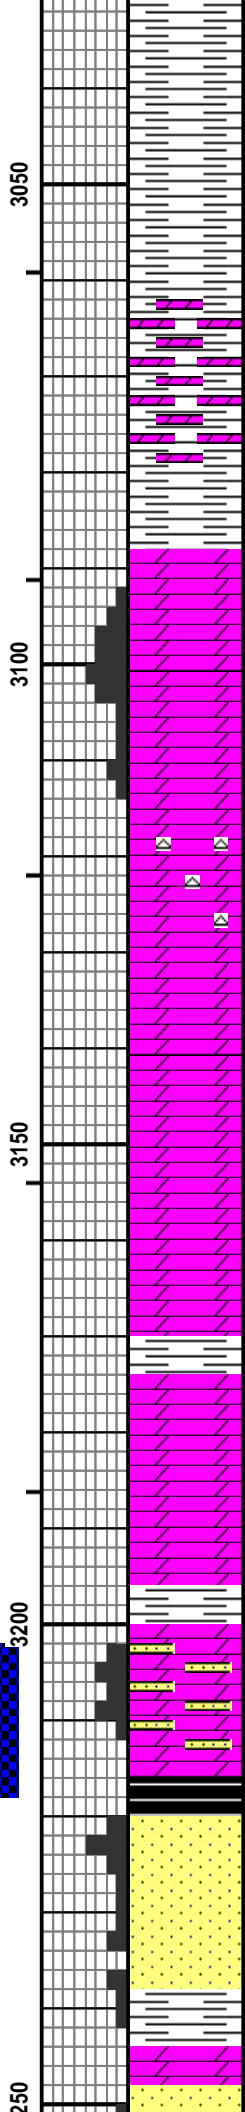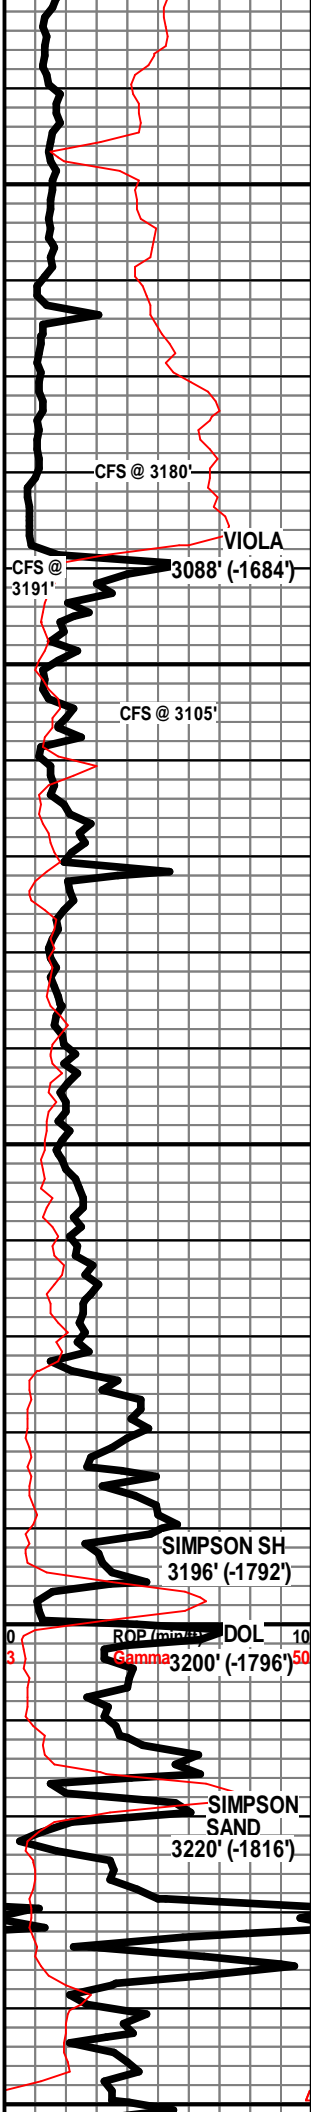

SH - LT GY, SLI DOLOMITIC

SH - LT GY / GY, SLI DOLOMITIC

DOLOMITIC SH - BRN / GY, F CUP ODOR, NO VIS POR, NSFO

SH - GY, SLI DOLOMITIC

DOLO - GY / TAN, F / M XLN, RHOMBIC IN PT, F / G INTERXLN POR, NS, NO ODOR, NO FLUOR

DOLO - LT GY / GY, F / M XLN, MOD DNS, F POR IN PT, NS

DOLO - TAN, F XLN, MOD DNS, NS, W/ SCAT CHT - TAN, FRSH, OPAQ

DOLO - TAN, F XLN, MOD DNS / DNS

DOLO - TAN / BRN, F XLN, MOD DNS

DOLO - BRN, F / M XLN, MOD DNS / DNS, W/ SH - GRN / GY BLK

SH - GRN / GY

DOLO - GY, F XLN, V SNDY, P / F INTERXLN & INTERGR POR, SSFO, HEAVY BLK OIL, G CUP ODOR, NO FLUOR

DOLO - DK GY, SNDY, NO VIS POR, NS, W/ SH - BLK, SLI CARB

SS - WHT / CLR, F GR, SUB-RND, PRED MOD CEM, FRI IN PT, F / G INTERGR POR, PRED BARREN, SSFO IN PT, TARRY OIL, F ODOR, NO FLUOR

SS - CLR / WHT, F GR, SUB-RND, W SRTD, W CEM, DNS, P INTERGR POR IN PT, SSFO IN FEW PIECES, ABUND OF DEAD OIL FLAKES, F ODOR, NO FLUOR

SS - GY / BRN / CLR IN PT, F GR, SUB-RND, W SRTD, MOD CEM, P INTERGR POR, PYRITIC IN PT

SH - GY / GRN, W/ DOLO - LT BRN / TAN, F XLN, DNS

WT 8.3
VIS 42
LCM 4#

DST #1 SIMPSON DOLOMITE
3202' - 3217'


IF: Weak blow built to 6 inches
ISI: No blowback
FF: No blow built to 13 inches
FSI: No blowback

Rec'd: 340' OSSMCW (Tr O, 89% W, 11% M)


SIP: 1086-1084#
FP: 21-70#, 76-161#
HP: 1598-1545#

TG, C1-C5 300

WT 9.2
VIS 49
LCM 5#

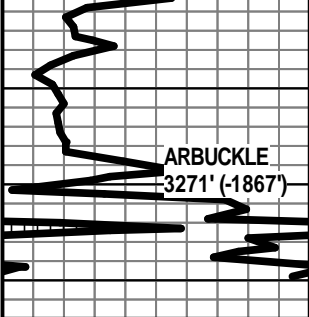

3271

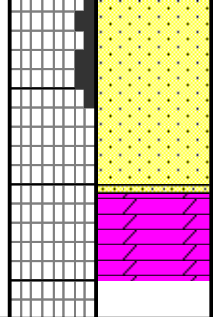


SS - WHT / GY, VF GR, W SRTD, MOD CEM, F
POR, NS, SCAT GRN SPECS, PYRITIC, ARG IN
PT

SS - TAN, VF / F GR, SUB-ANG, MOD SRTD, W
CEM, DNS, NO VIS POR, NS

DOLO - TAN / LT BRN, F / M XLN, V DNS

RTD 3280'

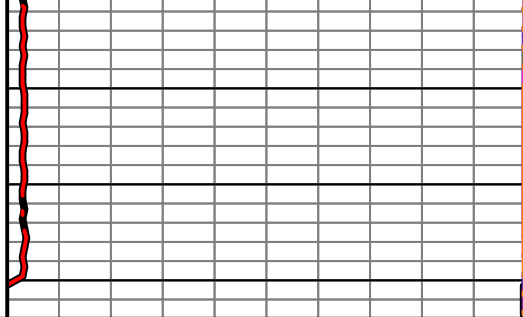

810 E 7TH
 PO Box 92
 EUREKA, KS 67045
 (620) 583-5561



Cement or Acid Field Report
 Ticket No. **4473**
 Foreman Kevin M. Coy
 Camp _____

API # 15-197-20307-00-00

Date	Cust. ID #	Lease & Well Number	Section	Township	Range	County	State
5-8-19	1264	J. R. Ranch # 1	24	145	11E	WABAUNSEE	KS
Customer		Safety Meeting KM AM SM	Unit #	Driver	Unit #	Driver	
Mailing Address			104	ALAN M.			
City			112	STEVE M.			
State	Zip Code						
MT. VERNON	IL	62864-0546					

Job Type SURFACE Hole Depth 315' K.B. Slurry Vol. 43 BBL Tubing _____
 Casing Depth 313.41' K.B. Hole Size 12 1/4 Slurry Wt. 15.0 # Drill Pipe _____
 Casing Size & Wt. 8 5/8" 23 # Cement Left in Casing 20' Water Gal/SK 6.5 Other _____
 Displacement 18.7 BBL Displacement PSI _____ Bump Plug to _____ BPM _____

Remarks: SAFETY Meeting: Rig up to 8 5/8 casing. BREAK CIRCULATION w/ 10 BBL FRESH WATER. MIXED 180 SKS CLASS "A" CEMENT w/ 3% CaCl2, 2% GEL @ 15 #/GAL, yield 1.35 = 43 BBL SLURRY. Displace w/ 18.7 BBL FRESH WATER. Shut casing in. Good Cement RETURNS to SURFACE = 12 BBL SLURRY to PIT. Job Complete. Rig down.

Code	Qty or Units	Description of Product or Services	Unit Price	Total
C 101	1	Pump Charge	890.00	890.00
C 107	75	Mileage	4.20	315.00
C 200	180 SKS	CLASS "A" Cement	15.75	2835.00
C 205	500 #	CaCl2 3%	.63 #	315.00
C 206	340 #	GEL 2%	.21 #	71.40
C108 B	8.46 TONS	TON Mileage 75 miles	1.40	888.30
			Sub TOTAL	5314.70
			Less 5%	278.62
			Sales Tax	257.71
Authorization <u>witnessed By Judd Gulick</u> Title <u>C & G Dely Tool pusher</u>			Total	5293.79

I agree to the payment terms and conditions of services provided on the back of this job ticket. Any amendments to payment terms must be in writing on the front of this job ticket or in the Customer's records at ELITE's office.

810 E 7TH
 PO Box 92
 EUREKA, KS 67045
 (620) 583-5561



Cement or Acid Field Report
 Ticket No. **4475**
 Foreman Kevin McCoy
 Camp EUREKA

APZ # 15-197-20309-00-00

Date	Cust. ID #	Lease & Well Number	Section	Township	Range	County	State
5-15-19	1264	J. R. RANCH # 1	24	14S	11E	WABARUNSEC.	Ks
Customer <u>STEWART PRODUCERS, INC.</u>			Safety Meeting KM AM CG	Unit # 104 115	Driver ALAN M. CALEB G.	Unit #	Driver
Mailing Address <u>P.O. Box 546</u>			City <u>MT. VERNON</u>		State <u>IL</u>	Zip Code <u>62864-0546</u>	

Job Type P.T.A. ^{NEW} WELL Hole Depth 3280' K.B. Slurry Vol. _____ Tubing _____
 Casing Depth _____ Hole Size 7 7/8" Slurry Wt. _____ Drill Pipe 4 1/2
 Casing Size & Wt. _____ Cement Left in Casing _____ Water Gal/SK _____ Other _____
 Displacement _____ Displacement PSI _____ Bump Plug to _____ BPM _____

Remarks: SAFETY Meeting: Rig up to 4 1/2 DRILL Pipe. Plug well AS following.

15 SKS @ 3130' SIMPSON
15 SKS @ 3020' VIOLA
15 SKS @ 2890' HUNTON
15 SKS @ 2440 MISS
25 SKS @ 1535 KC
35 SKS @ 350'
25 SKS @ 60'
30 SKS R.H.
20 SK M.H.

Code	Qty or Units	Description of Product or Services	Unit Price	Total
C 103	1	Pump Charge	1100.00	1100.00
C 107	75	Mileage	4.20	315.00
C 203	195 SKS	60/40 Pozmix Cement	13.40	2613.00
C 206	670 #	Gel 4%	.21 *	140.70
C 108 B	8.39 TONS	TON MILEAGE	1.40	880.95
			<u>Sub Total</u>	<u>5049.65</u>
			<u>Less 5%</u>	<u>263.50</u>
			<u>Sales Tax</u>	<u>220.30</u>
			<u>8.0%</u>	<u>220.30</u>

Authorization witnessed By Judd Gulick Title C#6 Toolpusher Total 5006.45

I agree to the payment terms and conditions of services provided on the back of this job ticket. Any amendments to payment terms must be in writing on the front of this job ticket or in the Customer's records at ELITE's office.



TRILOBITE TESTING, INC.

DRILL STEM TEST REPORT

Stewart Producers, Inc.

24/14S/11E Wabaunsee, KS

301 North 27th Street
 P.O. Box 546
 Mount Vernon, IL 62864-0546
 ATTN: Mark Thompson/Aaron

JR Ranch #1

Job Ticket: 63945

DST#: 1

Test Start: 2019.05.13 @ 03:39:00

GENERAL INFORMATION:

Formation: **Simpson**

Deviated: No Whipstock: ft (KB)

Time Tool Opened: 05:46:20

Time Test Ended: 11:59:00

Test Type: Conventional Bottom Hole (Initial)

Tester: Jimmy Ricketts

Unit No: 80

Interval: 3202.00 ft (KB) To 3217.00 ft (KB) (TVD)

Reference Elevations: 1404.00 ft (KB)

Total Depth: 3217.00 ft (KB) (TVD)

1395.00 ft (CF)

Hole Diameter: 7.88 inches Hole Condition: Fair

KB to GR/CF: 9.00 ft

Serial #: 8369 Outside

Press@RunDepth: 161.11 psig @ 3203.00 ft (KB)

Capacity: 8000.00 psig

Start Date: 2019.05.13

End Date: 2019.05.13

Last Calib.: 2019.05.13


Start Time: 03:39:01

End Time: 11:59:00

Time On Btm: 2019.05.13 @ 05:45:50

Time Off Btm: 2019.05.13 @ 08:52:00

TEST COMMENT: IF - Weak blow building to 6 inches during initial flow period.
 FF - No blow building to 13 inches during final flow period.

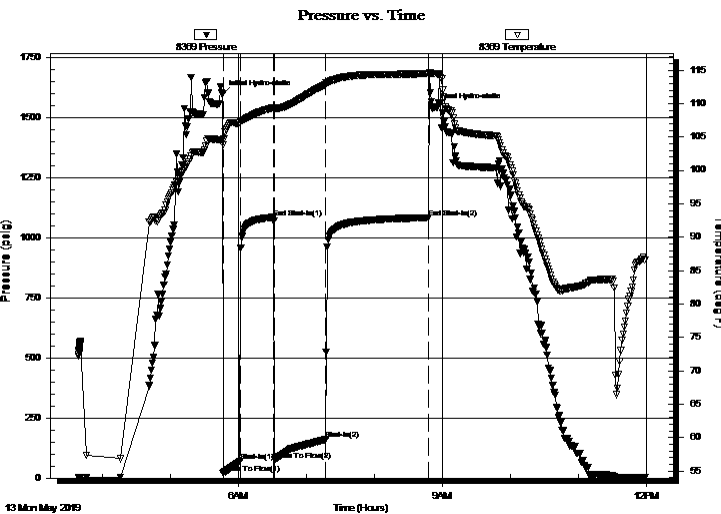

PRESSURE SUMMARY

Time (Min.)	Pressure (psig)	Temp (deg F)	Annotation
0	1597.98	104.54	Initial Hydro-static
1	21.20	103.80	Open To Flow (1)
16	70.29	107.11	Shut-In(1)
46	1085.71	109.37	End Shut-In(1)
46	76.10	109.07	Open To Flow (2)
92	161.11	112.82	Shut-In(2)
182	1084.45	114.48	End Shut-In(2)
187	1544.77	114.48	Final Hydro-static

Recovery

Length (ft)	Description	Volume (bbl)
340.00	OSSMCW TR O 89% W 11% M	2.54

Gas Rates

	Choke (inches)	Pressure (psig)	Gas Rate (Mcf/d)



**TRILOBITE
TESTING, INC.**

DRILL STEM TEST REPORT

FLUID SUMMARY

Stewart Producers, Inc.

24/14S/11E Wabaunsee, KS

301 North 27th Street
P.O. Box 546
Mount Vernon, IL 62864-0546
ATTN: Mark Thompson/Aaron

JR Ranch #1

Job Ticket: 63945

DST#: 1

Test Start: 2019.05.13 @ 03:39:00

Mud and Cushion Information

Mud Type: Gel Chem

Cushion Type:

Oil API:

deg API

Mud Weight: 10.00 lb/gal

Cushion Length:

ft

Water Salinity:

8000 ppm

Viscosity: 35.00 sec/qt

Cushion Volume:

bbbl

Water Loss: 11.79 in³

Gas Cushion Type:

Resistivity: ohm.m

Gas Cushion Pressure:

psig

Salinity: 1200.00 ppm

Filter Cake: inches

Recovery Information

Recovery Table

Length ft	Description	Volume bbbl
340.00	OSSMCW TR O 89% W 11% M	2.537

Total Length: 340.00 ft Total Volume: 2.537 bbl

Num Fluid Samples: 0


Num Gas Bombs: 0

Serial #:

Laboratory Name:

Laboratory Location:

Recovery Comments:

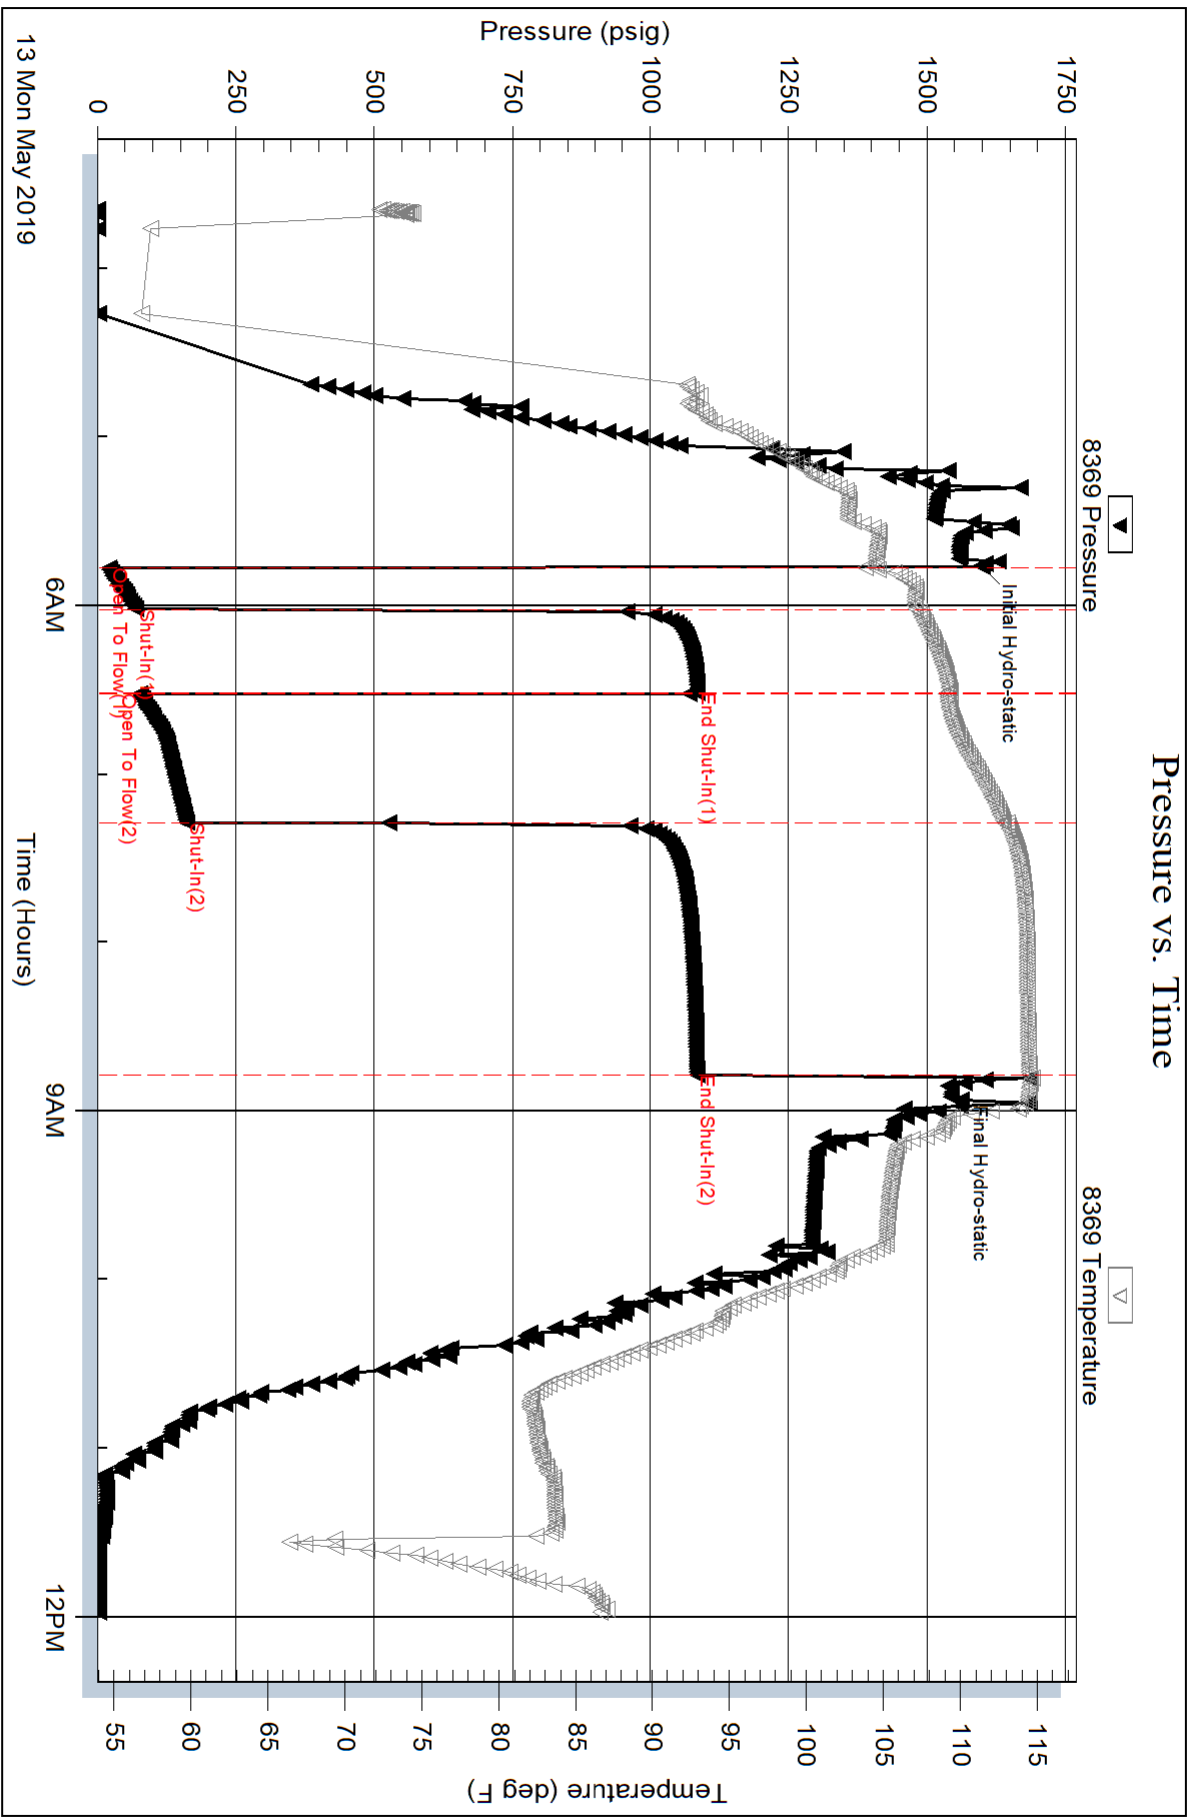


Serial #: 8846

Inside

Stewart Producers, Inc.

JR Ranch #1

DST Test Number: 1

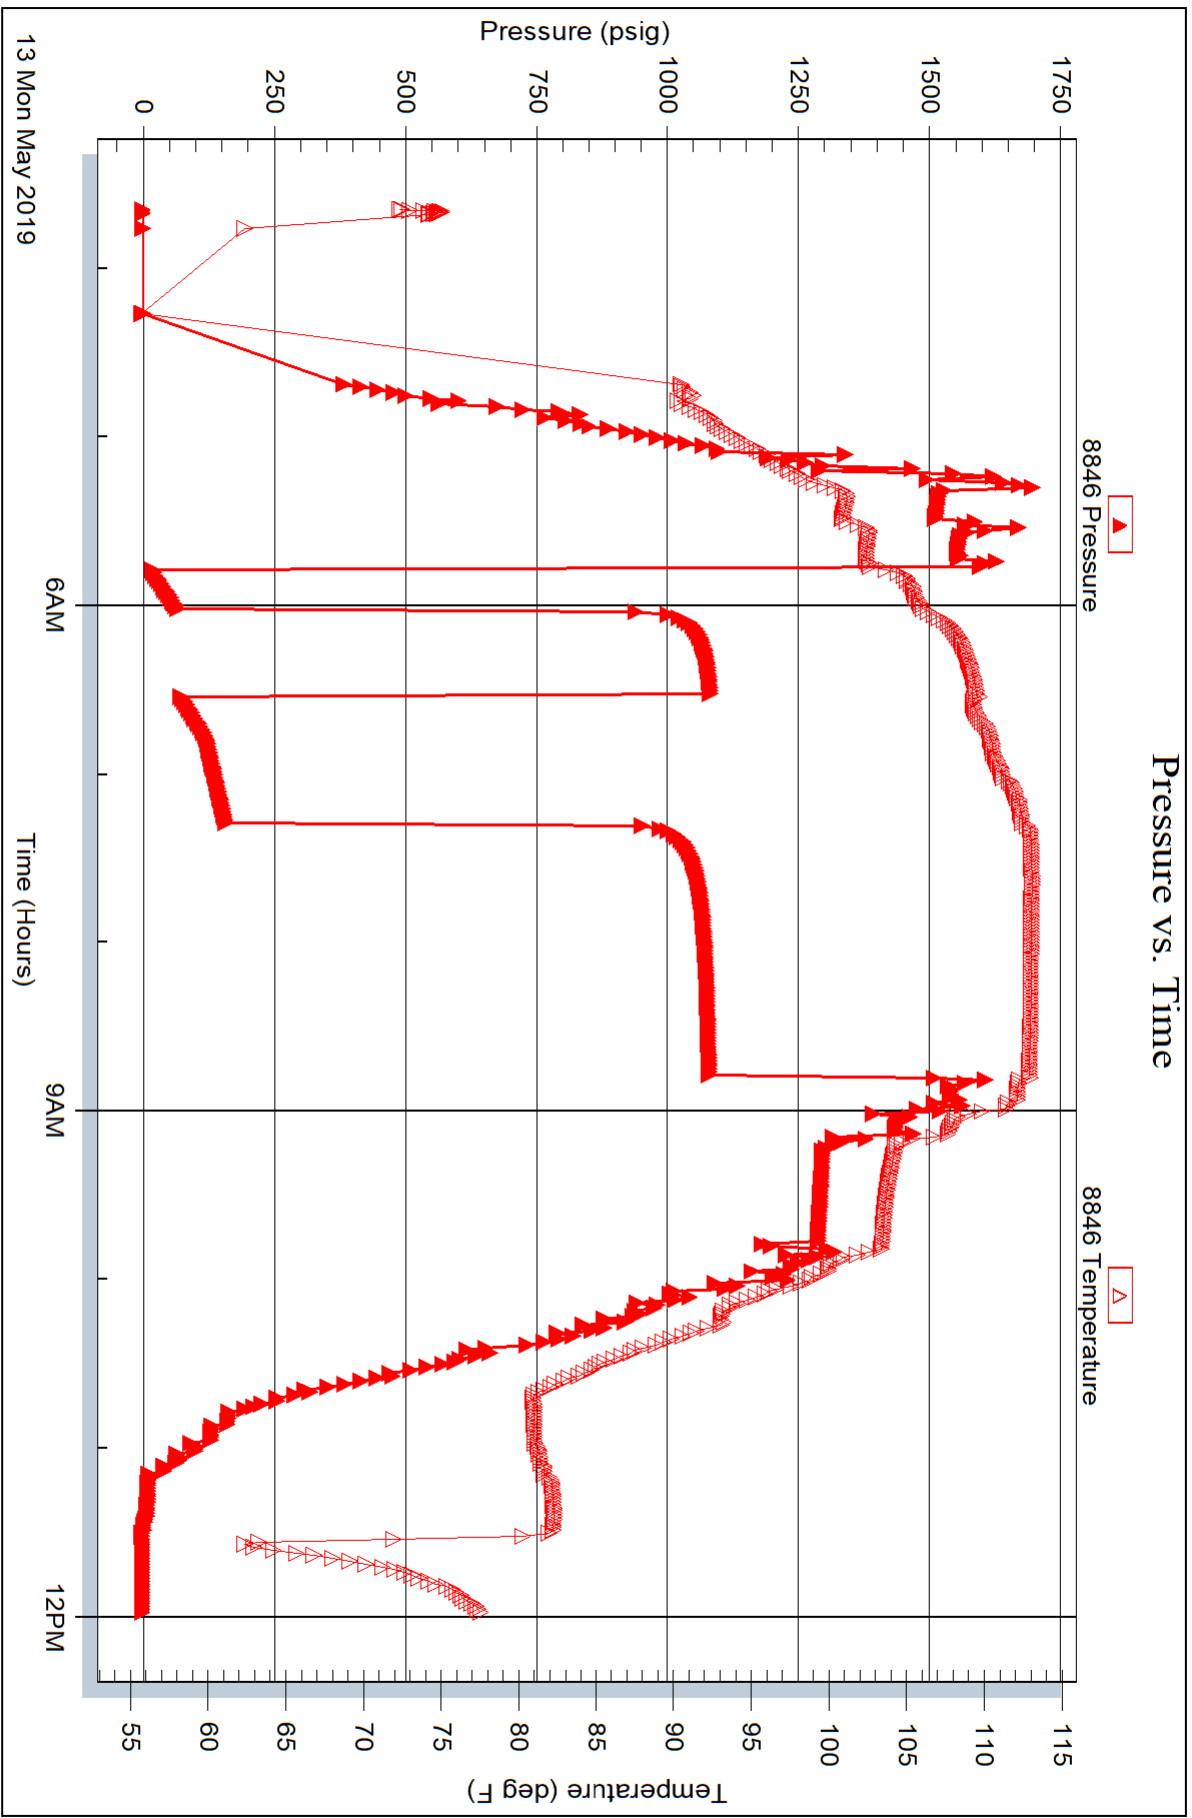

Trilobite Testing, Inc

Ref. No: 63945

Printed: 2019.05.13 @ 13:36:30