
MULL DRILLING COMPANY, INC. COMSTOCK LEASE NE. 1/4, SECTION 4, T32S, R22W CLARK COUNTY, KANSAS

Directions;

Princettonis, from the intersection of Highway 160 and 20 road/Clark Co. Lake Rd. (at the east edge of Ashland, Ks.) go 5.36 miles North to a 3-way intersection at Creek D Road, then go 2.08 miles East on Creek D Rd. to a trail north, then go 1.14 miles North on a trail to a flagged gate, then go 0.51 miles Northeast to location.

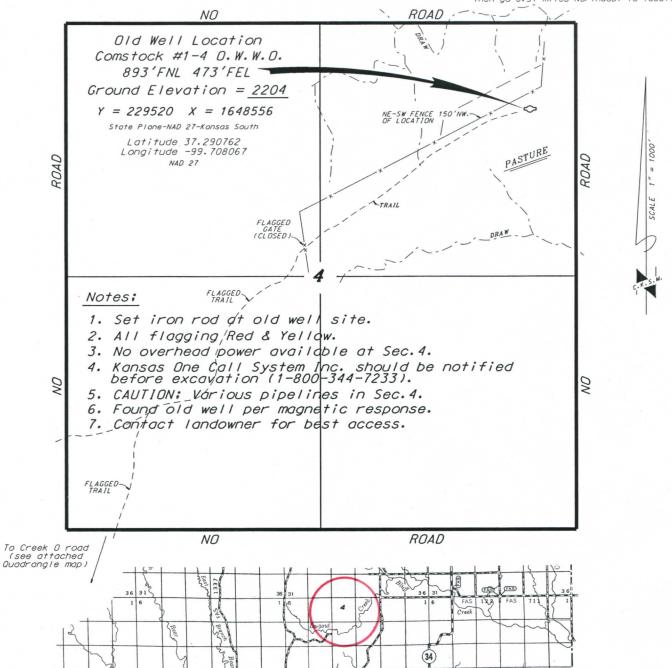

160

ASHLAND

3

Elevations derived from National Geodetic Vertical Datum

*Ingress plat is opened f

June 27, 2019

EAS

FAS Sitka

FAS 5004

[⊯] Controlling data is based upon the best maps and photographs available to us and upon a regular section of land containing 640 acres.

Approximate section lines were determined using the normal standard of care of oilfield surveyors practicing in the state of Kansas. The section corners, which establish the precise section lines, were not necessarily located, and the exact location of the drillsite location in the section is not guaranteed. Therefore, the operator securing this service and accepting this plat and all other parties relying thereon agree to hold Central Kansas Diffield Services. Inc. is officers and employees harmless from all losses, costs and expenses and sold entities released from any liability from incidental or consequential damages.