



# Fall & Associates

Stake and Elevation Service

P.O. Box 222

Pretty Prairie, KS. 67570

785-243-7506

Date 6-10-19

Invoice Number 0609191

MERIDIAN ENERGY

1-2

Sabatka

Operator

Number

Farm Name

Rawlins-KS

2

1s

35w

2370'FNL 2310'FWL

County-State

S

T

R


Location

Meridian Energy  
1475 N Ward Circle  
Franktown, CO 80116

Elevation 3057 Gr.

Ordered By: Weston

Scale 1"=1000'

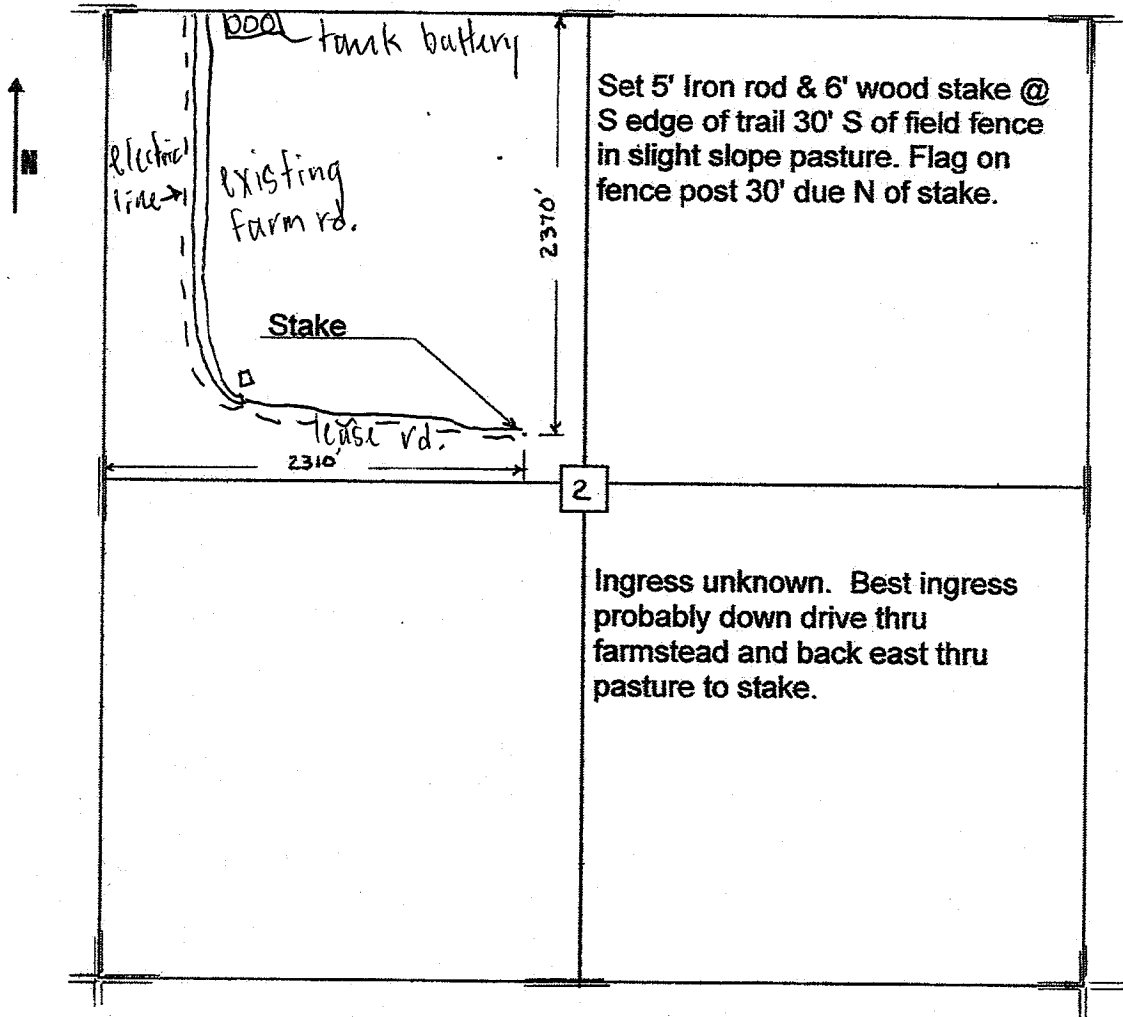

Set 5' Iron rod & 6' wood stake @ S edge of trail 30' S of field fence in slight slope pasture. Flag on fence post 30' due N of stake.

Ingress unknown. Best ingress probably down drive thru farmstead and back east thru pasture to stake.