

Stelbar Oil Corp. Inc.
OPERATOR

Scott County, KS
COUNTY

Riney Trust #2-23
LEASE NAME

1338' FNL - 1773' FEL
LOCATION SPOT

2972.7'
GR ELEVATION

38.479193
NAD 27 LAT

100.820301
NAD 27 LONG

24-18s-32w-bar-999
CRD NO.


00-18s-32w
DMT NO.

PRO-STAKE
LLC
Construction Site Staking

P.O. Box 2324 Garden City, Kansas 67846
Office/Fax: (620) 276-6159 — Cell: (620) 272-1499
burt@prostakellc.com

14307
INVOICE NO.

LEGEND

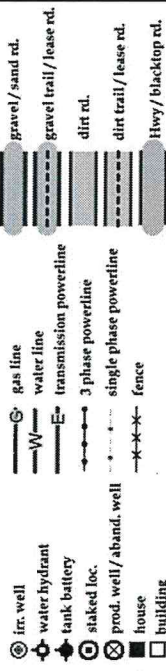

DIRECTIONS: From the center of Scott City, KS at the intersection of Hwy. 96 & Hwy 83 — Now go 5 miles East on Hwy. 96 to the NE corner of section 23-18-32w — Now go approx. 0.25 miles South on Quiveria Rd. to ingress stake W into — Now go approx. 0.3 miles West (on wheat stubble) into staked location

Final ingress must be verified with landowner or operator.

*This drawing does not constitute a monumented survey or a land survey plat.
This drawing is for construction purposes only.*



SCALE: 1" = 1000'
DATE STAKED: July 15th, 2019
MEASURED BY: Pierce R.
DRAWN BY: Pierce R.
AUTHORIZED BY: Roscoe M.
DATE REVISED:

LANDOWNER/CONTACT: Gary Janssen (tenant): 620-874-4410

