


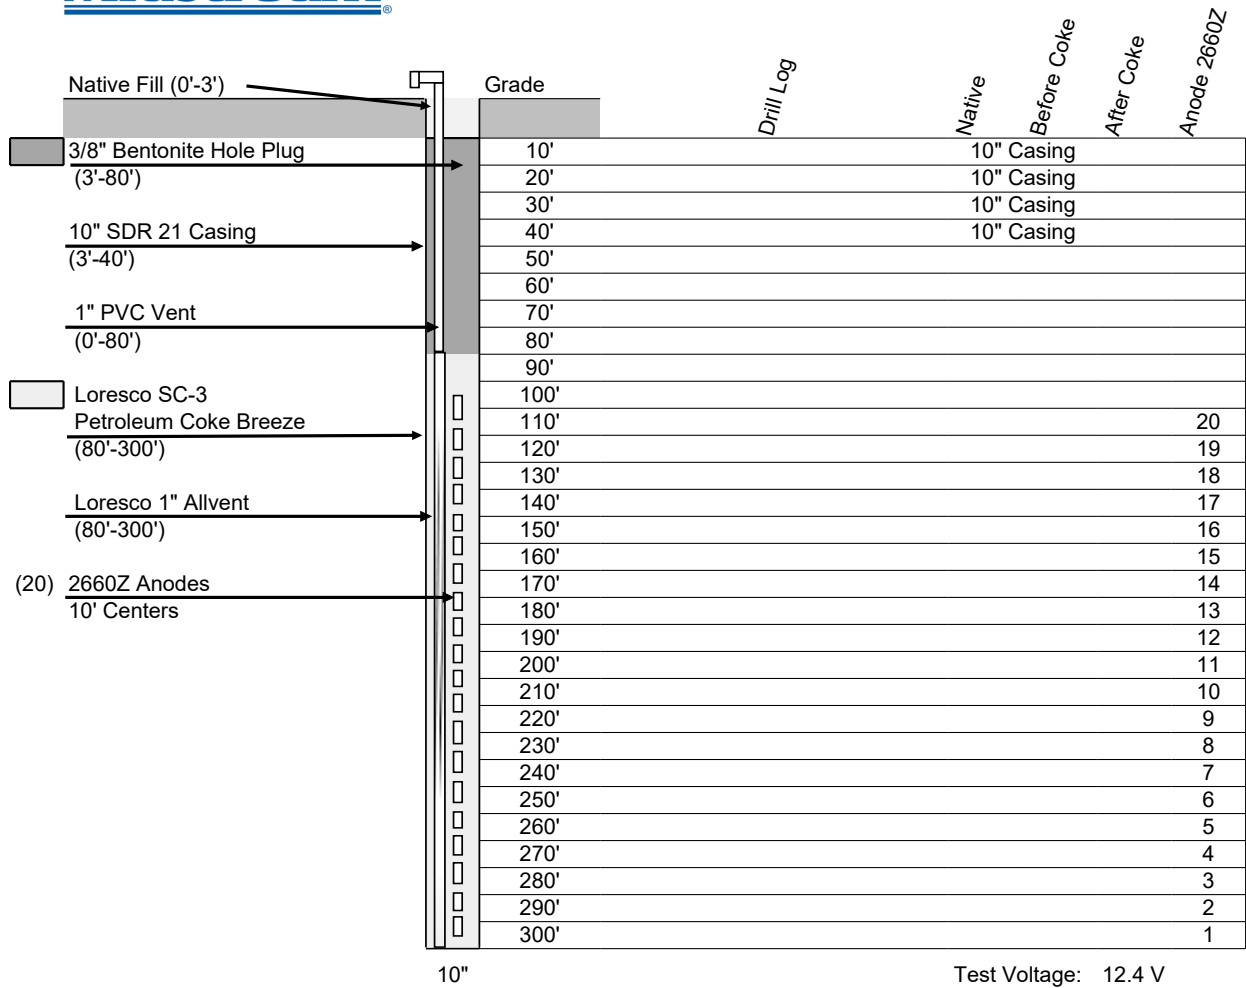

CATHODIC PROTECTION HOLE COMPLETION DIAGRAM & DRILL LOG

Installed by:

Installed for:

Rose Rock Midstream

Date:

TBD

Location:

220th Ave Groundbed

GPS:

38.112310, -99.295827

Technician:

Randy Crank