

**Plat and Certificate of Injection Well Location and Surrounding Acreages**


Operator: CG OIL, INC. Location of Well: SW SW NE

Lease: Wil 2310 Feet from SOUTH Section Line

Well Number: 1 2310 Feet from EAST Section Line

County: Ellis Sec. 22 Twp. 13 S. R. 16  East  West

**Plat**  
Show the following information: applicant injection well, all producing wells, inactive wells, plugged wells, and other wells within a one-half mile radius, all lease boundaries, lease operators, unleased mineral rights owners, well numbers, and producing wells producing formation tops.

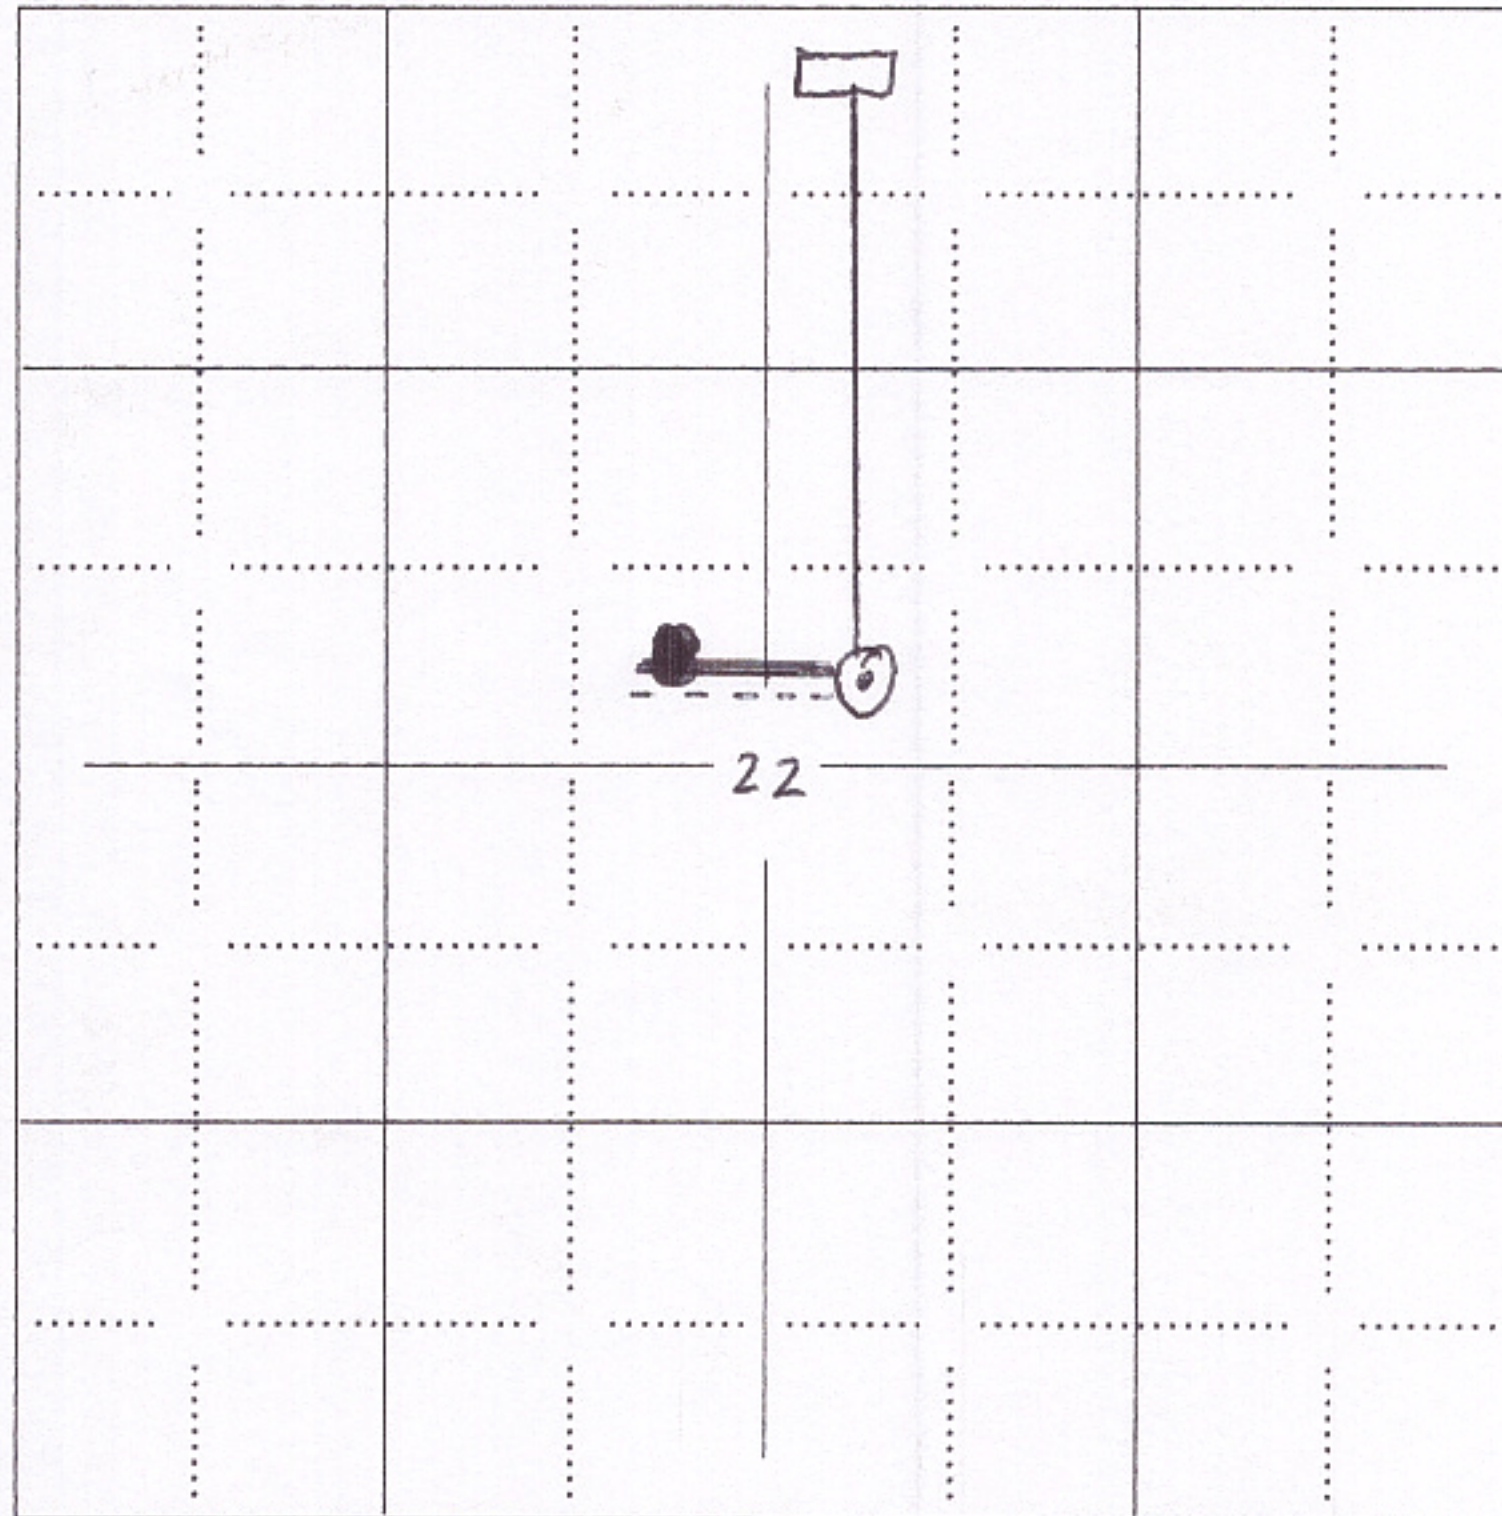

- applicant well
- producing well
- plugged injection well
- D & A well
- other injection well
- temporary abandoned well
- plugged producer
- water supply well

The undersigned hereby certifies that he / she is a duly authorized agent for \_\_\_\_\_, and that all of the information shown herein is true, complete and correct to the best of his / her knowledge.

\_\_\_\_\_  
*Applicant or Duly Authorized Agent*

Subscribed and sworn before me this \_\_\_\_\_ day of \_\_\_\_\_, \_\_\_\_\_

\_\_\_\_\_  
*Notary Public*

My Commission Expires: \_\_\_\_\_