


Plat and Certificate of Injection Well Location and Surrounding Acreages

Operator: CG Oil, Inc. Location of Well: NW NW SE
 Lease: MRS 2310 Feet from SOUTH Section Line
 Well Number: 1 2310 Feet from EAST Section Line
 County: Ellis Sec. 22 Twp. 13 S. R. 16 East West

Plat

Show the following information: applicant injection well, all producing wells, inactive wells, plugged wells, and other wells within a one-half mile radius, all lease boundaries, lease operators, unleased mineral rights owners, well numbers, and producing wells producing formation tops.

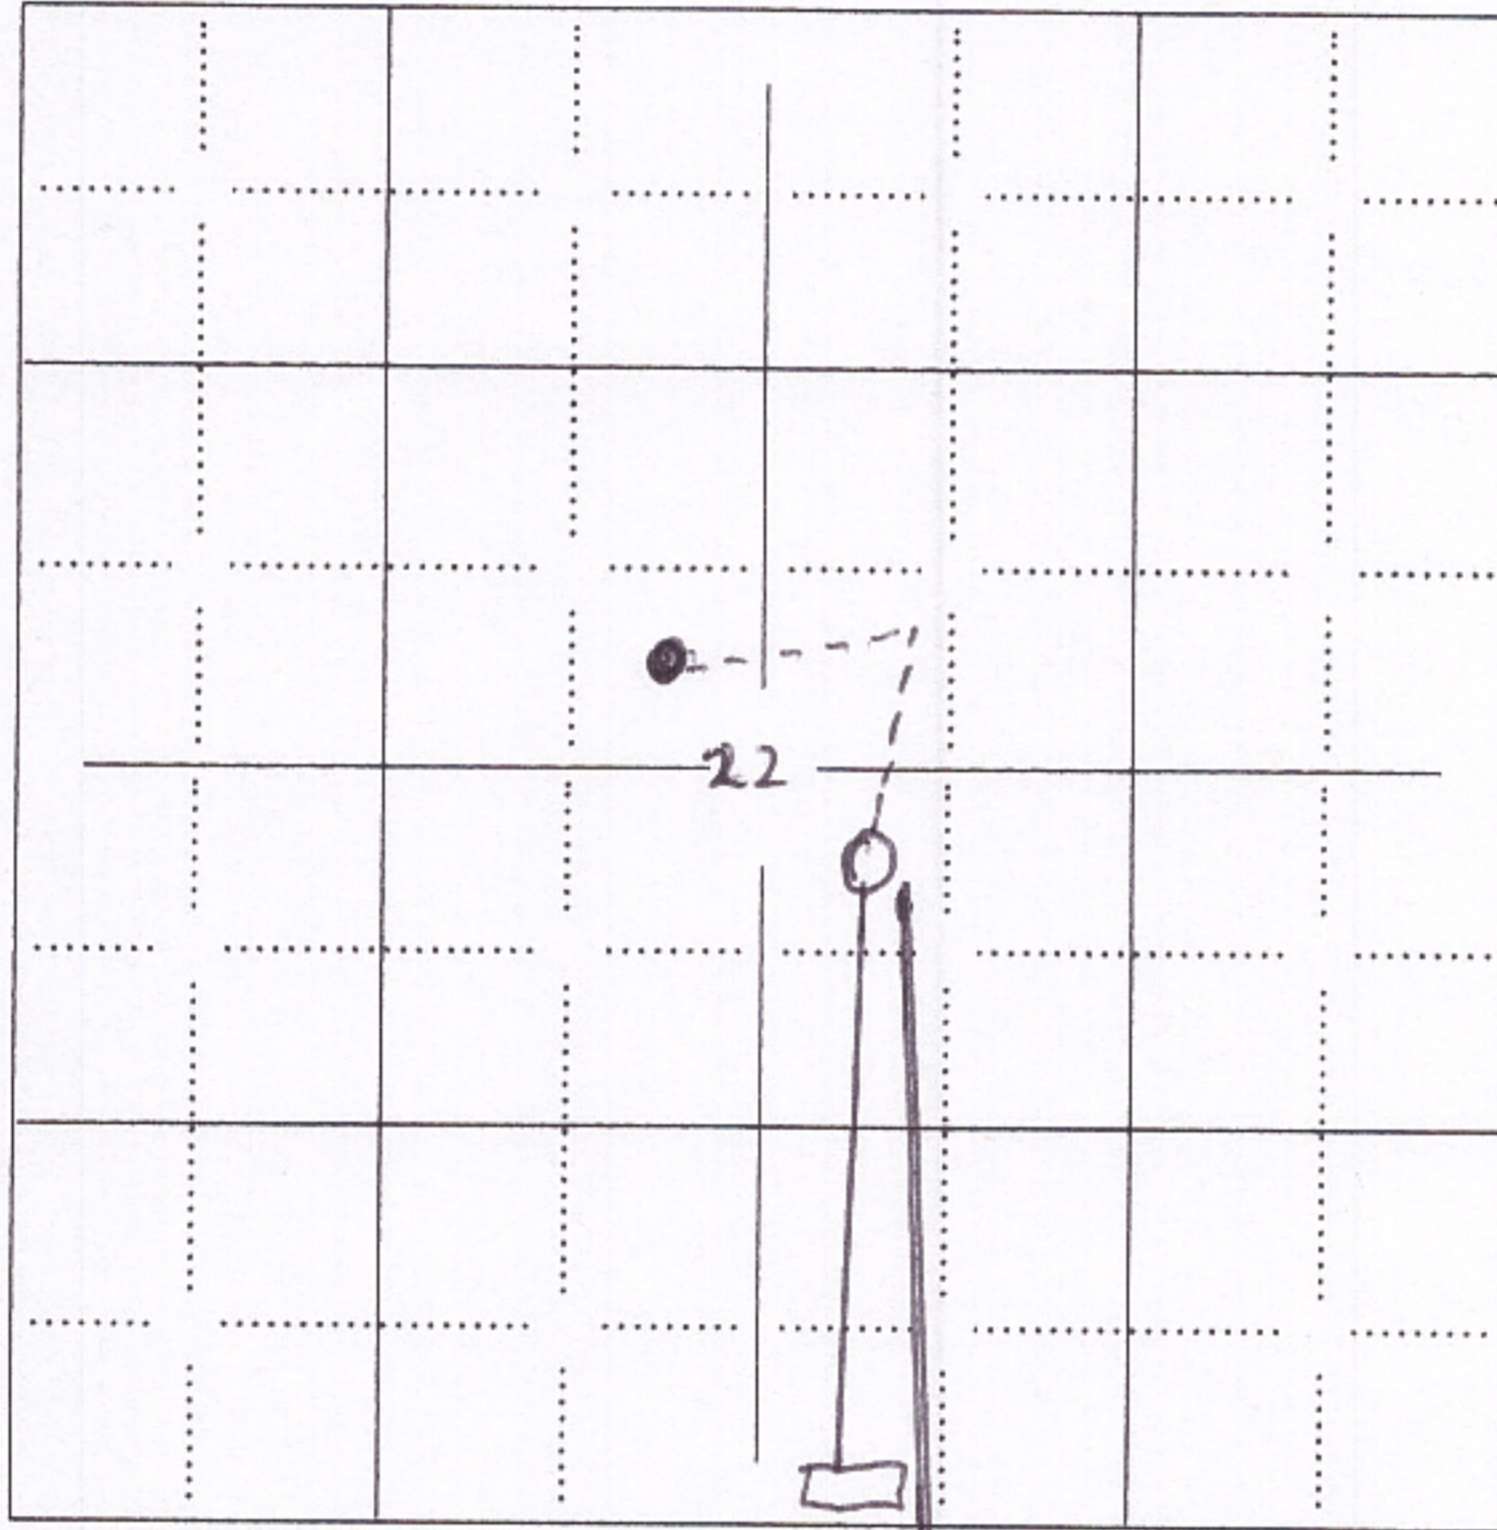

- applicant well
- producing well
- plugged injection well
- D & A well
- other injection well
- temporary abandoned well
- plugged producer
- water supply well

The undersigned hereby certifies that he / she is a duly authorized agent for _____, and that all of the information shown herein is true, complete and correct to the best of his / her knowledge.

Applicant or Duly Authorized Agent

Subscribed and sworn before me this _____ day of _____,

Notary Public

My Commission Expires: _____