



VINCENT OIL CORPORATION
 TORLINE LEASE
 NE.1/4, SECTION 10, T29S, R23W
 FORD COUNTY, KANSAS

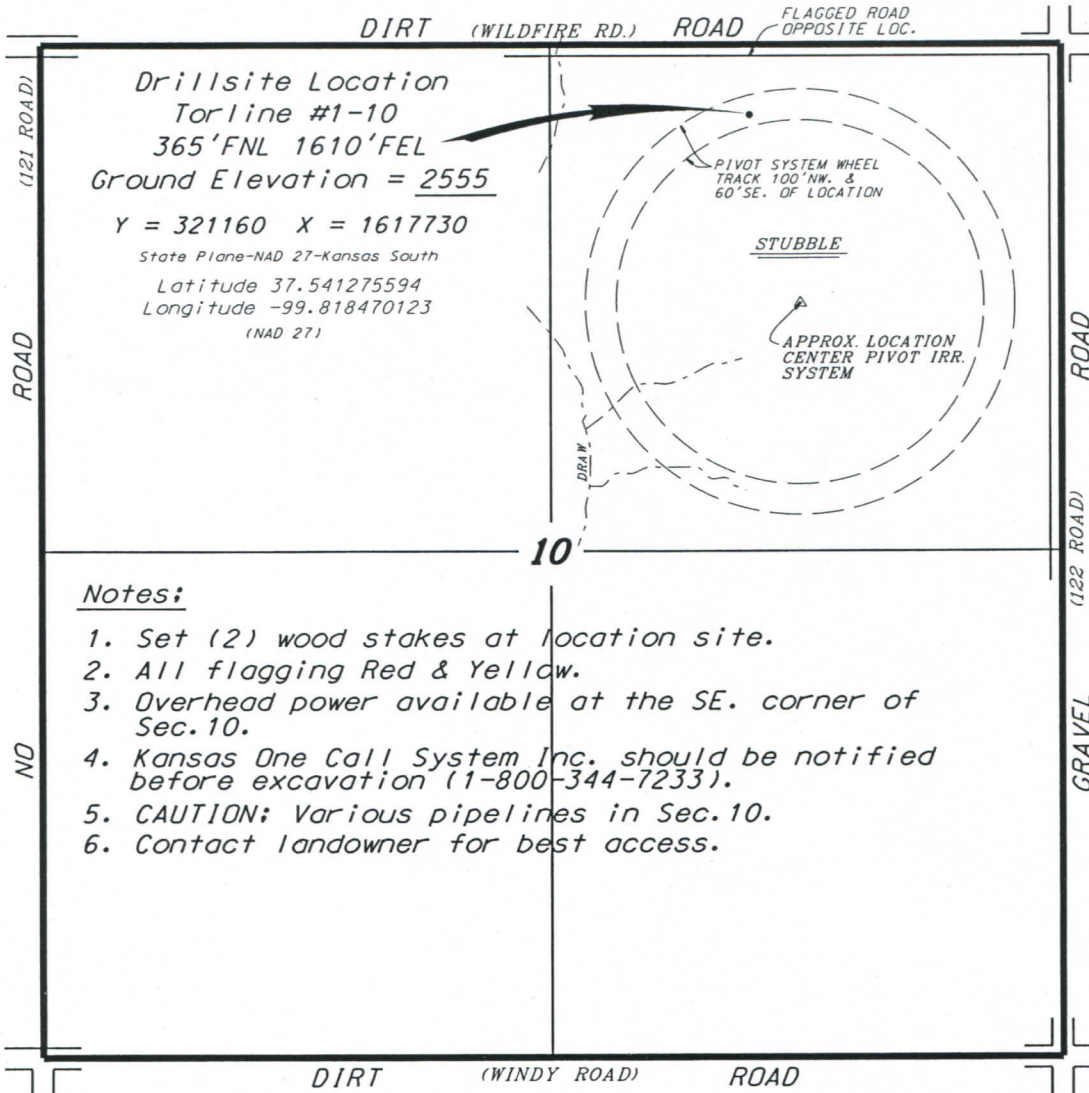

Notes:



1. Set (2) wood stakes at location site.
2. All flagging Red & Yellow.
3. Overhead power available at the SE. corner of Sec. 10.
4. Kansas One Call System Inc. should be notified before excavation (1-800-344-7233).
5. CAUTION; Various pipelines in Sec. 10.
6. Contact landowner for best access.

* Ingress and egress to location as shown on this plat is per usage only and may not be legally opened for public use. Contact landowner, tenant and county road department for access.

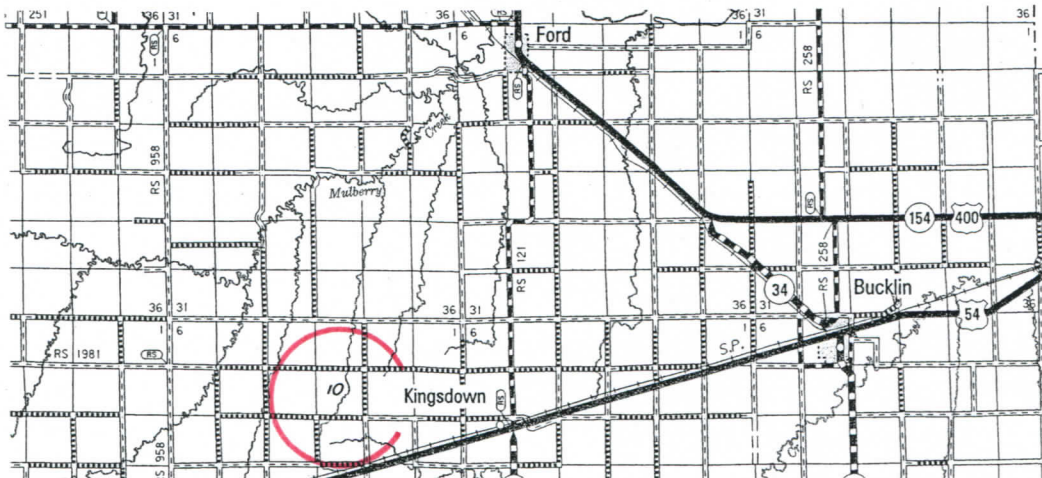

* Controlling data is based upon the best maps and photographs available to us and upon a regular section of land containing 640 acres.
 * Approximate section lines were determined using the normal standard of care of oilfield surveyors practicing in the state of Kansas. The section corners, which establish the precise section lines, were not necessarily located, and the exact location of the drillsite location in the section is not guaranteed. Therefore, the operator securing this service and accepting this plat and all other parties relying thereon agree to hold Central Kansas Oilfield Services, Inc., its officers and employees harmless from all losses, costs and expenses and said entities released from any liability from incidental or consequential damages.
 * Elevations derived from National Geodetic Vertical Datum.

Date July 29, 2019

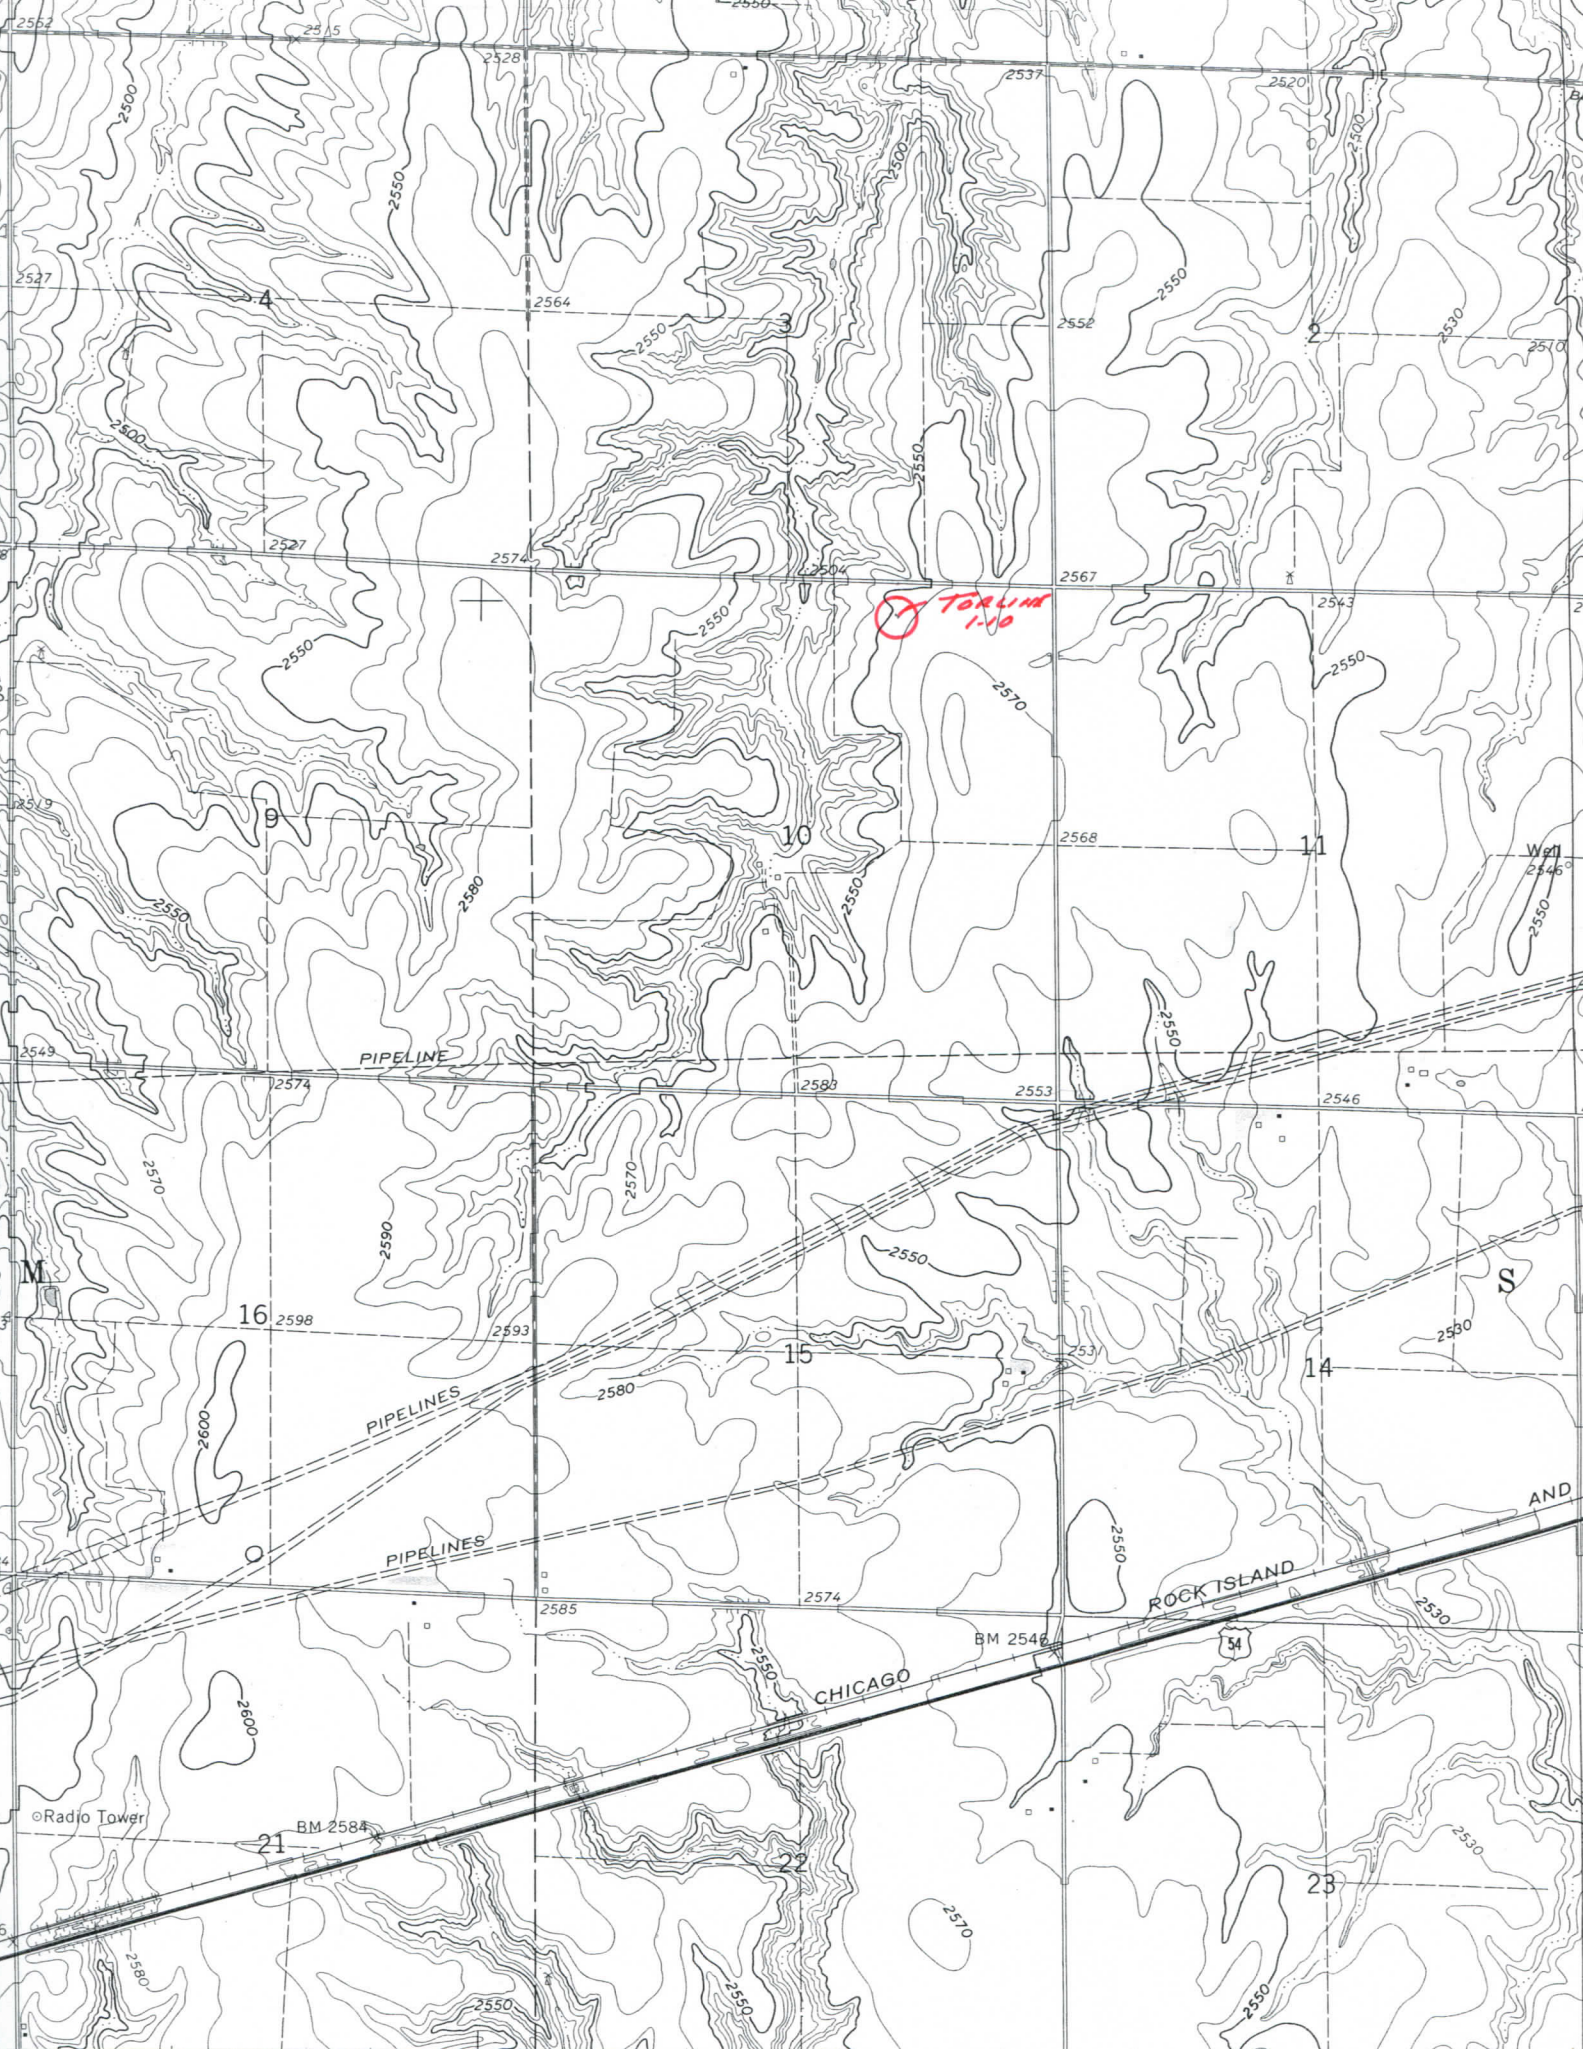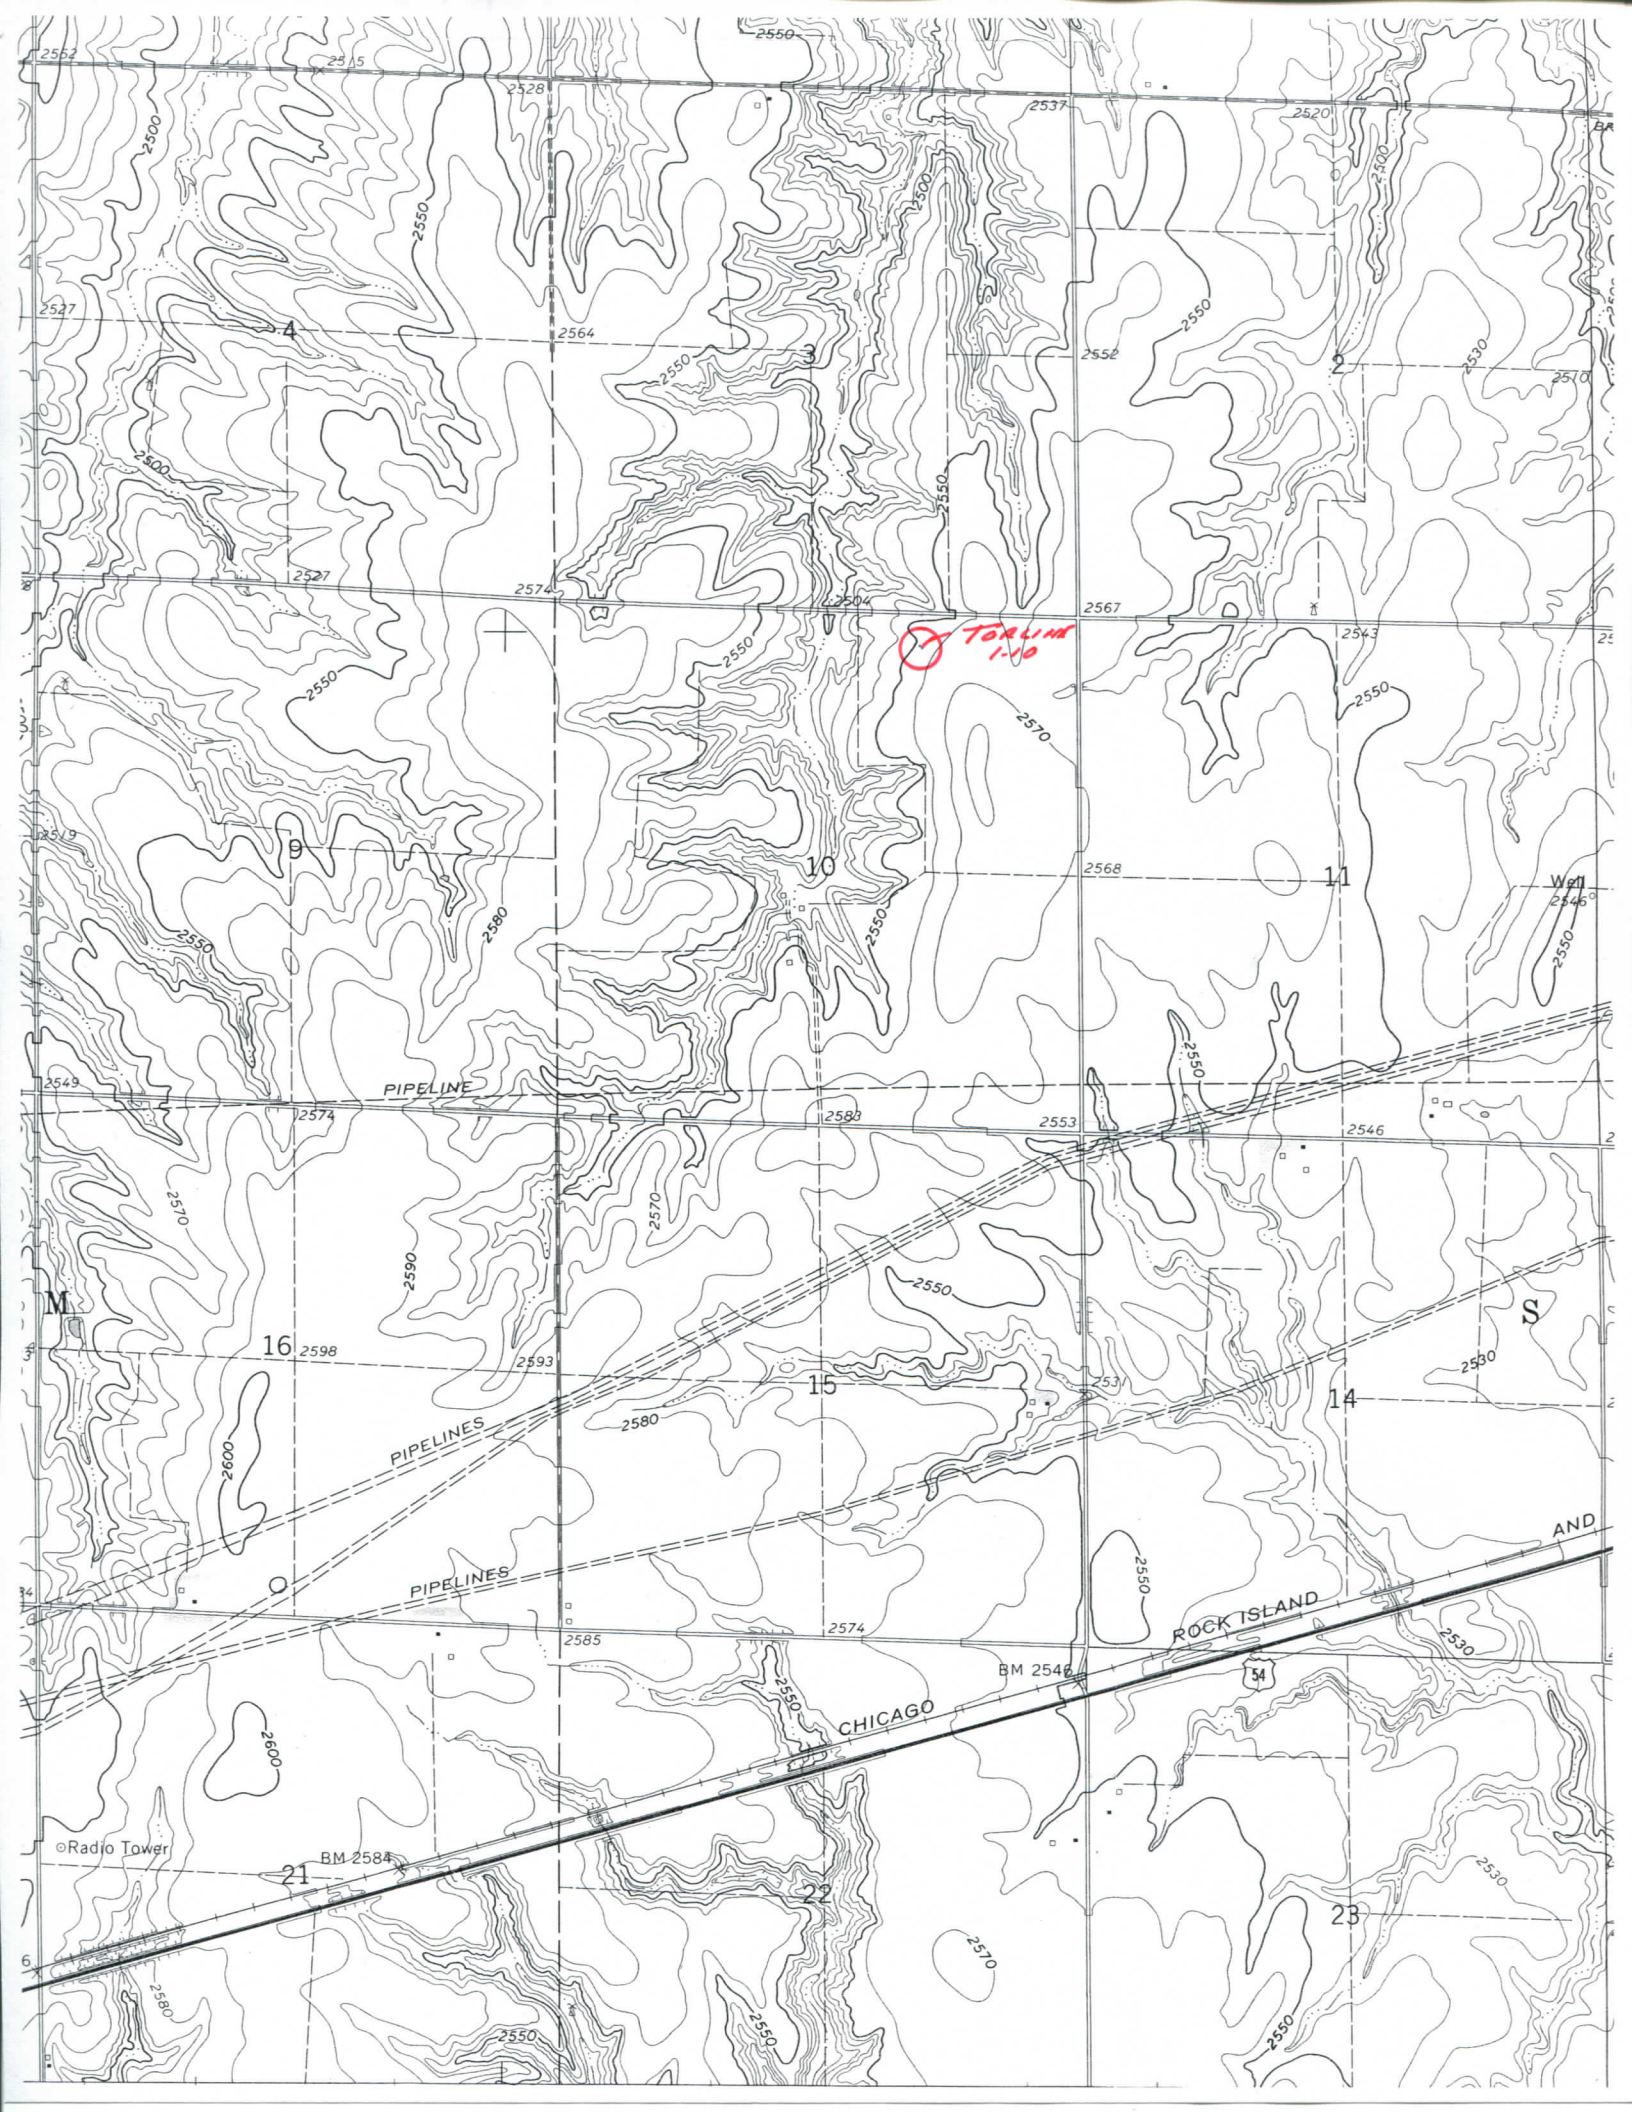

TORUM
1-10

PIPELINE

PIPELINES

PIPELINES

CHICAGO

ROCK ISLAND

AND

Radio Tower

BM 2584

BM 2546

Well
2546