


The Bill Bowman Oil Company
 Eunice Berland #1 NW SW NW NE
 of 520-T10S-R19W, Rooks County, Kansas

8-7-2019
 Amended map

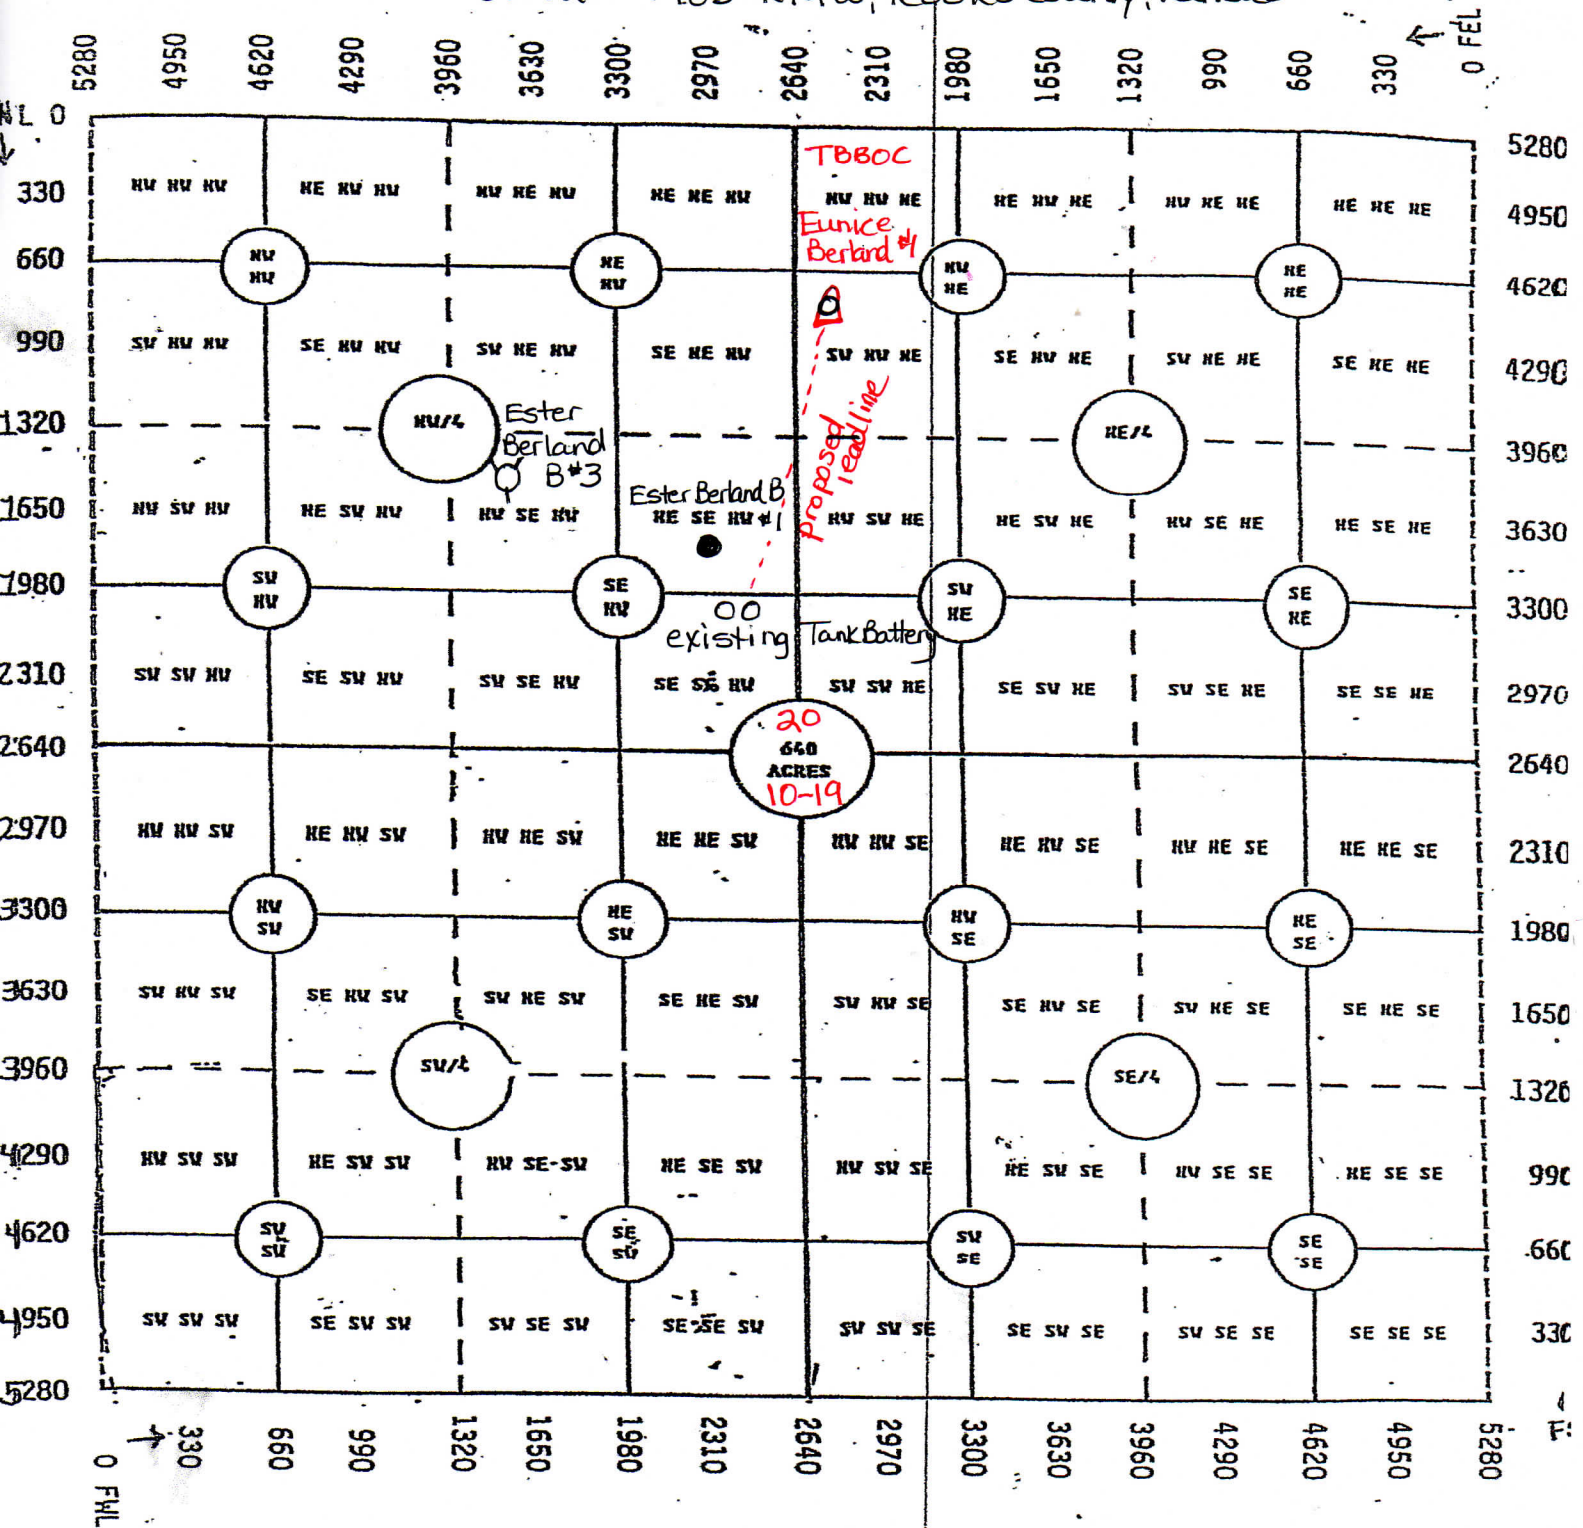

Amended footages
 was 4520' FSL
 2500' FEL

now is 4532' FSL
 2500' FEL