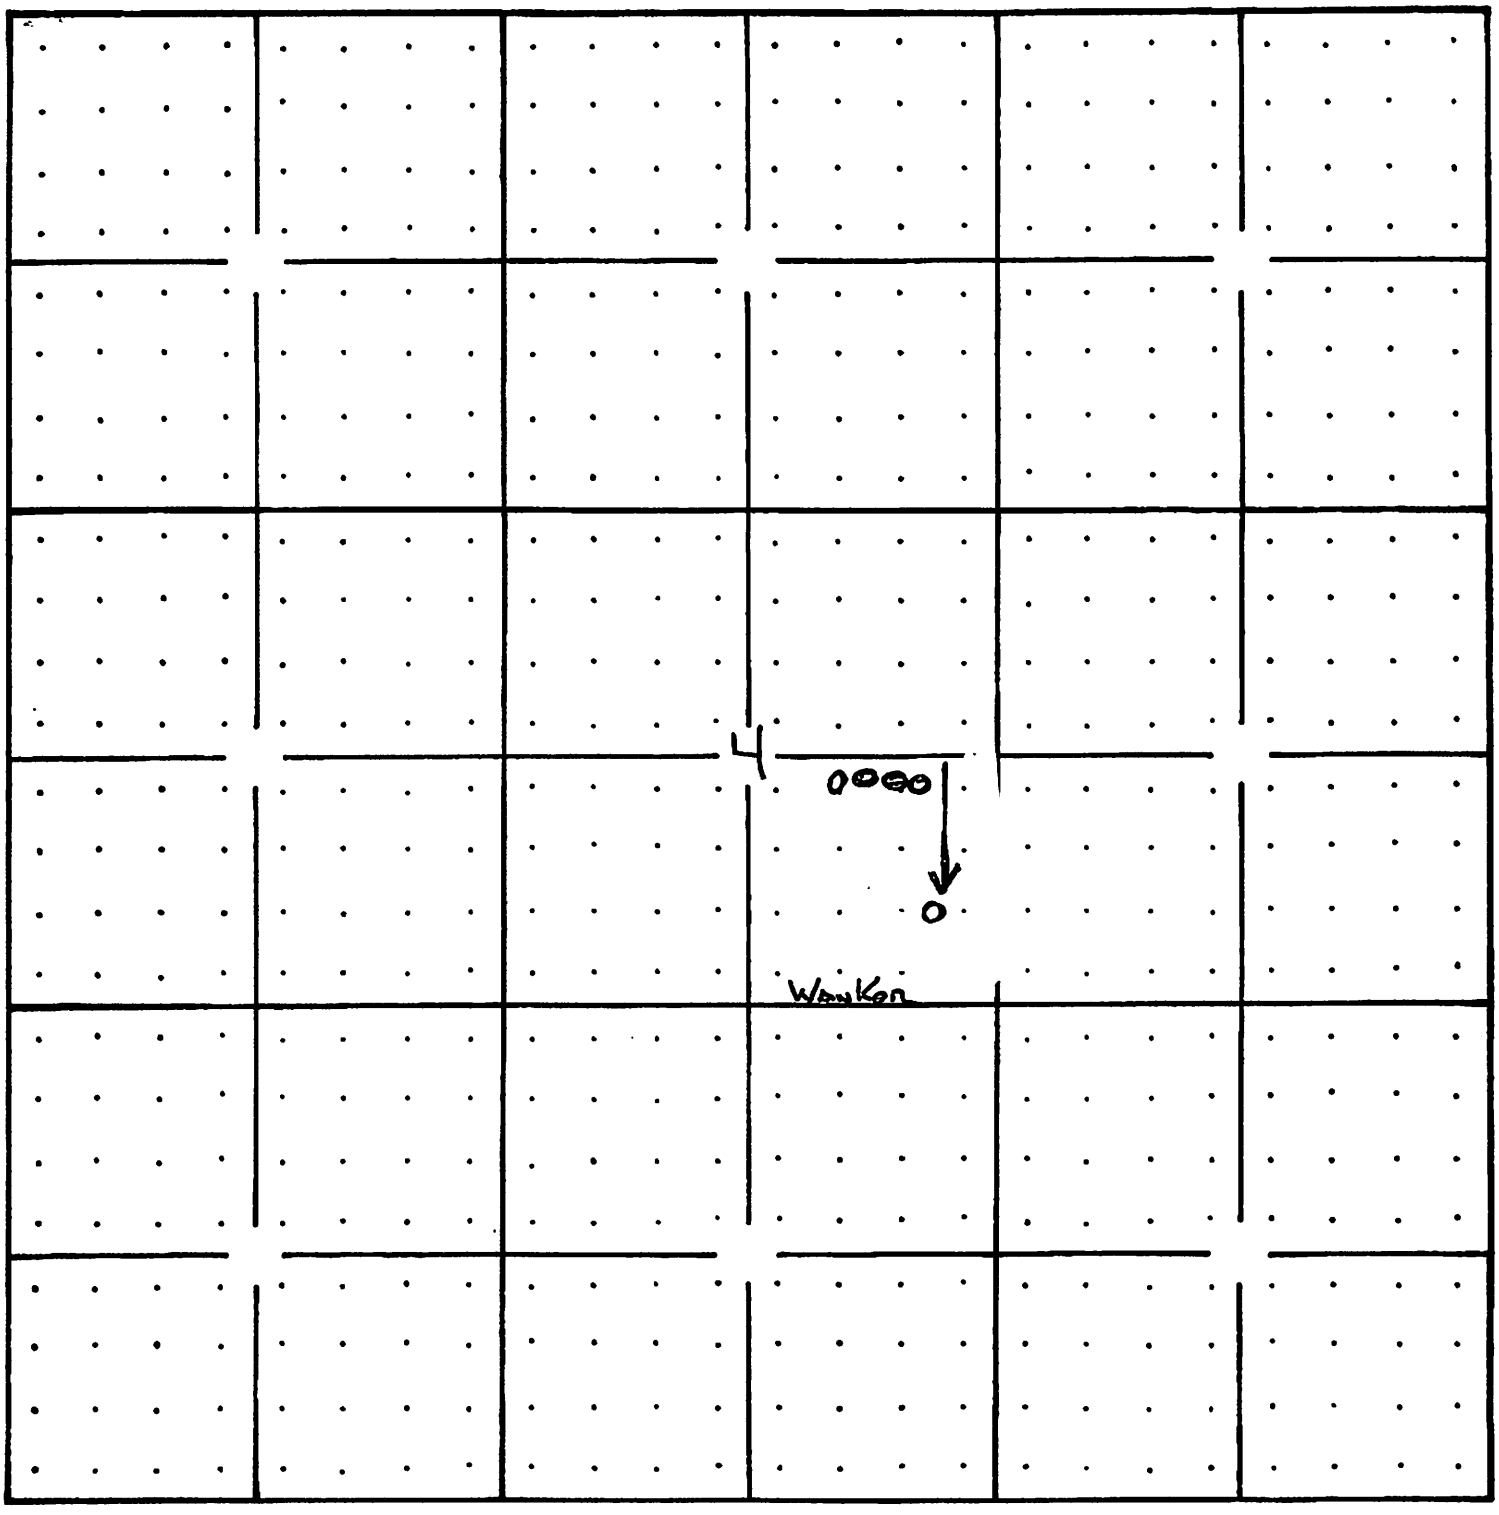

Prospect _____. Contract No. _____ No. Points _____. Type _____

Twp. _____. Rge. _____. County _____. State _____. Logging _____

Spread: _____----_____ - _____ - 0 - _____ - _____ ----_____. Stations/Cable _____. Shots/Hole _____

Type Recording _____, With 1-12 _____, 13-24 _____. Mix _____. Charge _____

Energy to _____. Anh. _____ ___. Hole Depth _____, or _____ ft in _____. Remarks _____

_____

_____

Date _____ GEOSEARCH, INC. Party No. _____. Assigned by: _____